THIS MAP WAS PREPARED FOR ASSESSMENT PURPOSE ONLY.

SEC.2 T.26S. R.4W. W.M.
DOUGLAS COUNTY

1" = 400'
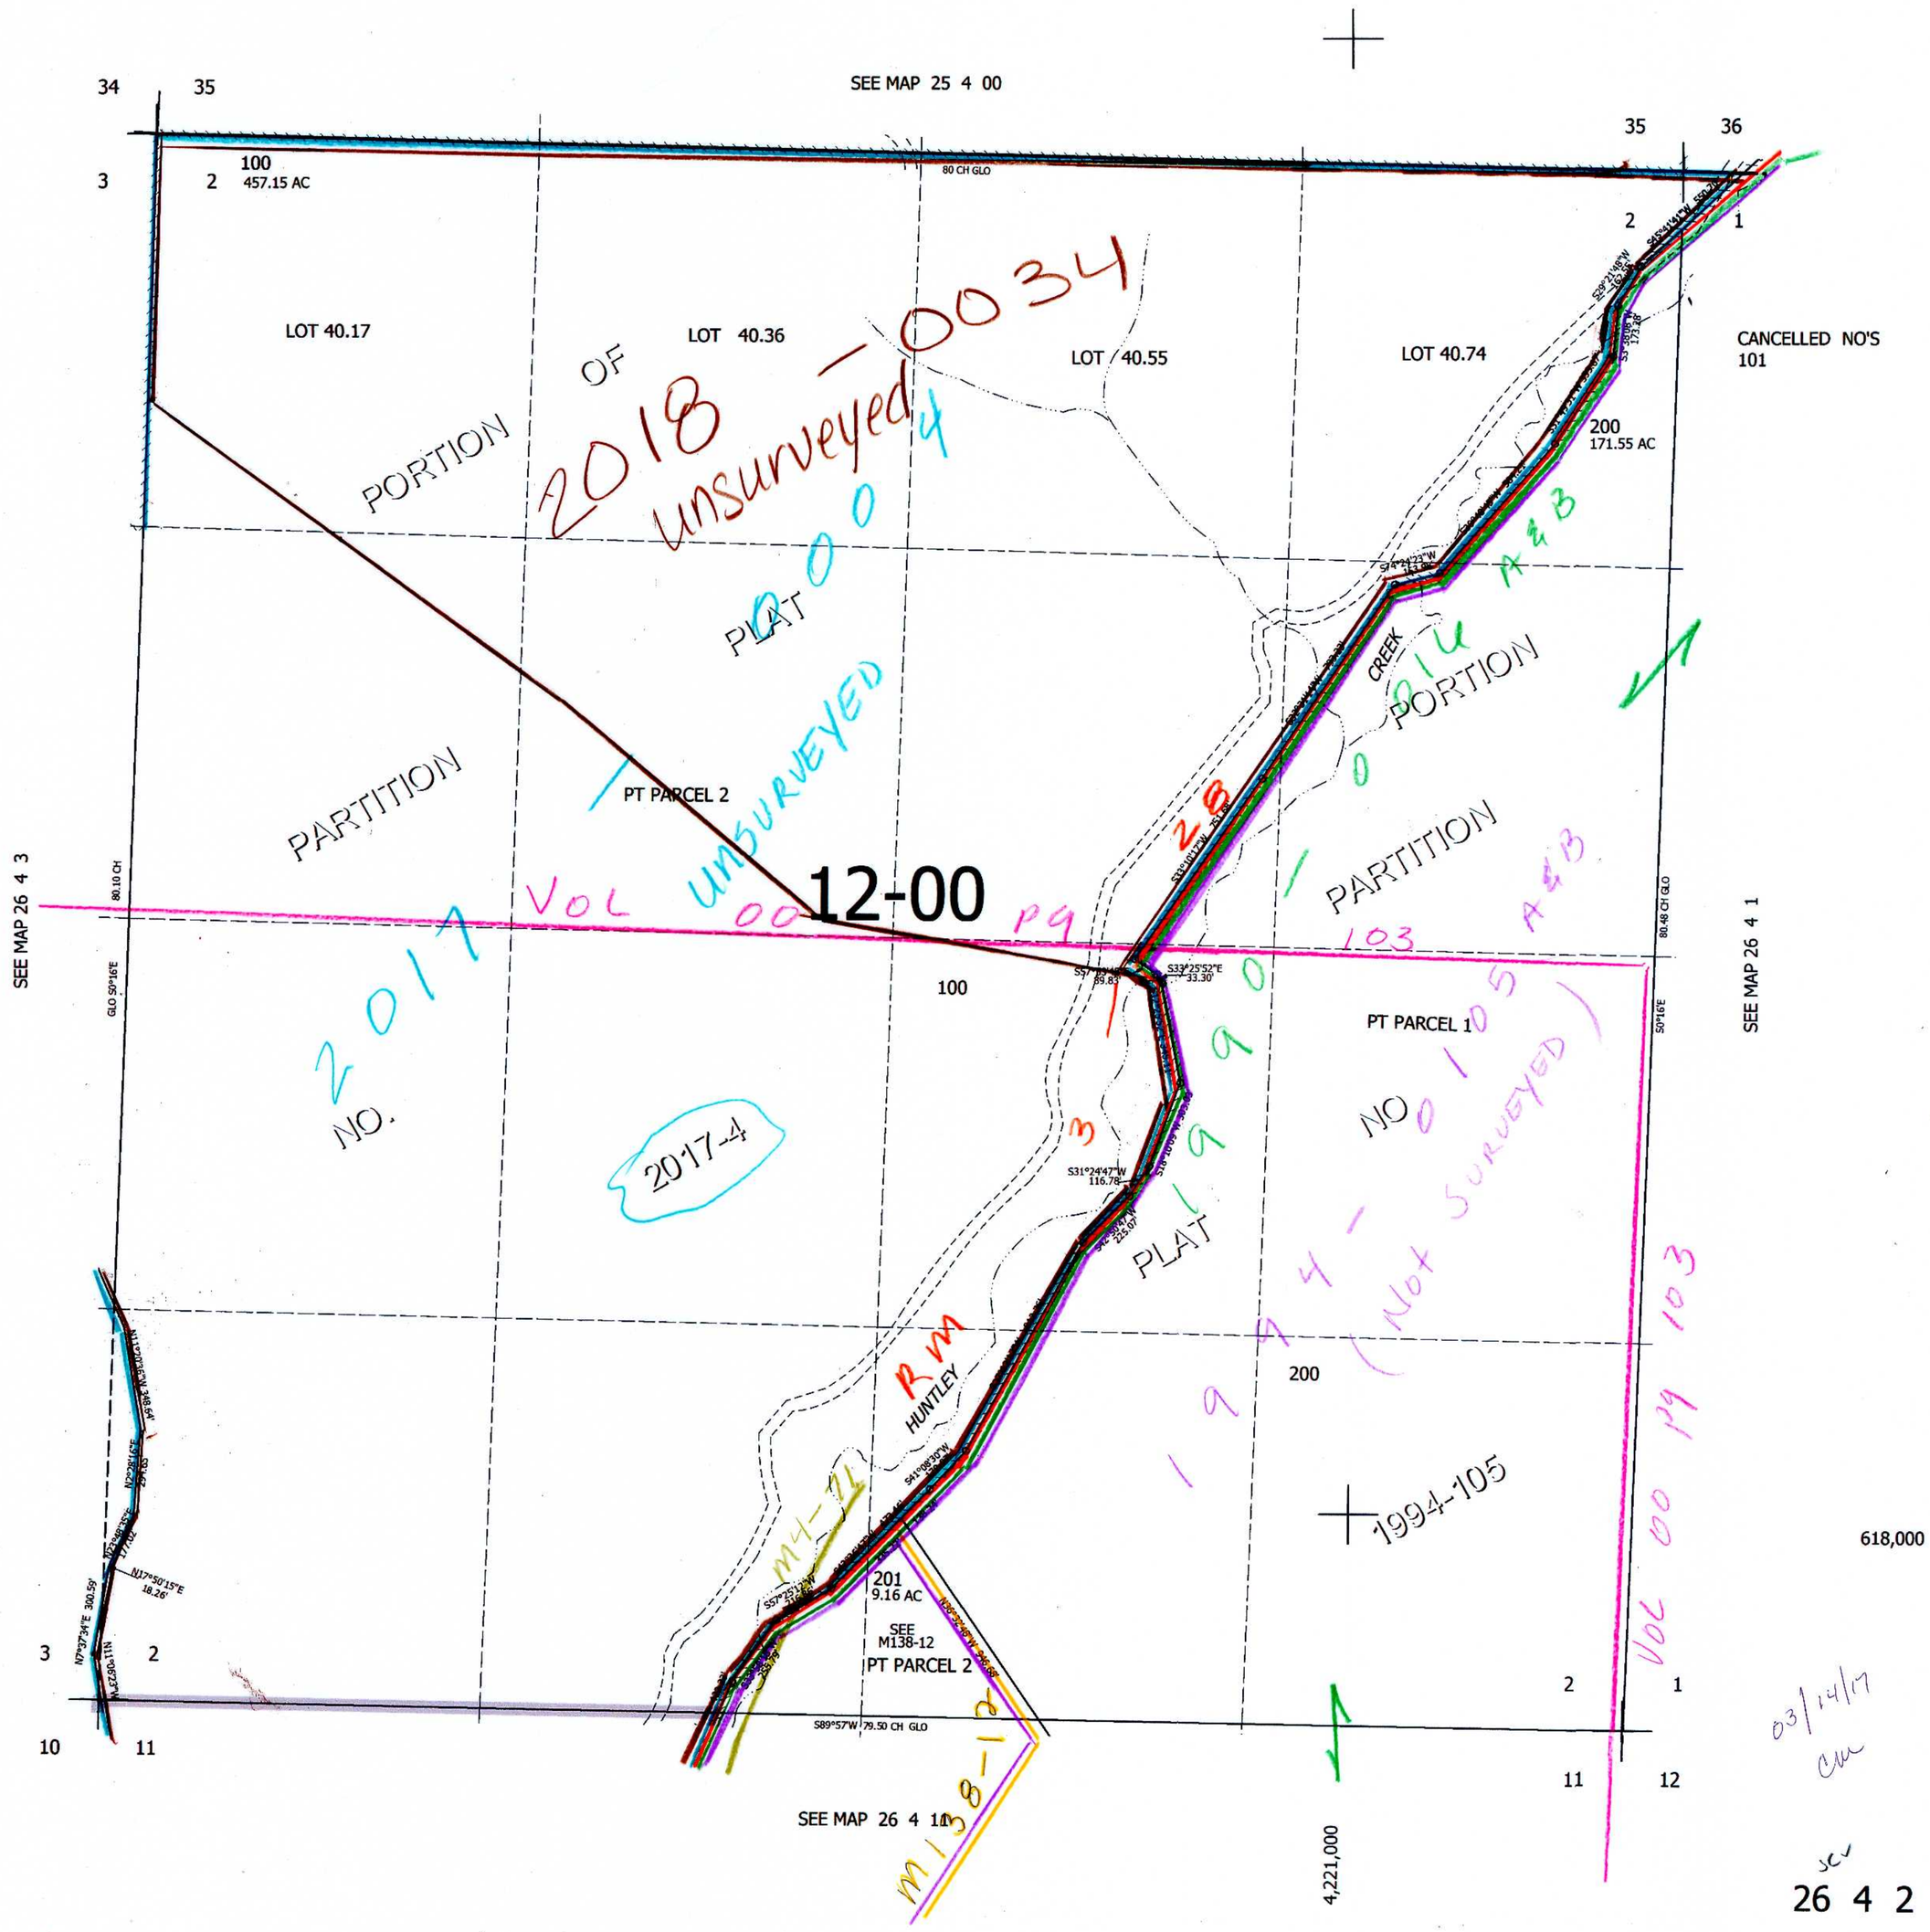
REVISED ON 3-14-17