


THIS MAP WAS PREPARED FOR
ASSESSMENT PURPOSE ONLY.

SECTION 6 T.26S. R. 4W. W.M.
DOUGLAS COUNTY

26 4 6

1" = 400'

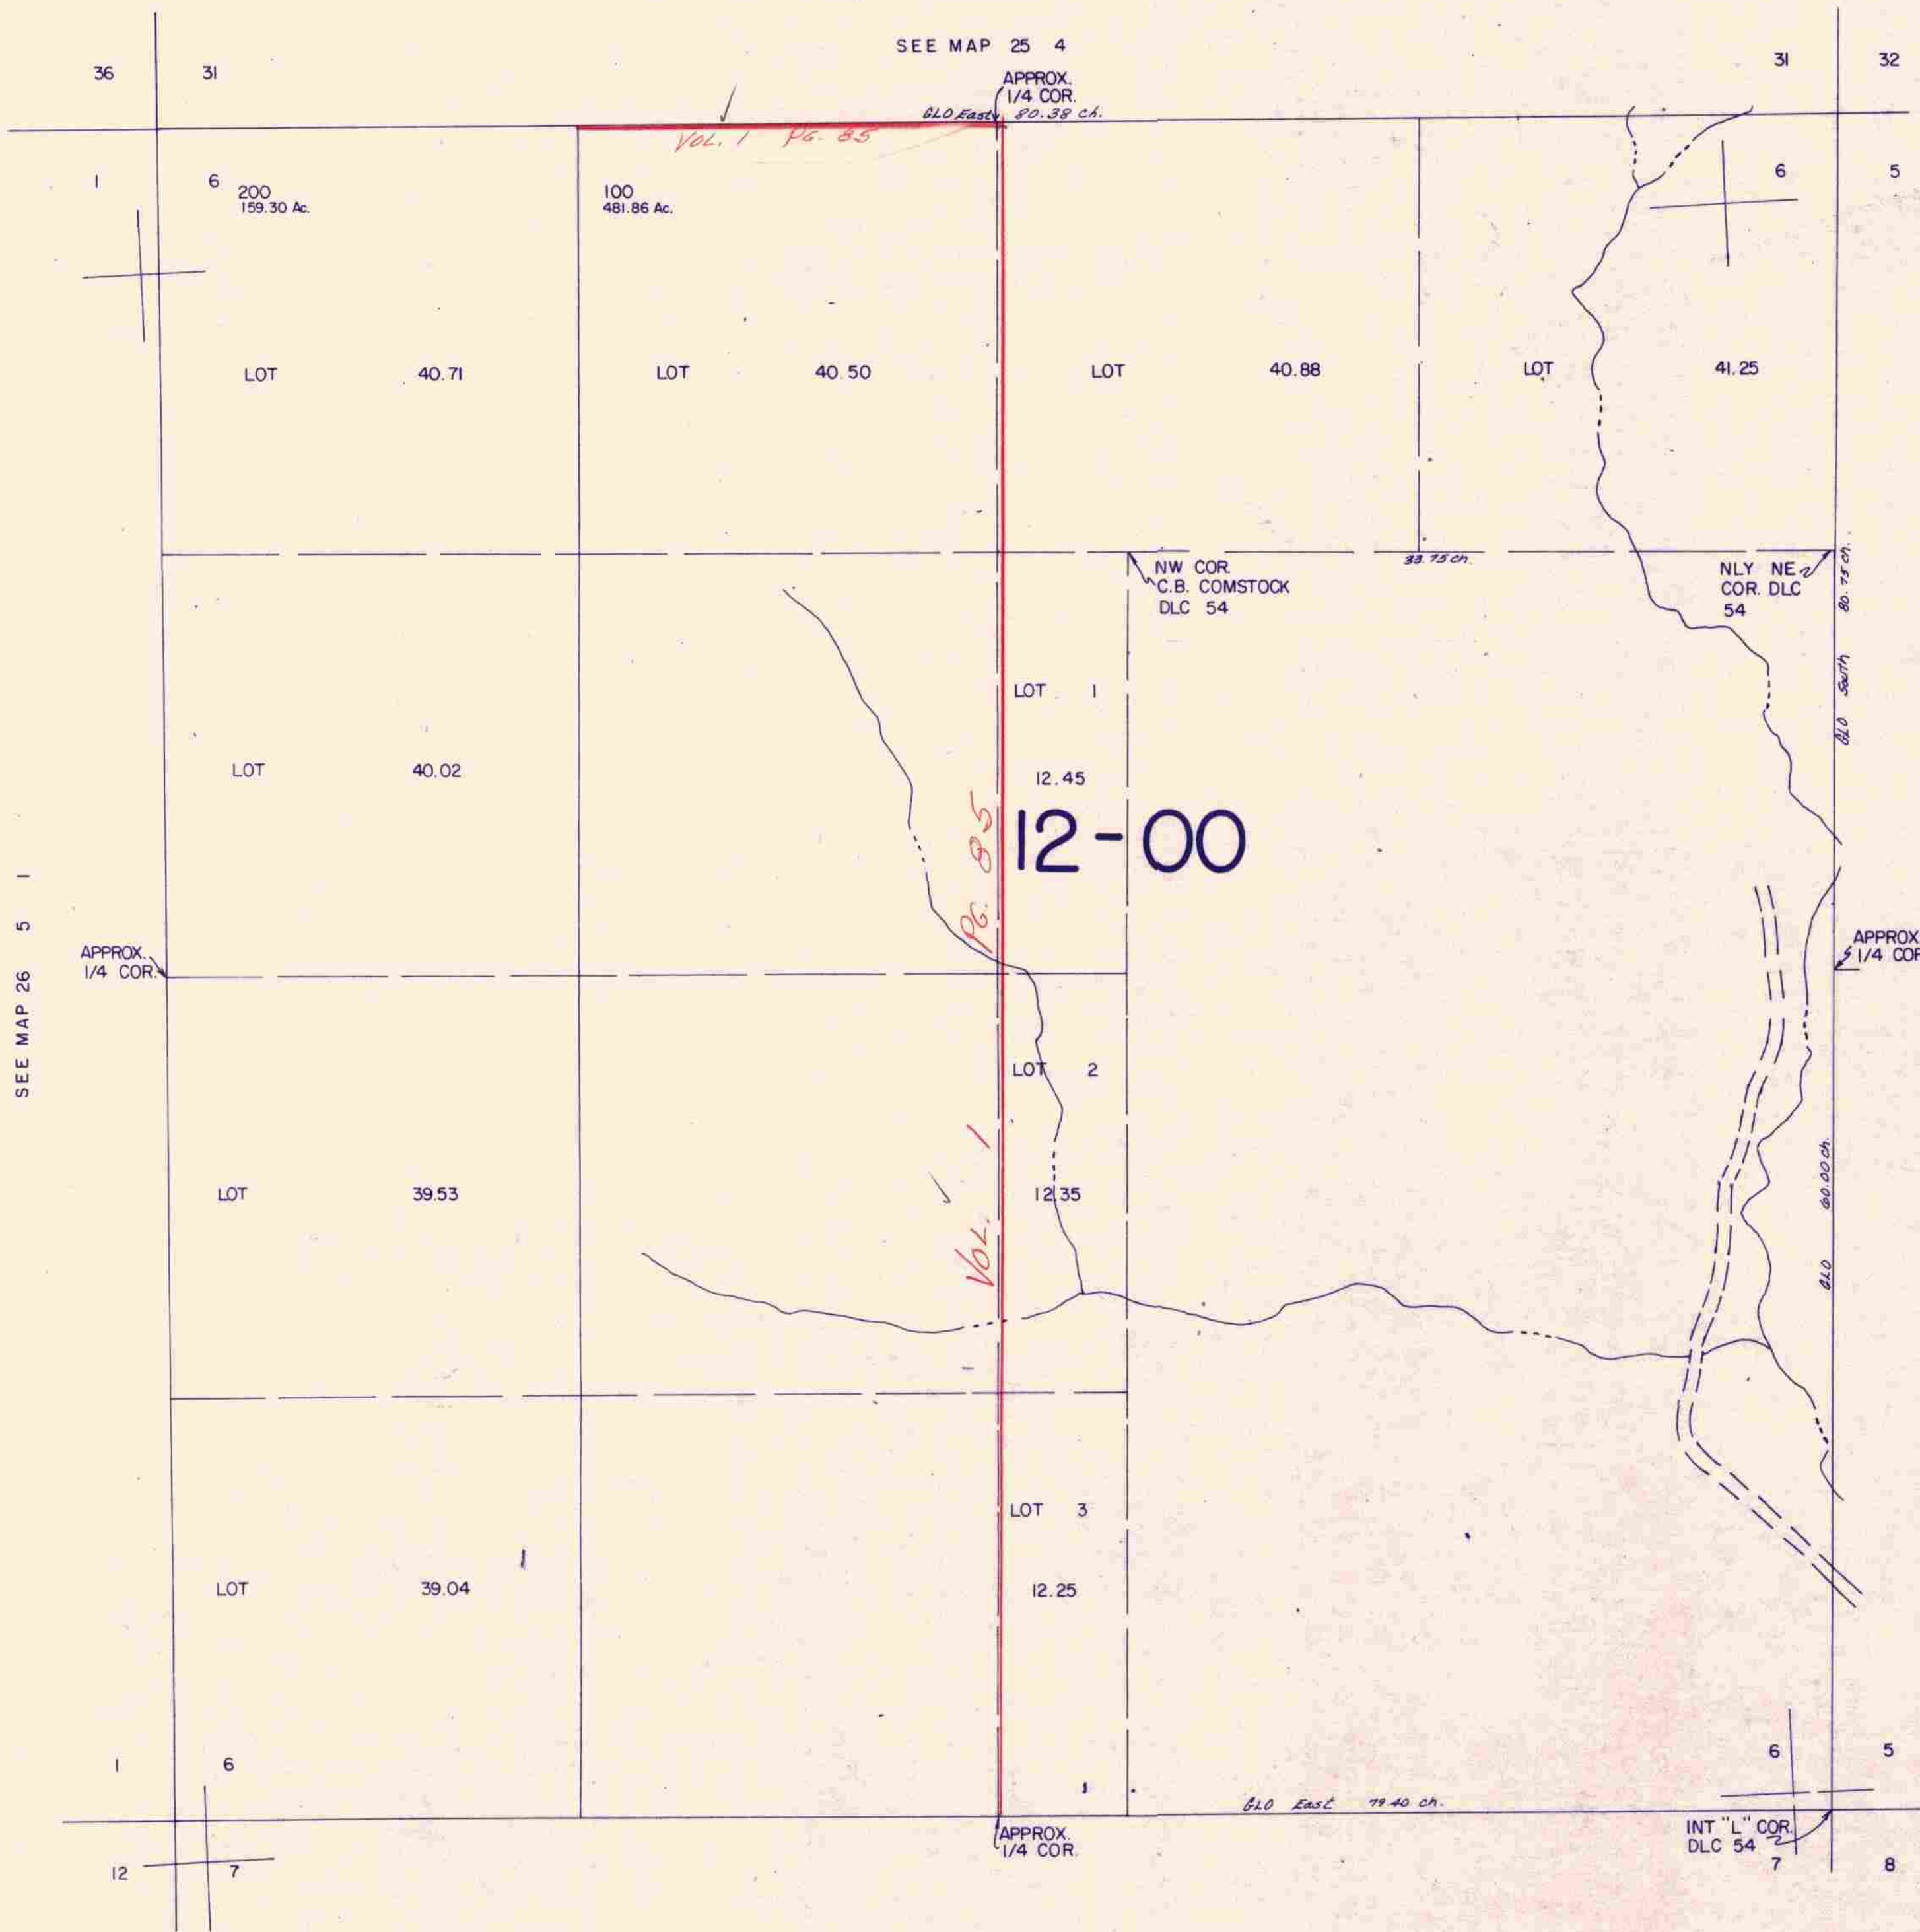

SEE MAP 26 5 1

SEE MAP 26 4 5

SEE MAP 25 4

APPROX.
1/4 COR.
BLO East 80.38 ch.

VOL. 1 PG. 85

200
159.30 Ac.

100
481.86 Ac.

LOT 40.71

LOT 40.50

LOT 40.88

LOT 41.25

LOT 40.02

LOT 1

12.45

LOT 2

12.35

LOT 3

12.25

LOT 39.53

LOT 39.04

NW COR.
C.B. COMSTOCK
DLC 54

NLY NE
COR. DLC
54

APPROX.
1/4 COR.

APPROX.
1/4 COR.

BLO East 79.40 ch.

APPROX.
1/4 COR.

INT "L" COR.
DLC 54

12

1,275,000

SEE MAP 26 4 7

618,000

26 4 6

12-00