THIS MAP WAS PREPARED FOR ASSESSMENT PURPOSE ONLY.

SEC.14 T.26S. R.4W. W.M.
DOUGLAS COUNTY

REVISED ON 1-4-18

26 4 14 & INDEX

1" = 400'

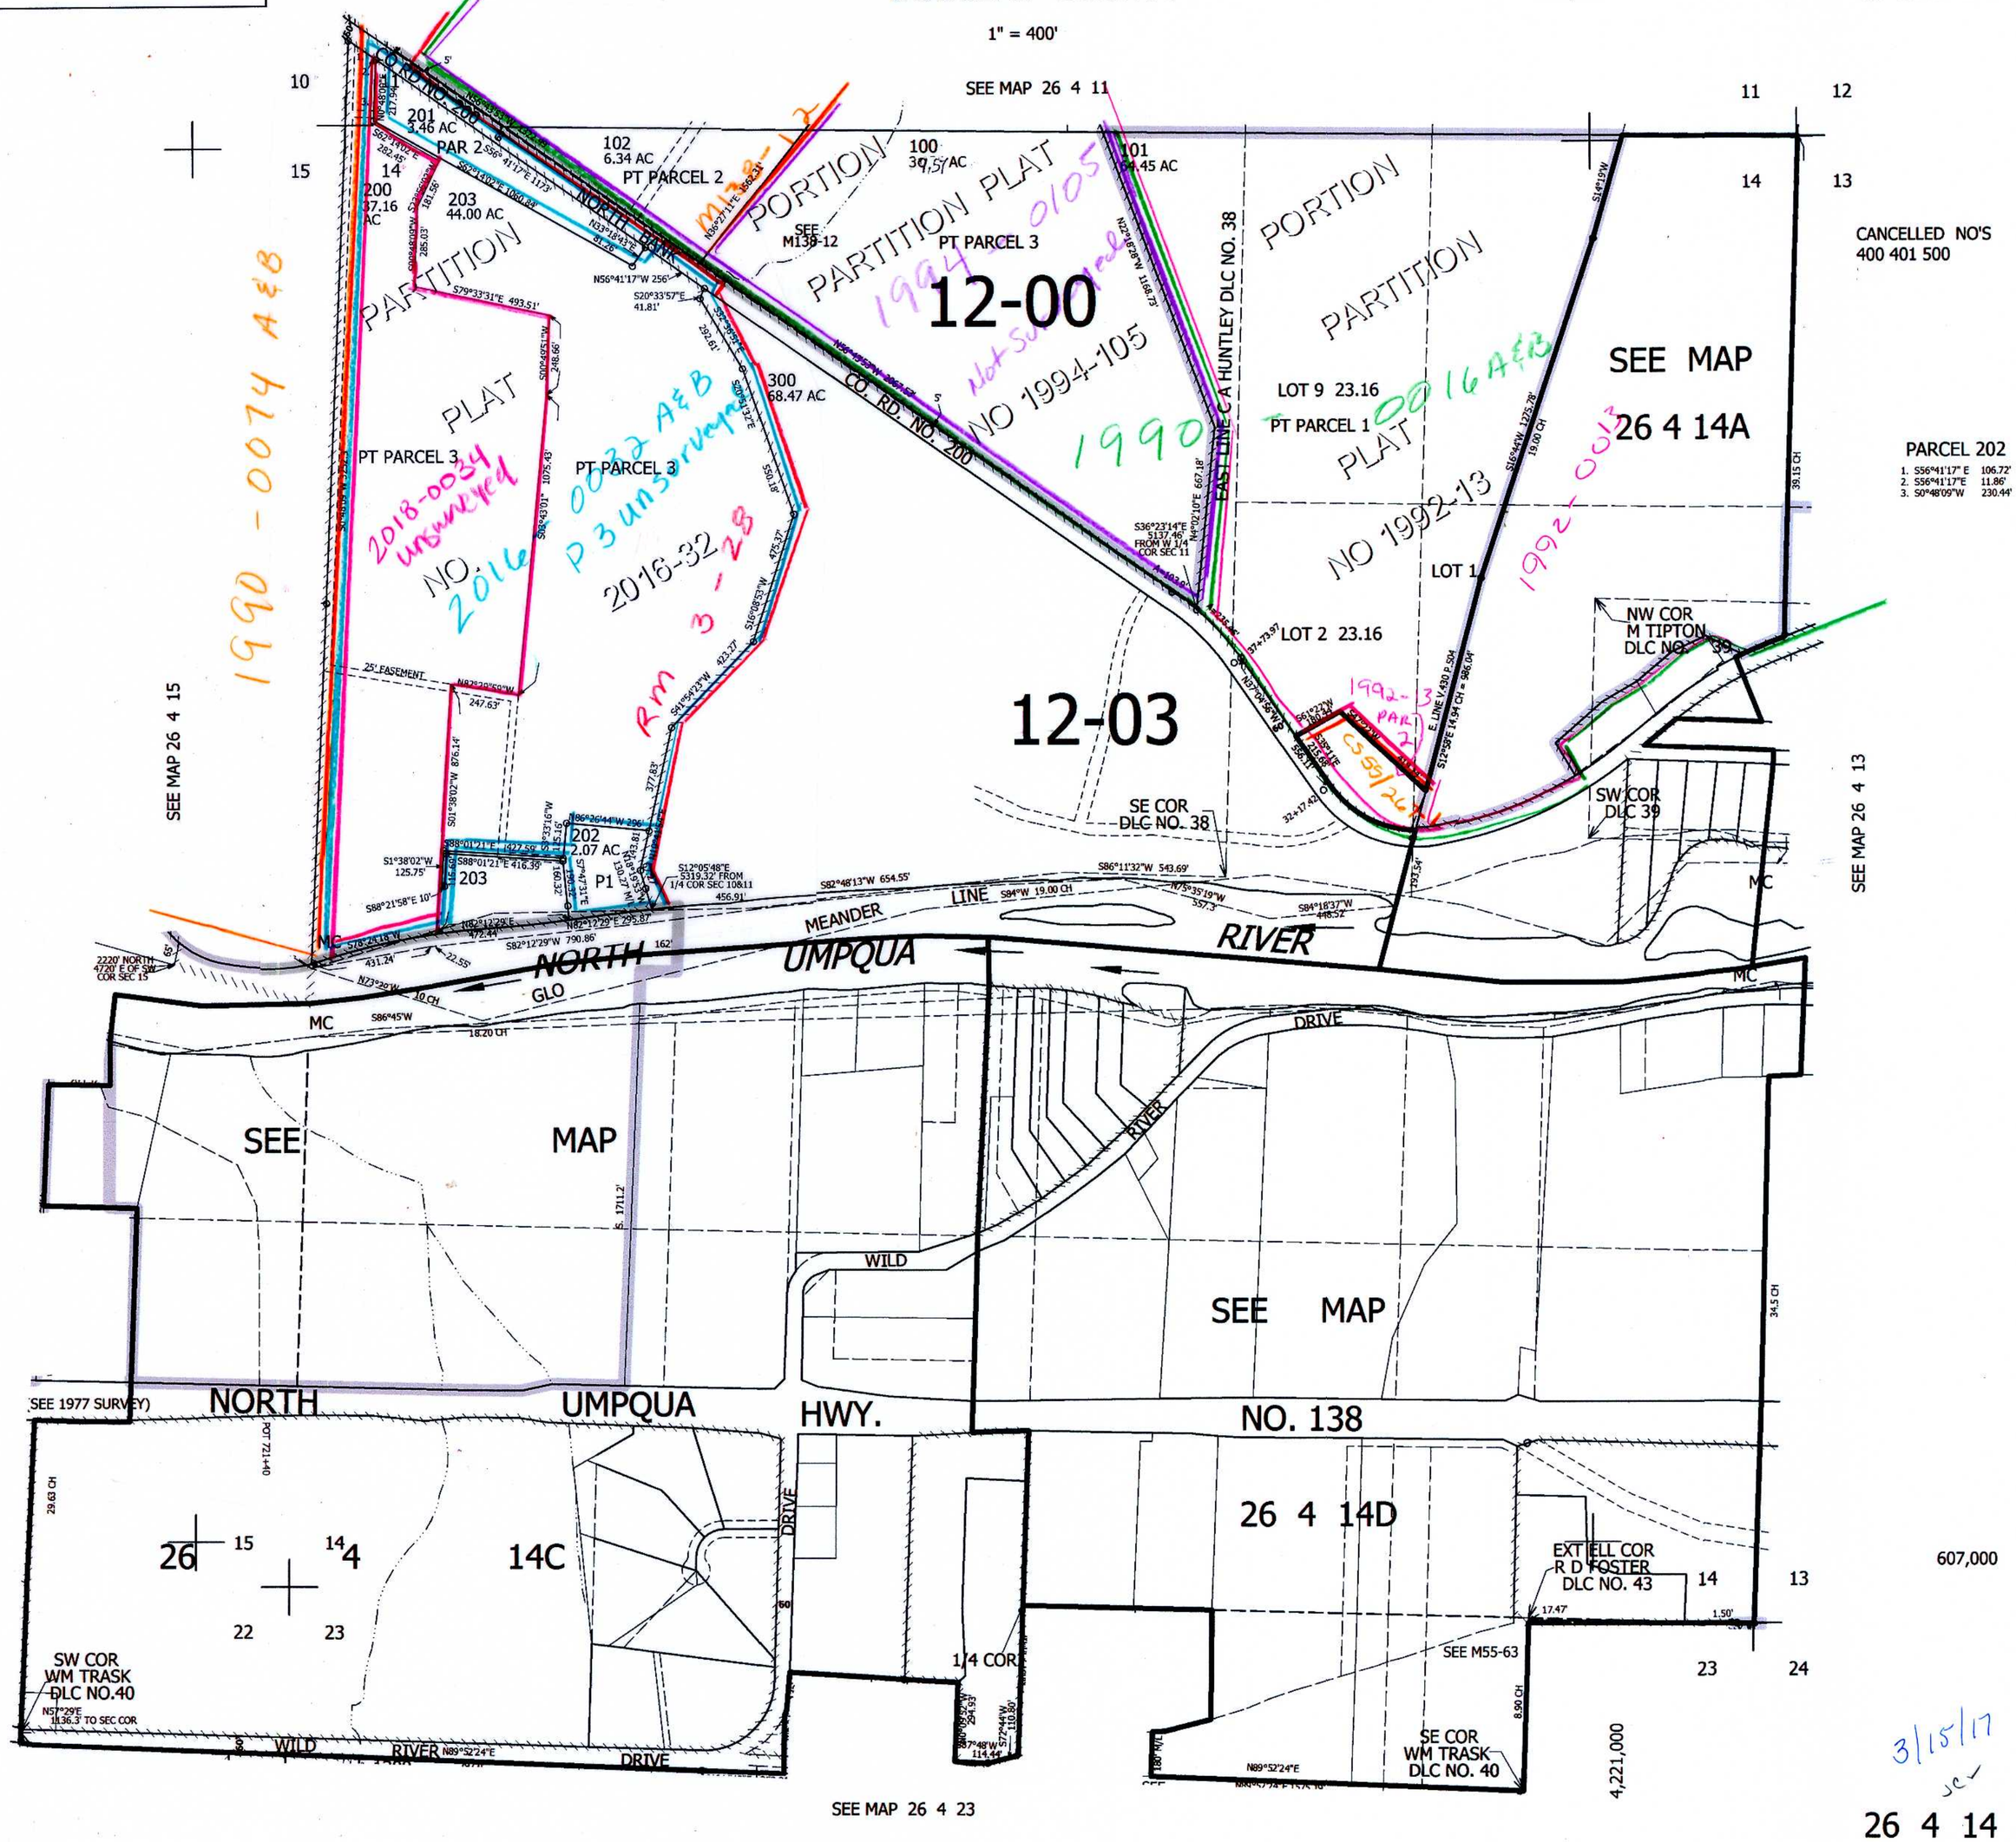

3/15/17 JC

26 4 14 & INDEX