


THIS MAP WAS PREPARED FOR ASSESSMENT PURPOSE ONLY.

SECTION 18 T.26S. R.4W. W.M.
DOUGLAS COUNTY

REVISED ON
4-4-91

26 4 18
& INDEX

CANCELLED NO'S
100 MI

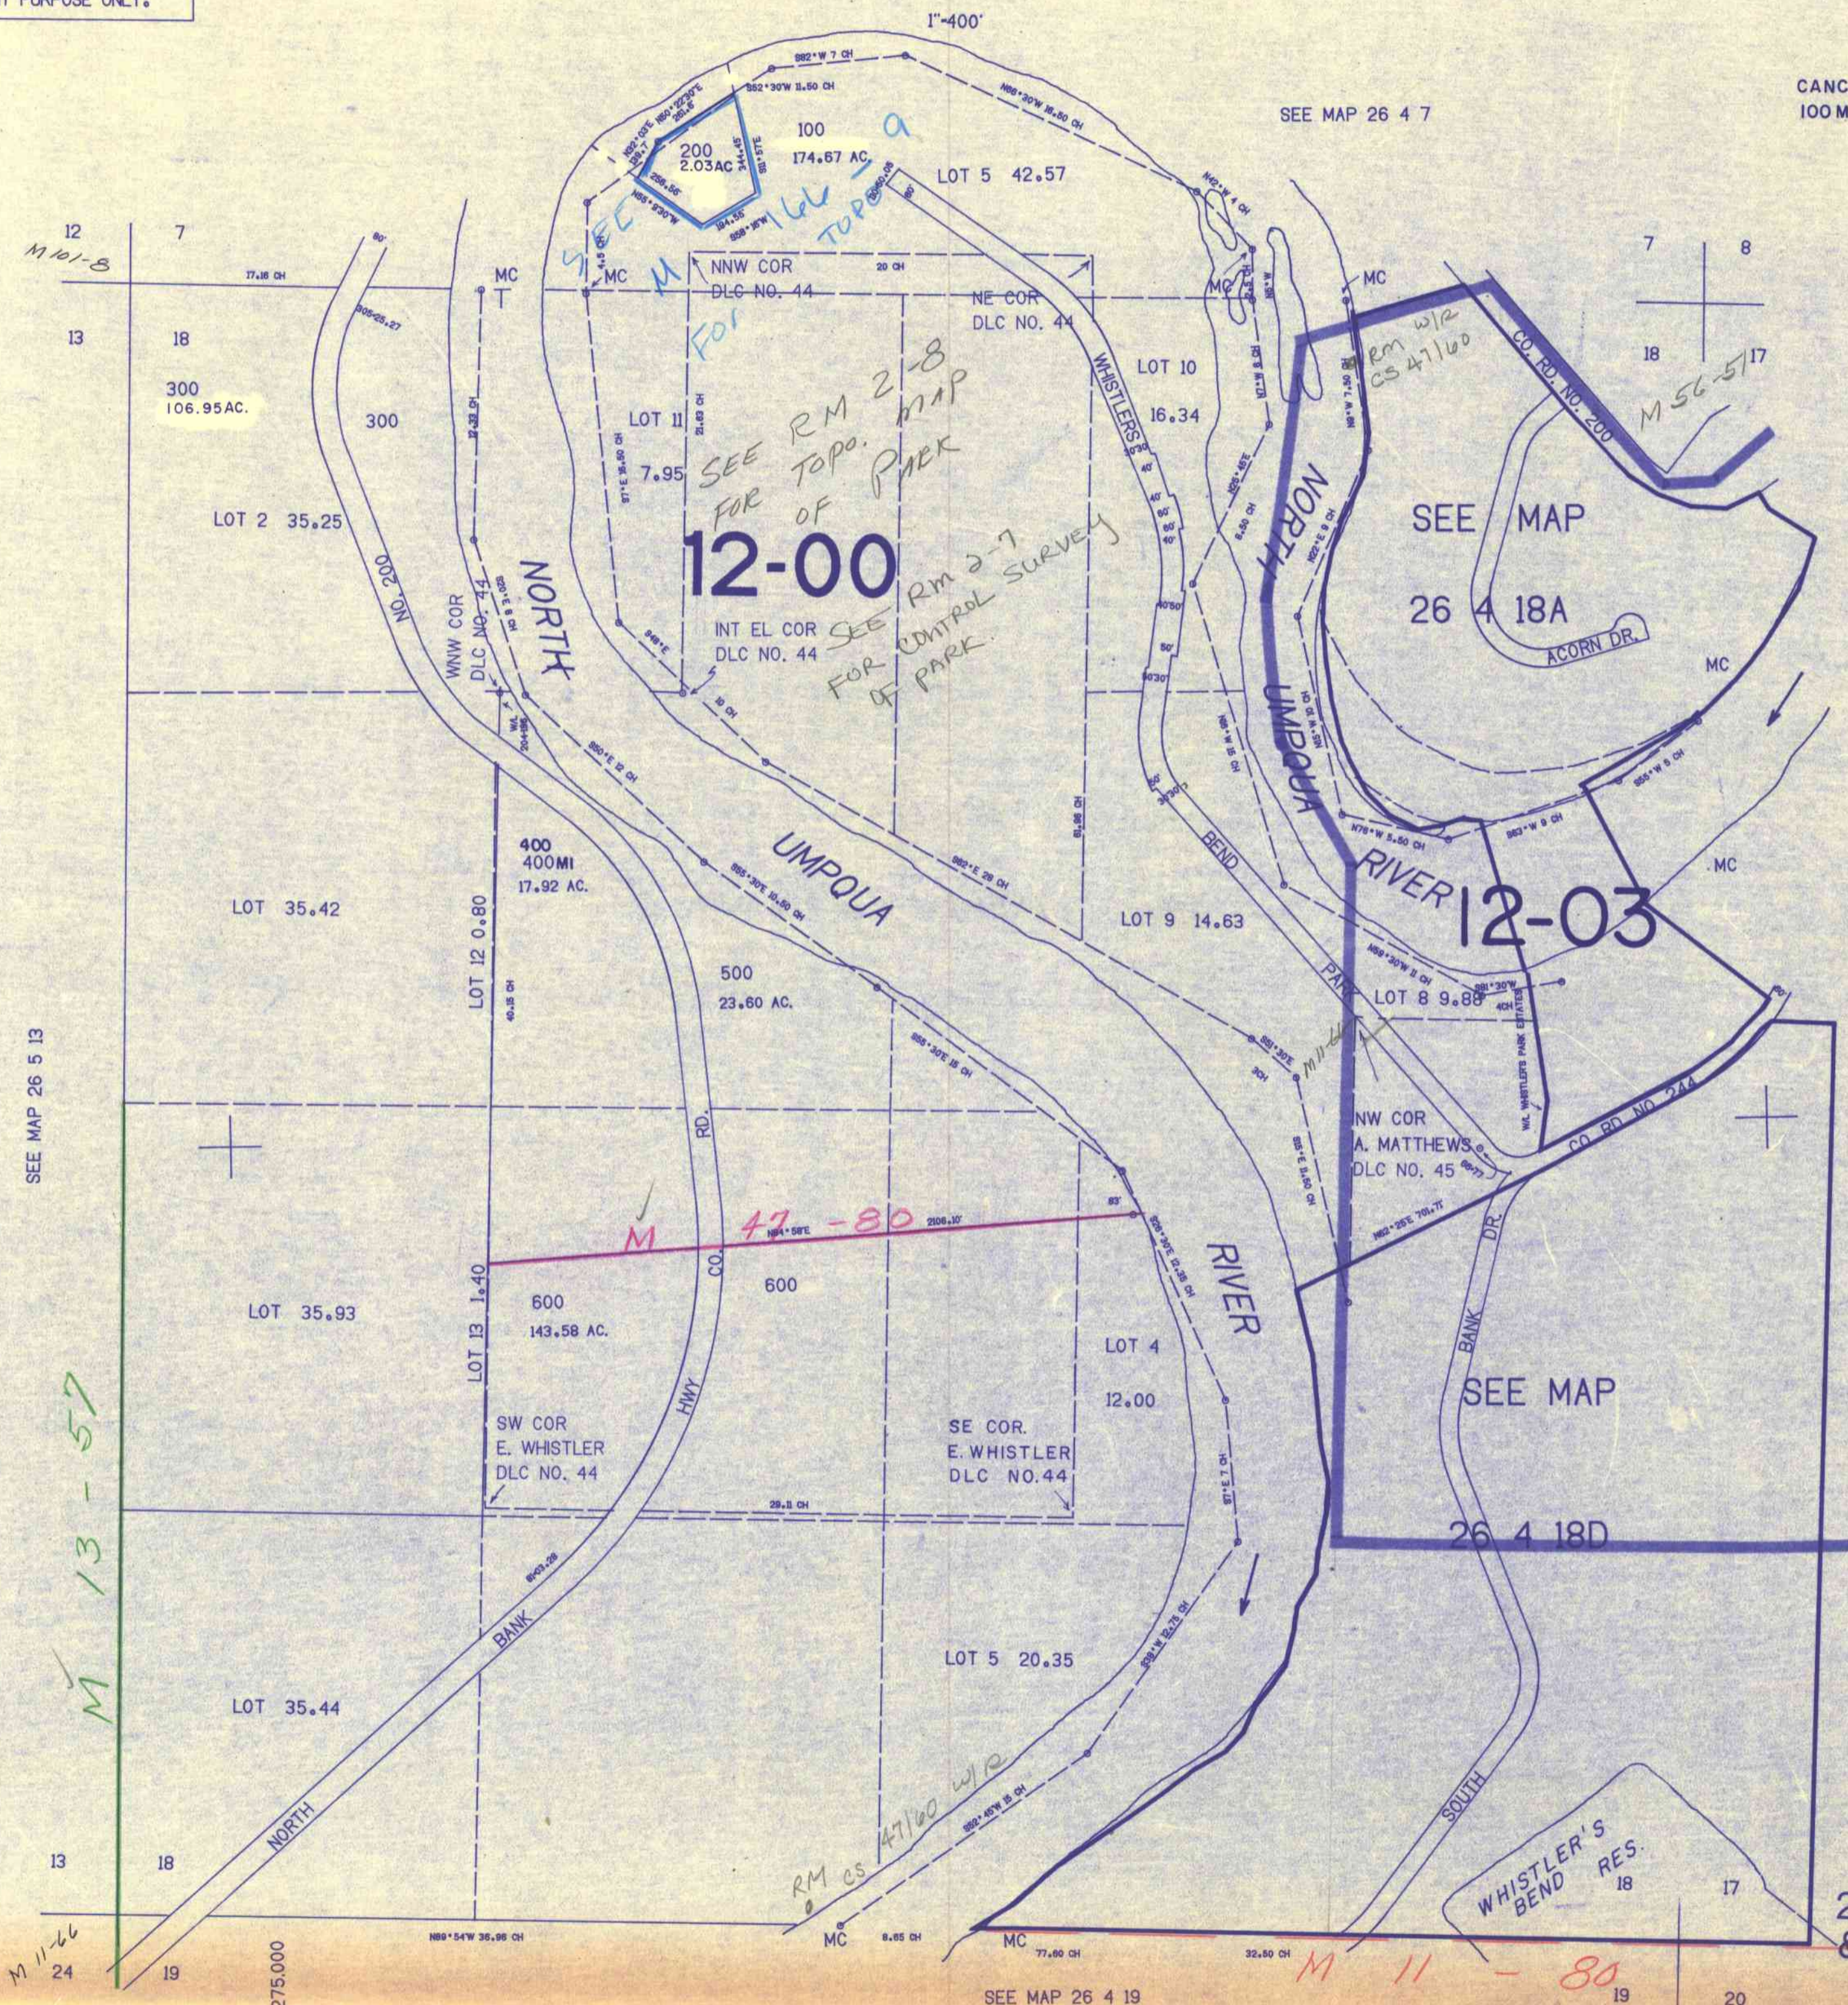

SEE MAP 26 5 13

M 13-57

M 11-80

12-00

12-03

M 47-80

26 4 18D

26 4 18
& INDEX

610,000

SEE MAP 26 4 19

SEE MAP 26 4 7

SEE MAP 26 4 17

4/1/91