


SECTION 26 T.26S. R.4W. W.M.
DOUGLAS COUNTY

THIS MAP WAS PREPARED FOR
ASSESSMENT PURPOSE ONLY.

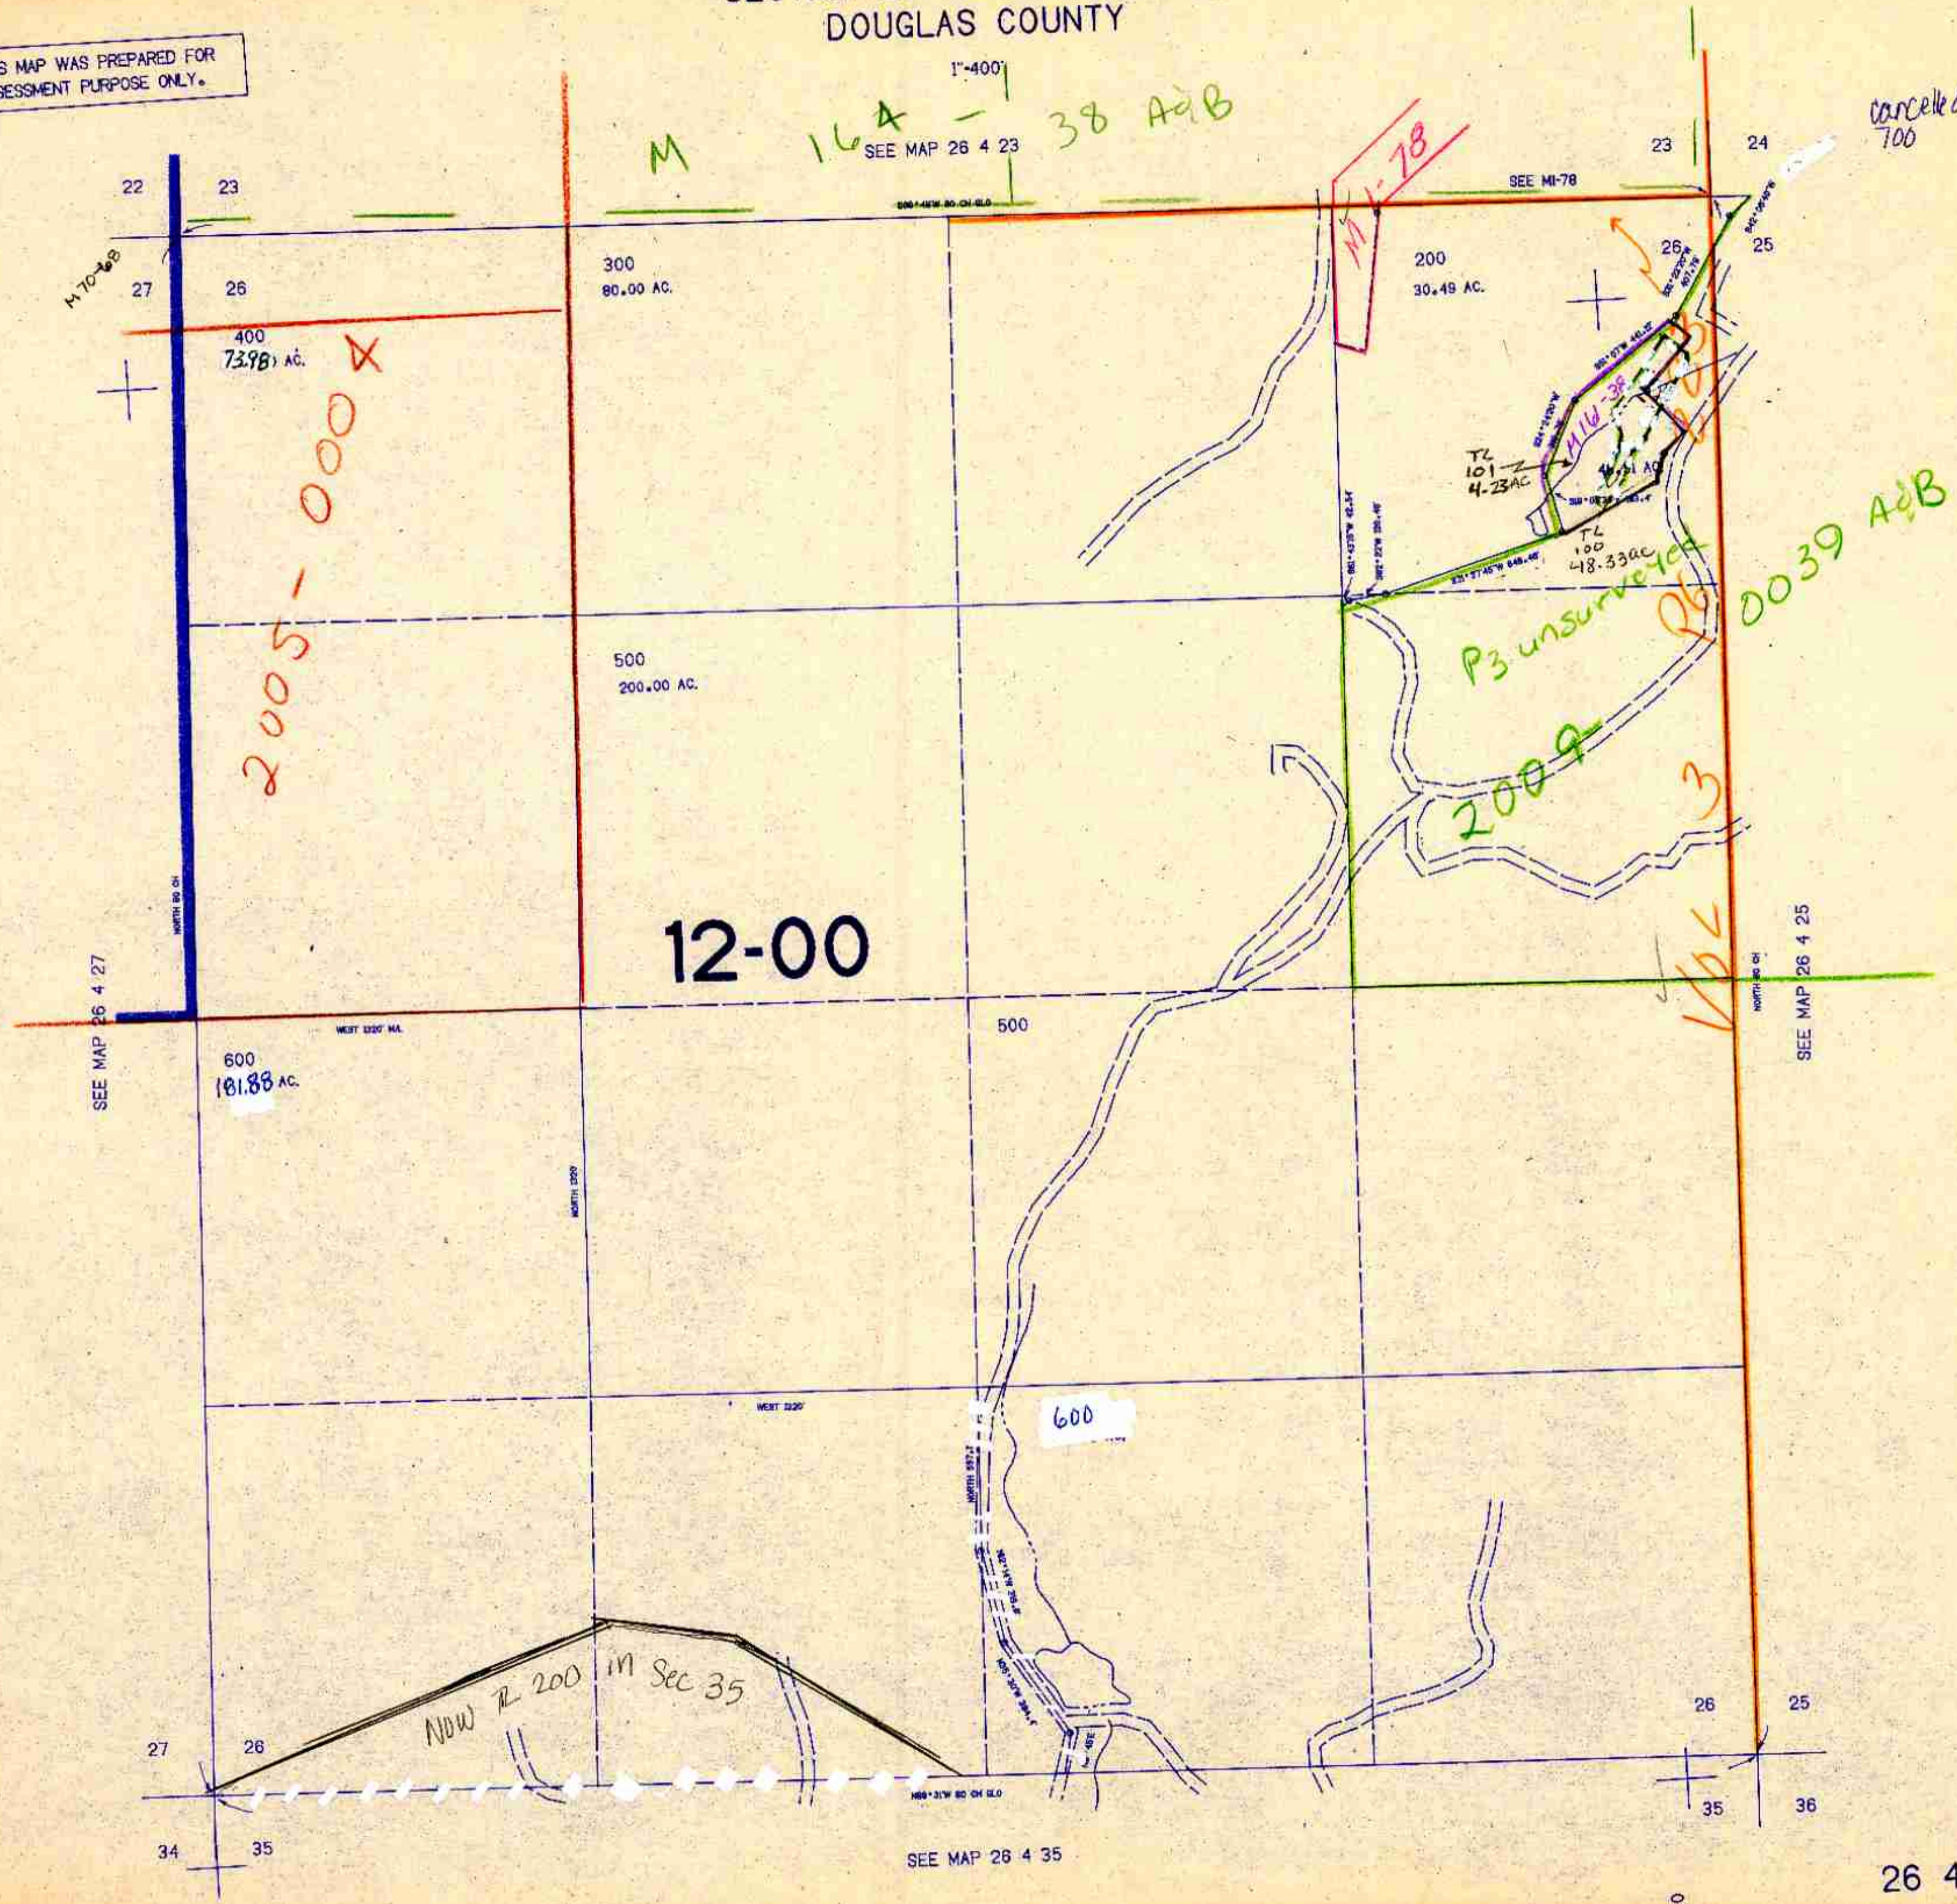

Cancelled:
700

12-00

2005-000 X

MI-78

P3 unsurveyed

0039 A+B

2009
164
3




A/B