THIS MAP WAS PREPARED FOR ASSESSMENT PURPOSE ONLY.

Upper Left:
123°11'36"W 43°16'27"N
4204111E 597338N ft

SEC.33 T.26S. R.04W. W.M.
DOUGLAS COUNTY
1" =400'

Date Exported 2023-06-05

260433

CANCELLED NOS:
100 301 200
400 500

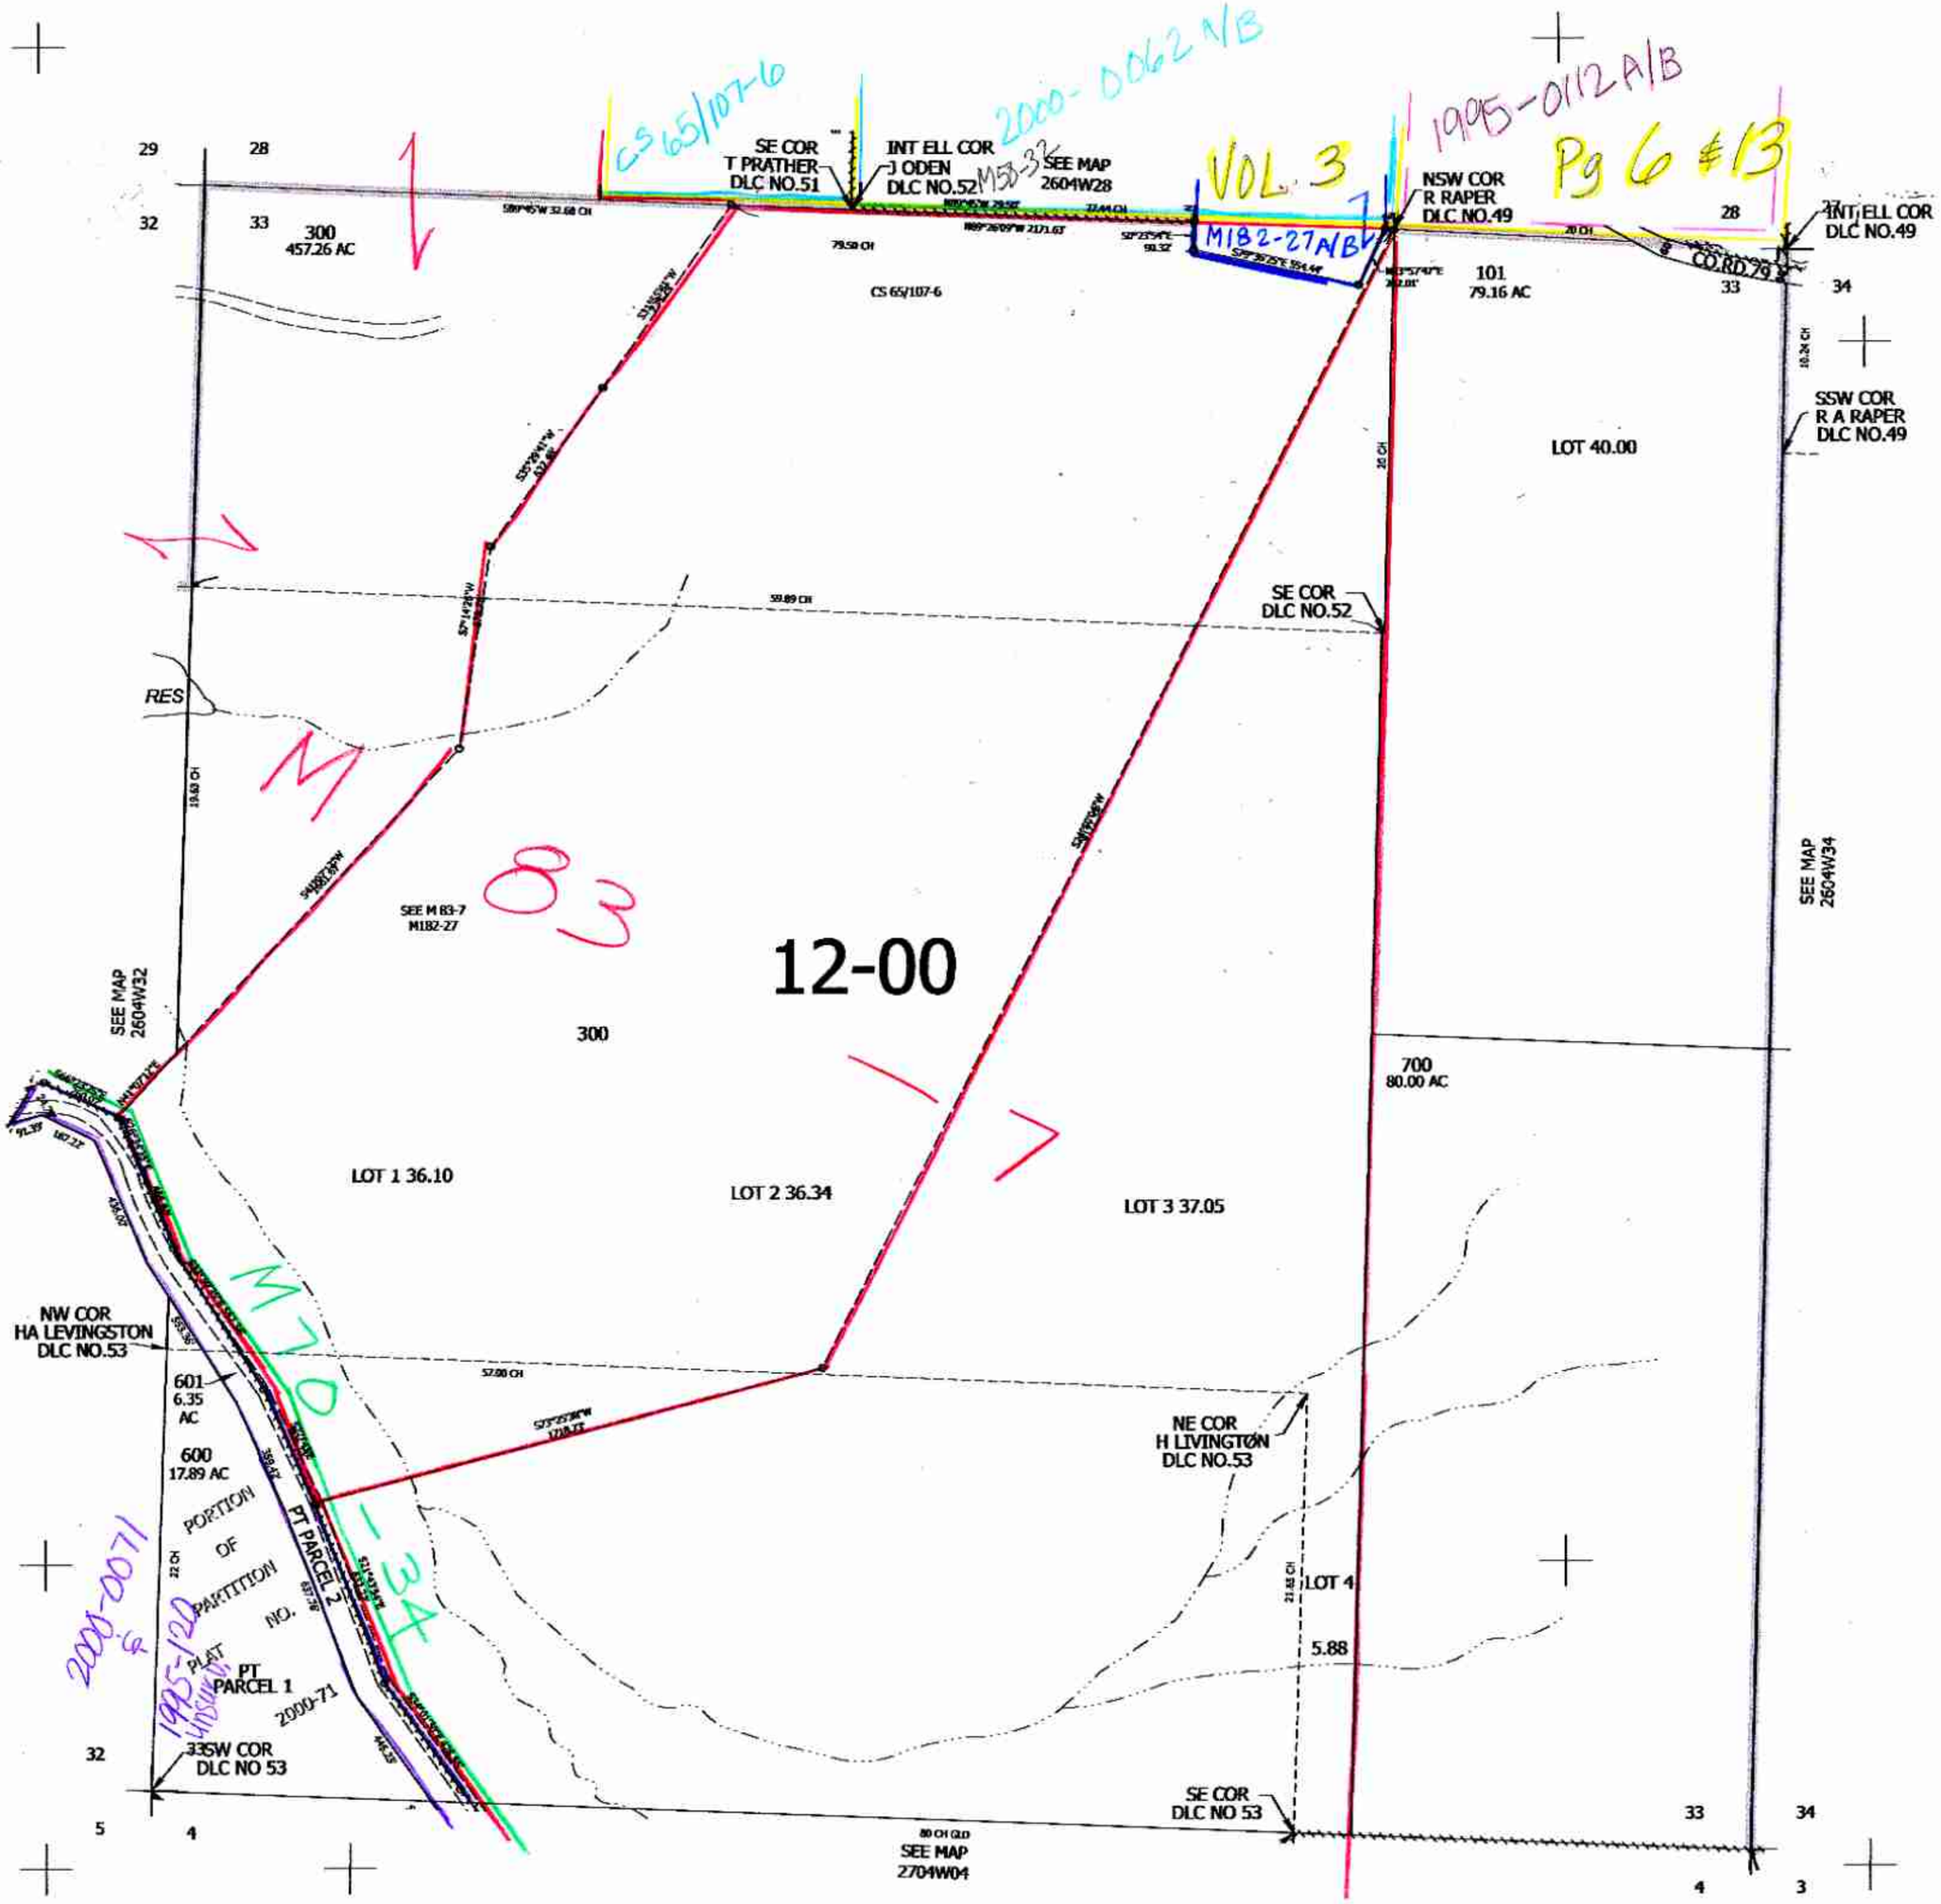

6/2023

260433

Lower Right:
123°9'47"W 43°15'20"N
4211960E 590382N ft