THIS MAP WAS PREPARED FOR ASSESSMENT PURPOSE ONLY.

SEC.34 T.26S. R.4W. W.M.
DOUGLAS COUNTY

1" = 400'

REVISED ON 3-24-08

26 4 34

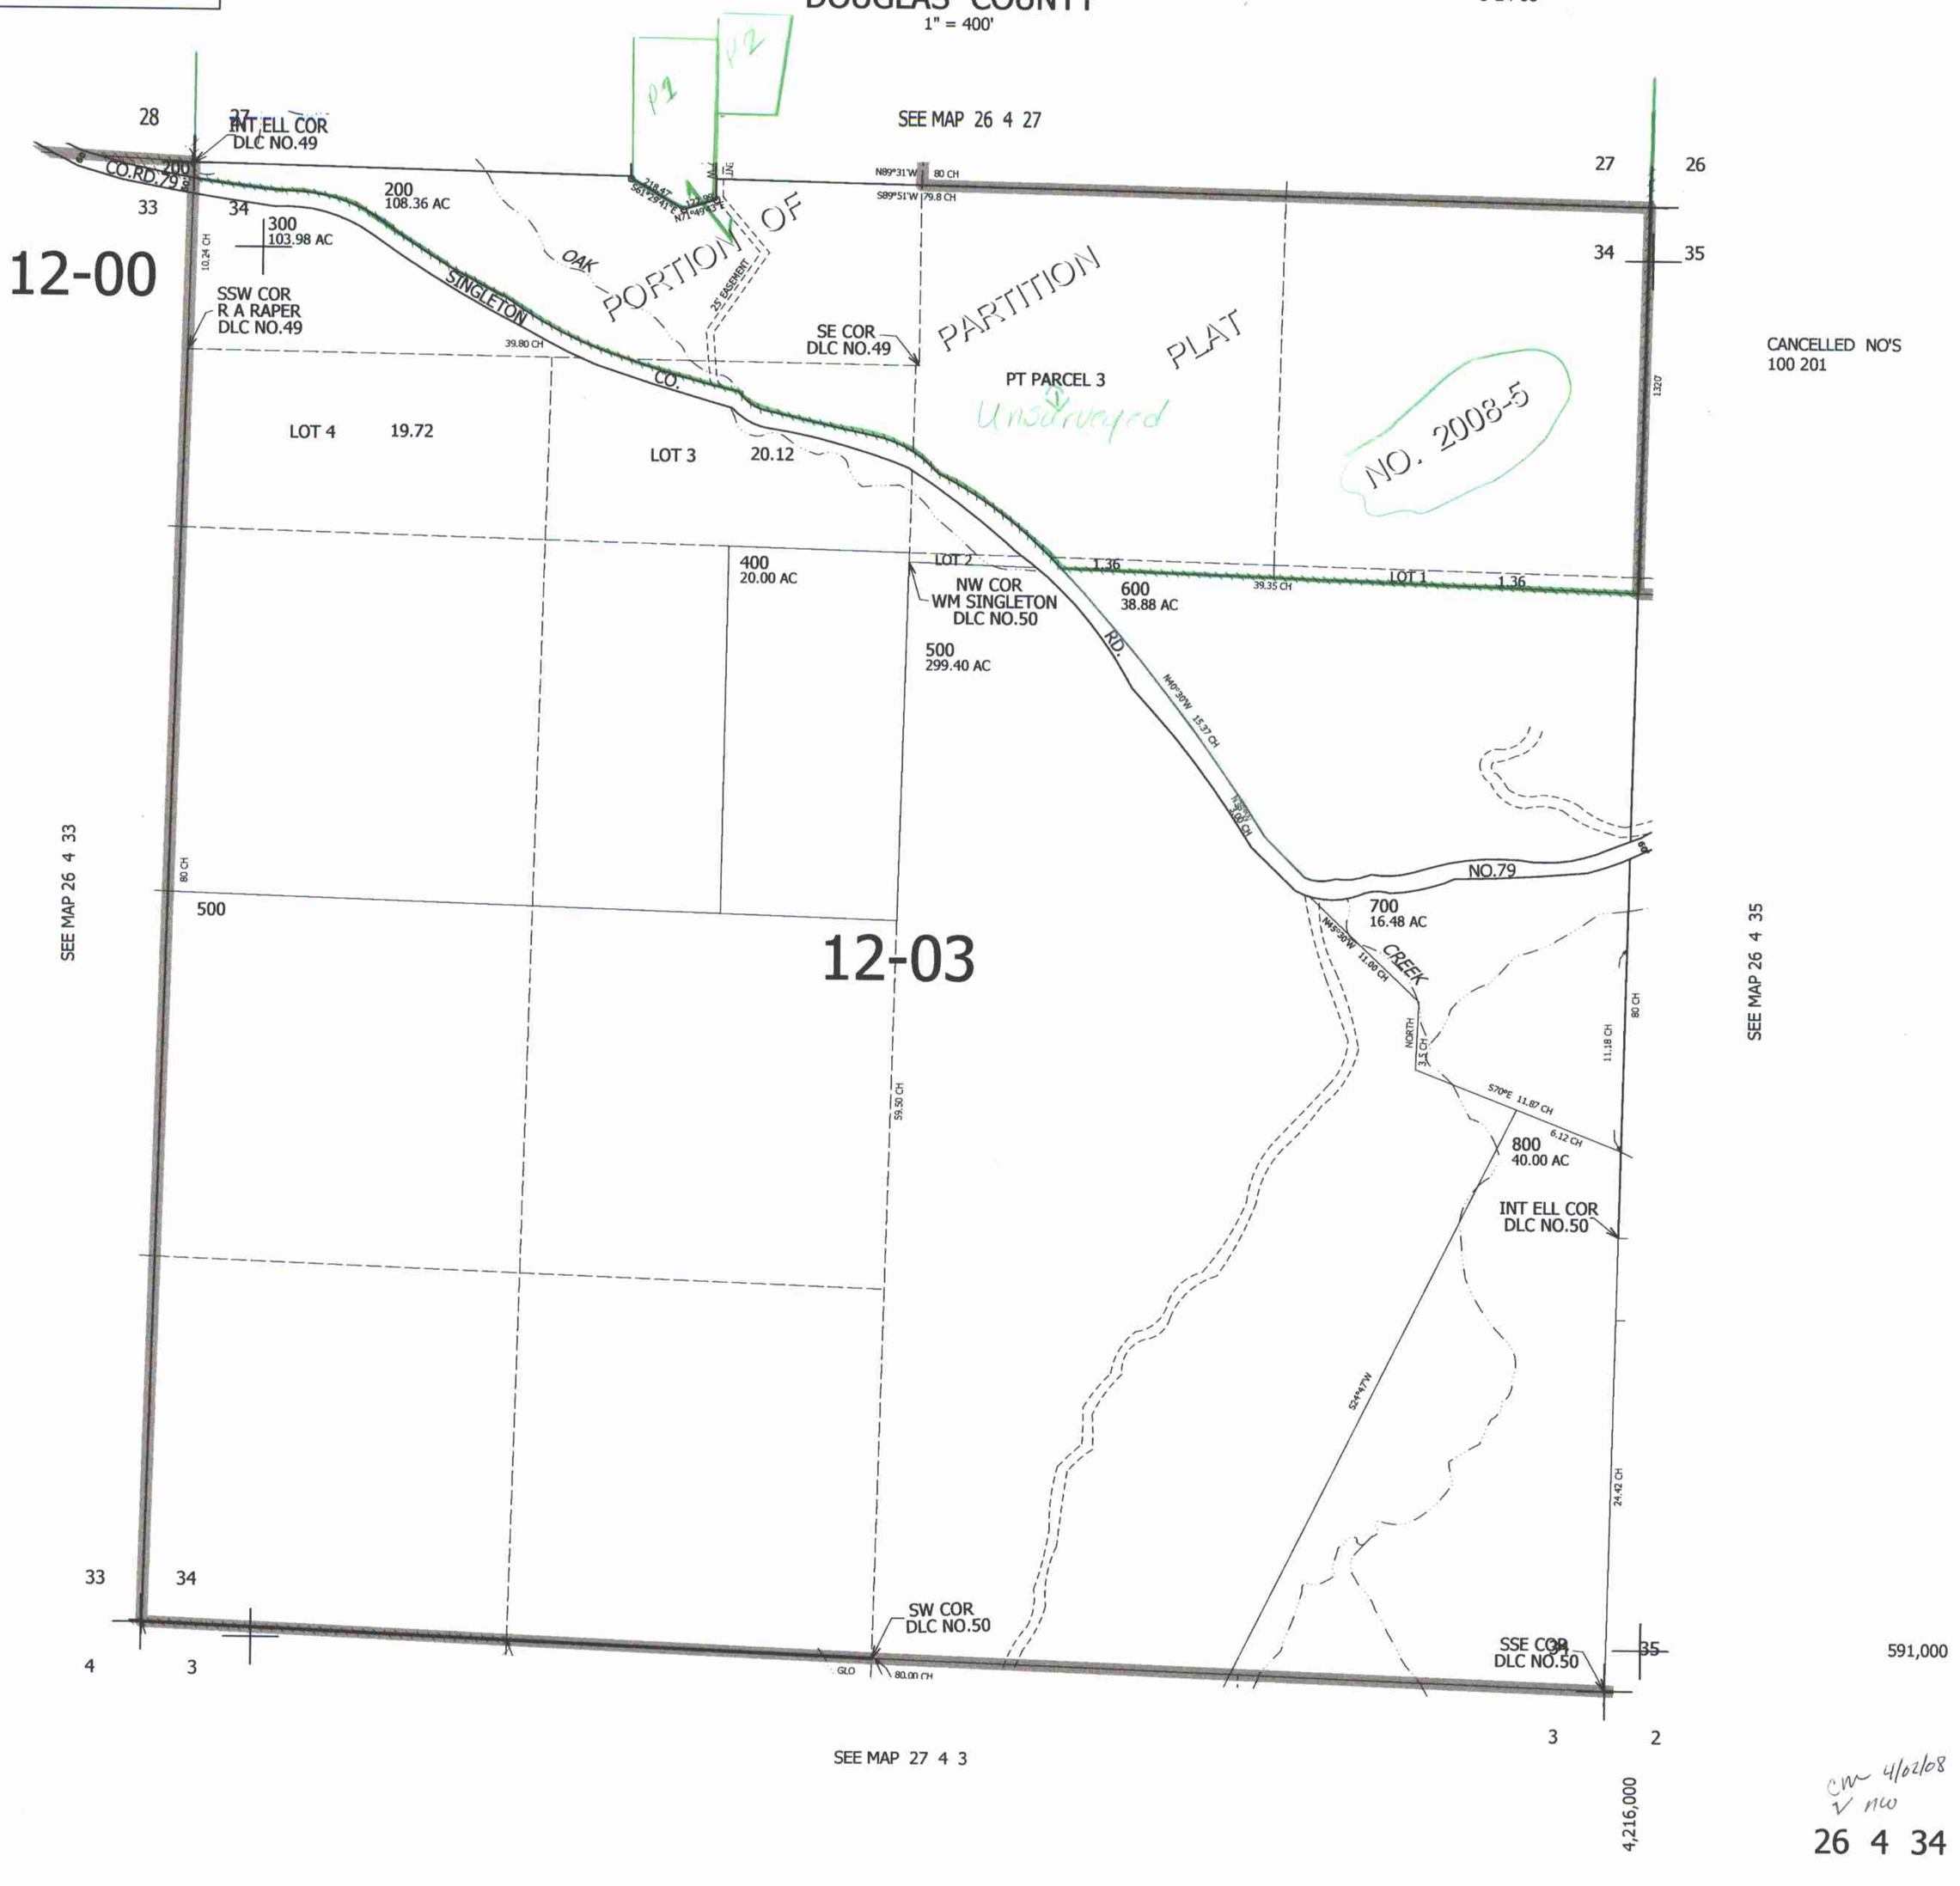

CANCELLED NO'S
100 201

CW 4/02/08
V nw

26 4 34