


M44-48 M119-74

1" = 2000' SEE MAP 25 5 00

CANCELLED NO'S 200M1

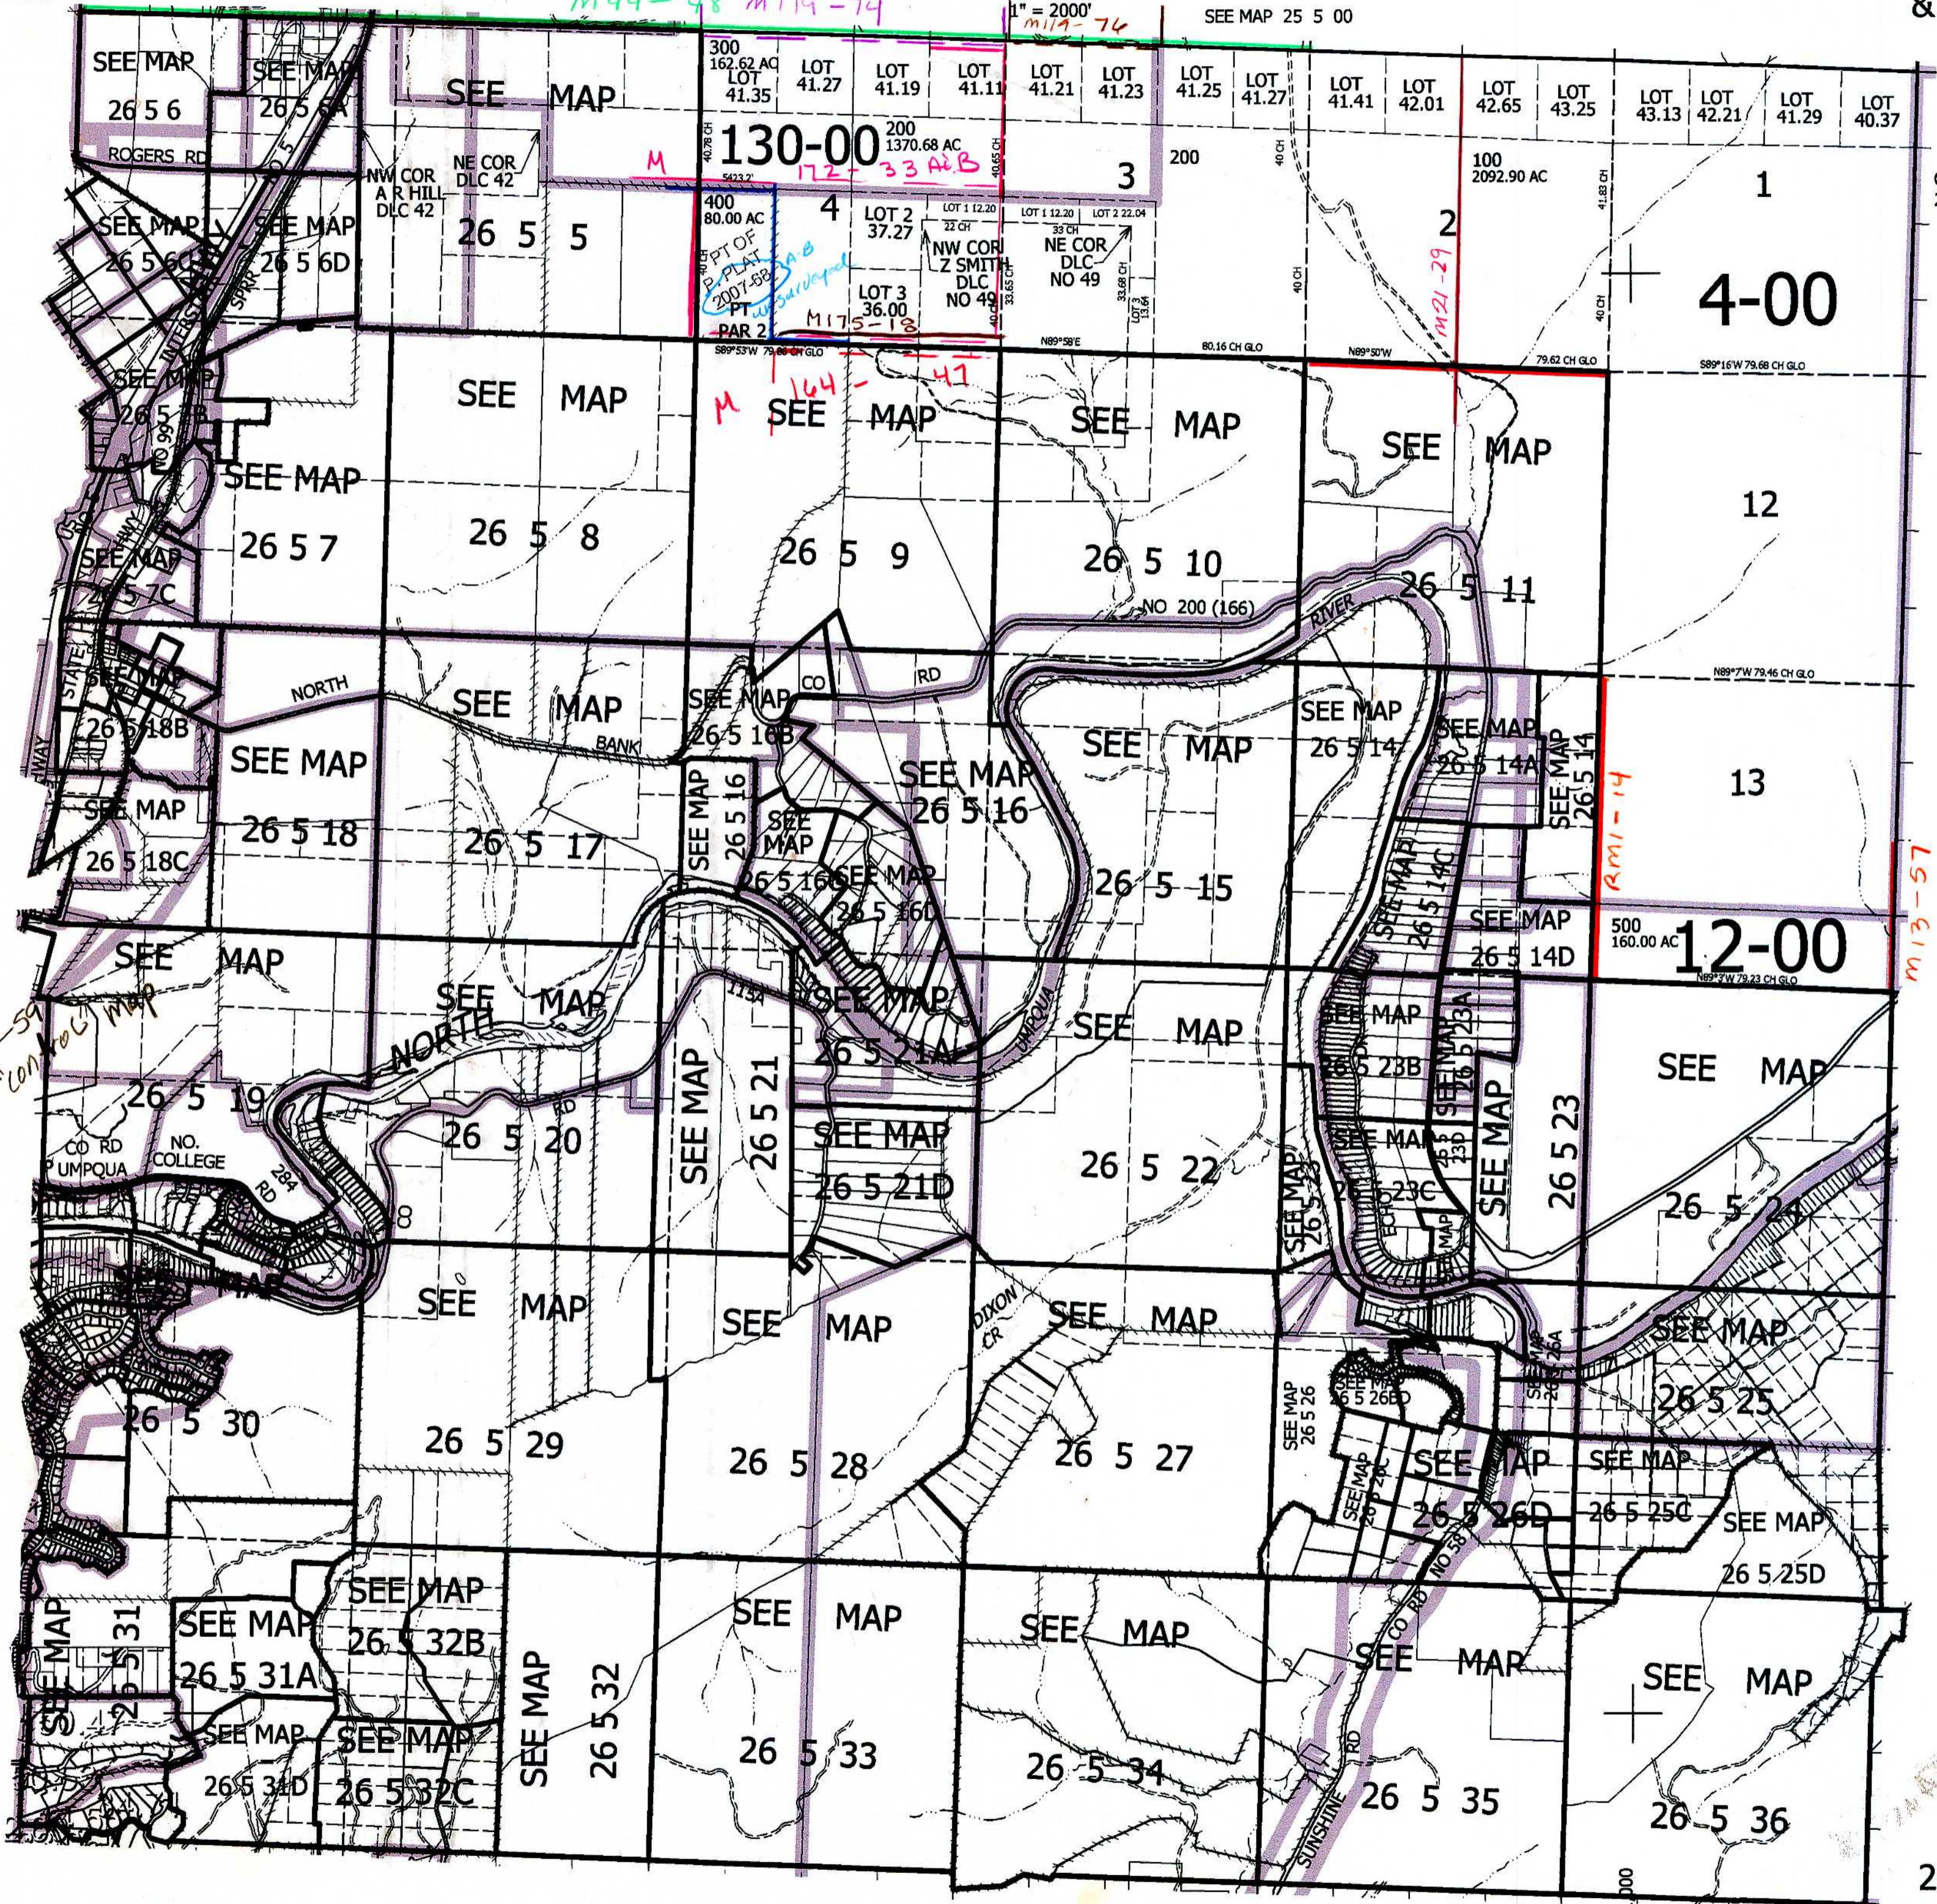

SEE MAP 26 6 00

SEE MAP 26 4 00

SEE M101-59 For Roseburg "Control" MAP

595,000

26 5 00 & INDEX
CW 6/27/07
JCV

SEE MAP 27 5 00

4,191,000