


THIS MAP WAS PREPARED FOR ASSESSMENT PURPOSE ONLY

SEC. 6 T.26S. R.5 W W.M. DOUGLAS COUNTY

REVISED ON 2-4-03

26 5 6 & INDEX

1"=400'

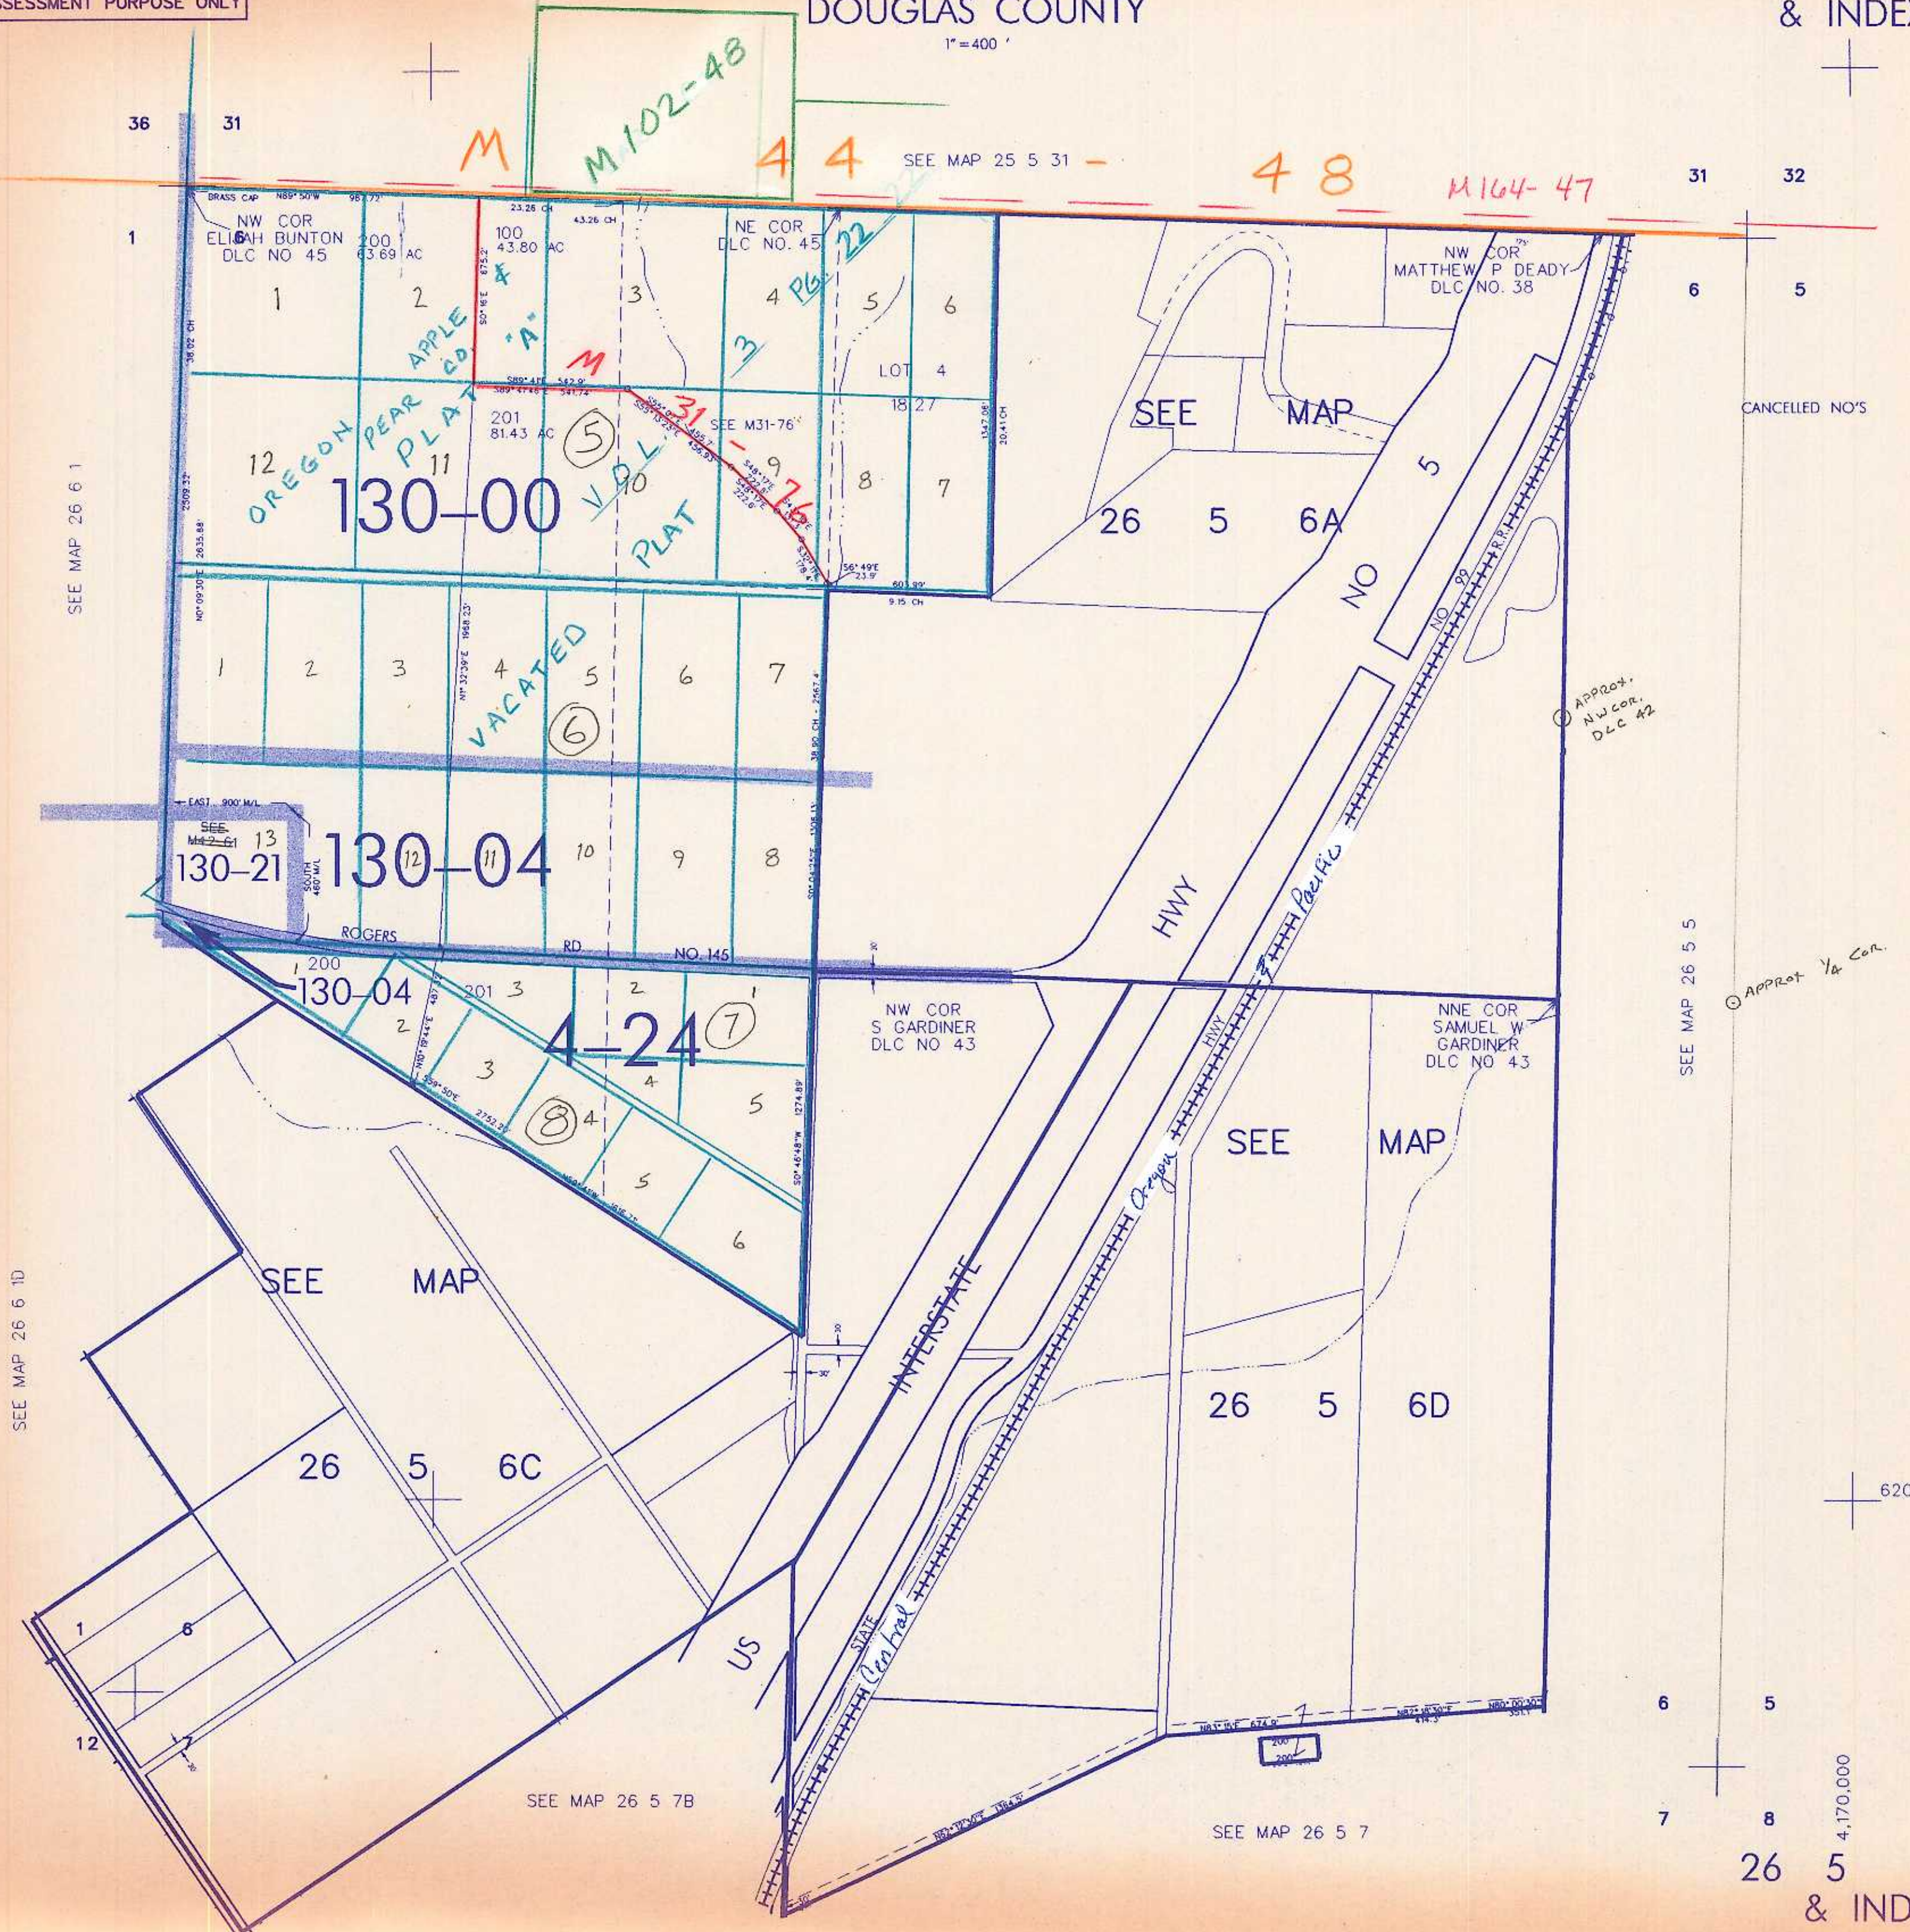

26 5 6 & INDEX  
2/03 JP