

THIS MAP WAS PREPARED FOR ASSESSMENT PURPOSE ONLY

NE1/4 SEC.6 T.26S. R.5W. W.M. DOUGLAS COUNTY

REVISED ON 6-12-18


26 5 6A

1" = 200'

M164-47

SEE MAP 25 5 31

M 4 4 4 - 4 8

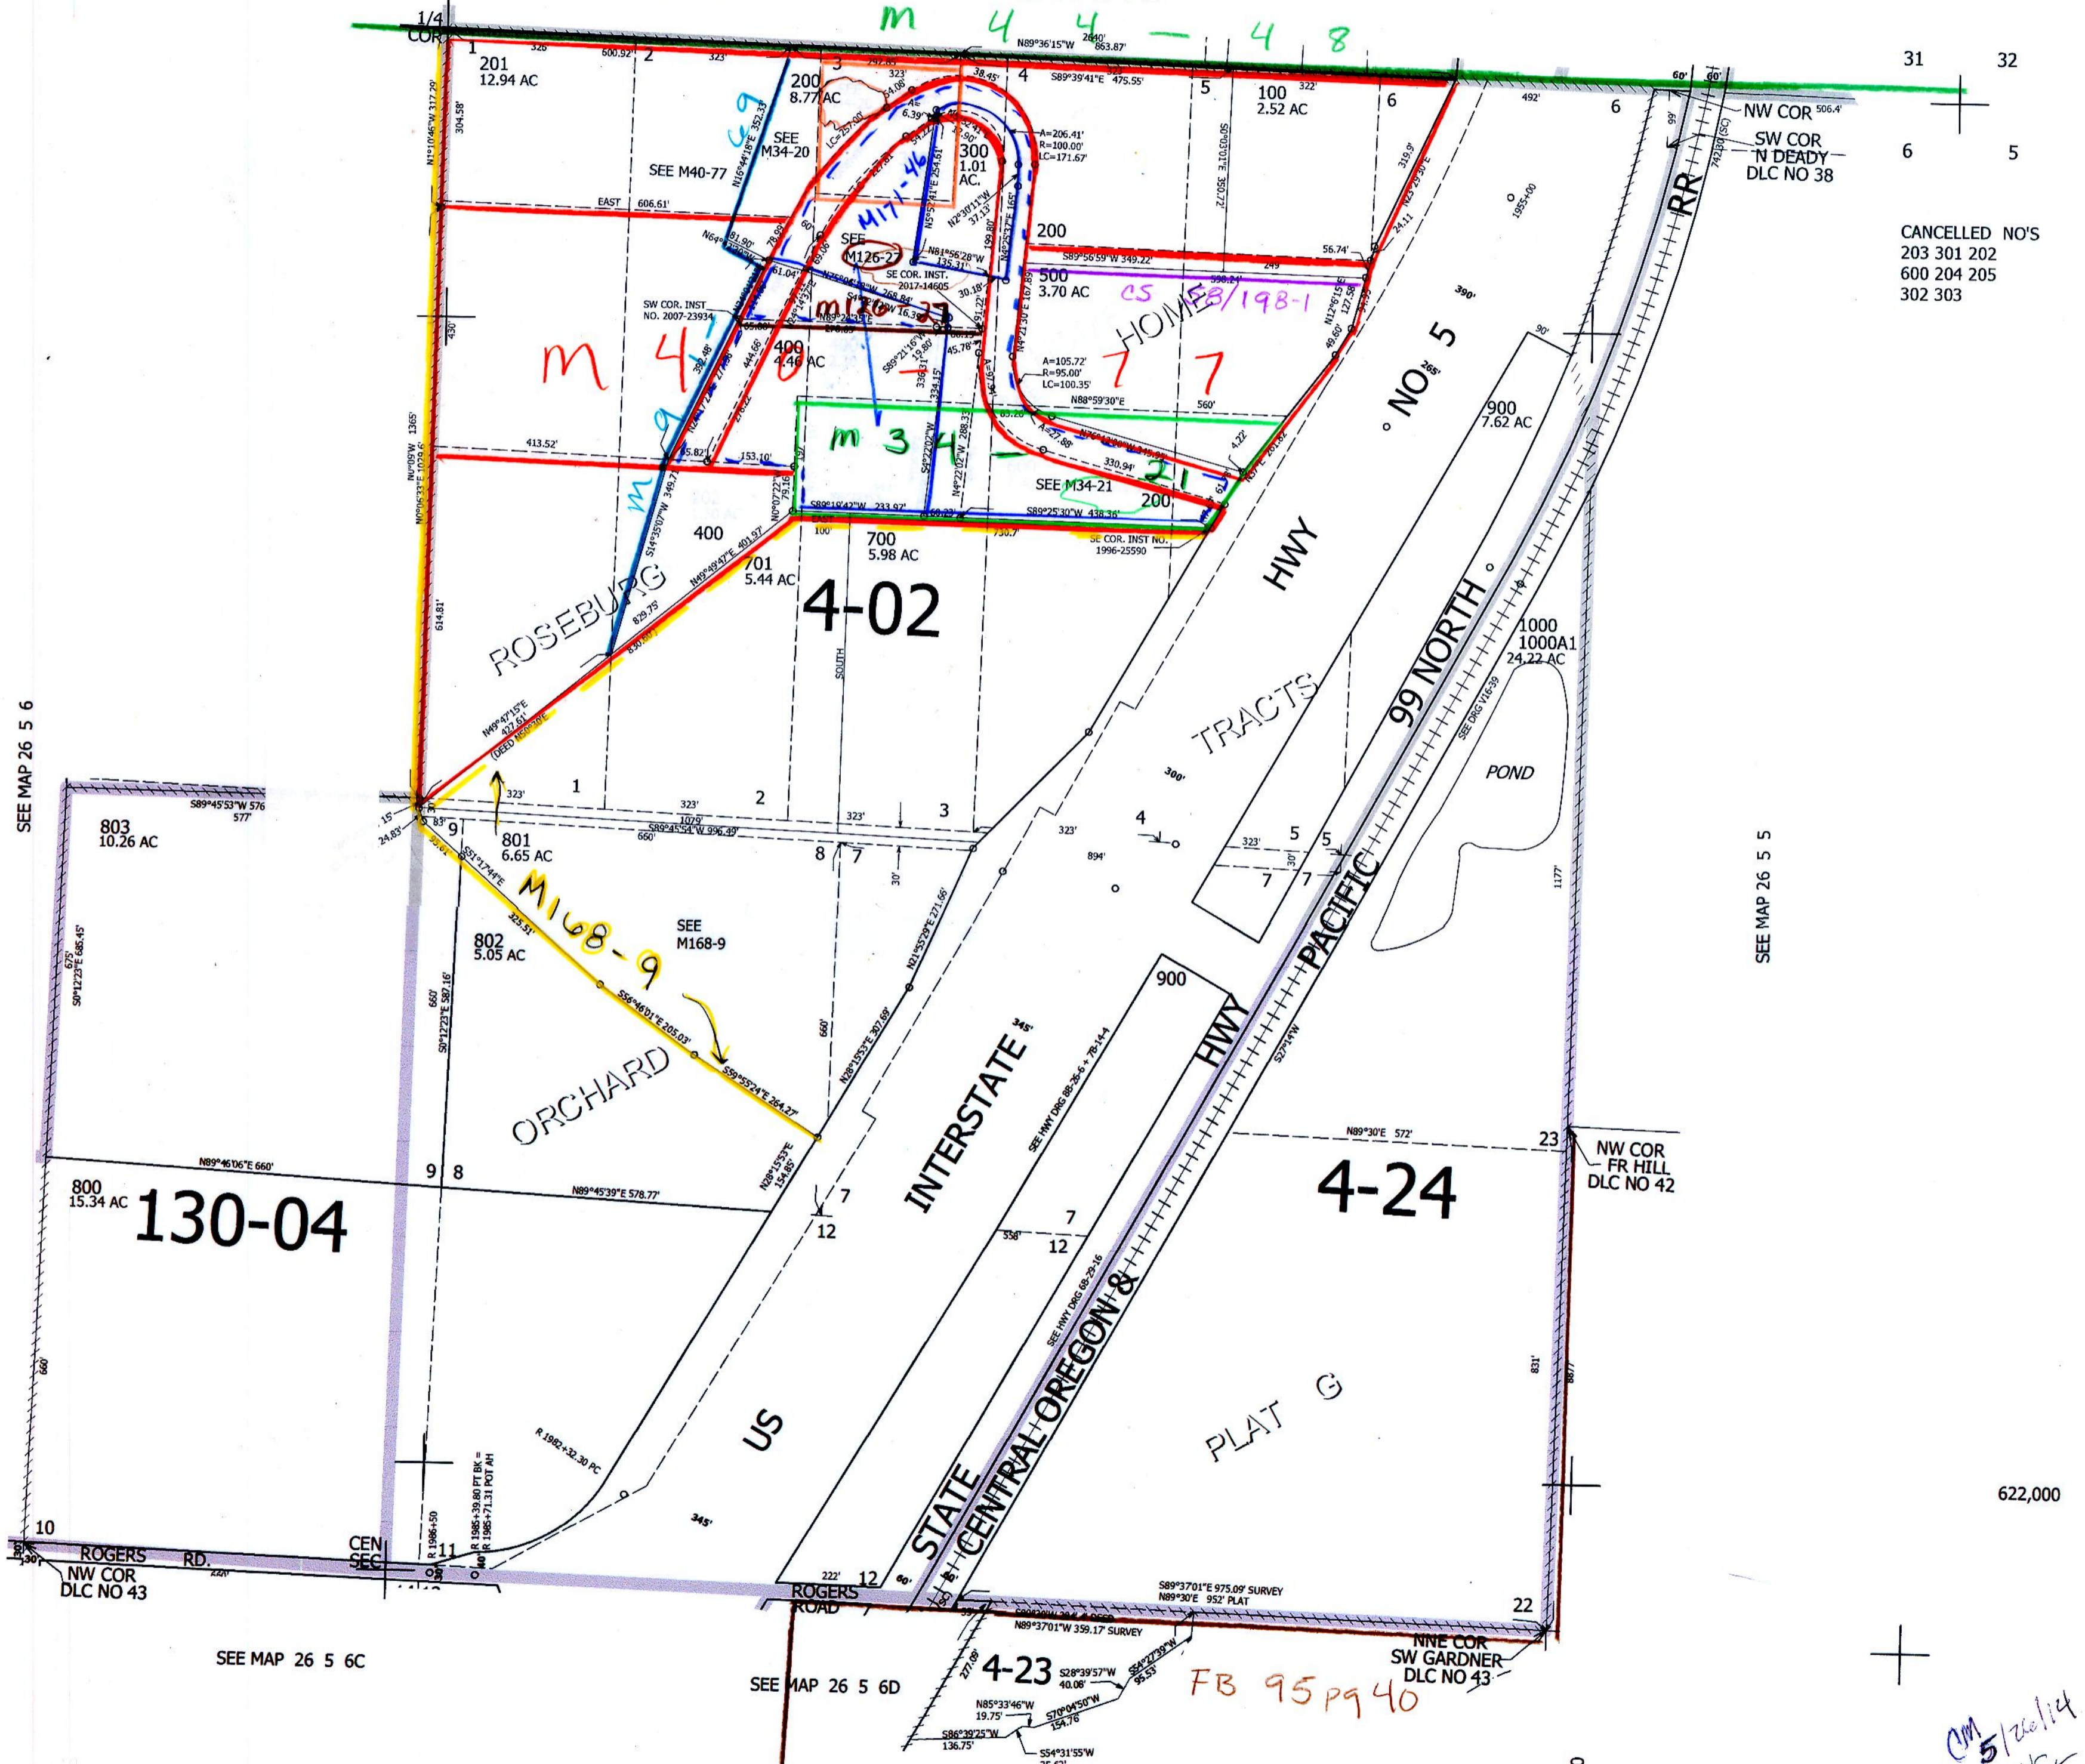

31	32
6	5

CANCELLED NO'S
203 301 202
600 204 205
302 303

SEE MAP 26 5 6

SEE MAP 26 5 5

SEE MAP 26 5 6C

SEE MAP 26 5 6D

622,000

4,169,000

26 5 6A

CM 5/26/14
JCV

FB 95 P 940

NINE COR SW GARDNER DLC NO 43

NW COR FR HILL DLC NO 42

NW COR N DEADY DLC NO 38

ROGERS RD. NW COR DLC NO 43

130-04

4-02

4-24

4-23

ORCHARD

ROSEBURG TRACTS

TRACTS

HWY

PACIFIC

INTERSTATE

STATE CENTRAL OREGON & PLAT G

99 NORTH

POND

RR

803 10.26 AC

801 6.65 AC

802 5.05 AC

800 15.34 AC

701 5.44 AC

700 5.98 AC

500 3.70 AC

200 8.77 AC

100 2.52 AC

900 7.62 AC

1000 1000A1 24.22 AC

ROGERS RD. NW COR DLC NO 43

CEN SEC

ROGERS ROAD

S89°37'01"E 975.09' SURVEY
N89°30'E 952' PLAT

N89°37'01"W 359.17' SURVEY

N85°33'46"W 19.75'
S70°04'50"W 154.76'
S54°31'55"W 35.62'

S28°33'57"W 40.06'
S54°27'37"W 95.53'

NINE COR SW GARDNER DLC NO 43

NW COR FR HILL DLC NO 42

NW COR FR HILL DLC NO 42

NW COR N DEADY DLC NO 38

+

CM 5/26/14
JCV