

APPROX  
1/4 COR.

This map was prepared for  
assessment purpose only.



SW1/4 SEC. 6 T.26S. R.5W. W.M.

DOUGLAS COUNTY

1" = 200'

SEE MAP 26 5 6

APPROX  
CEN. SEC.

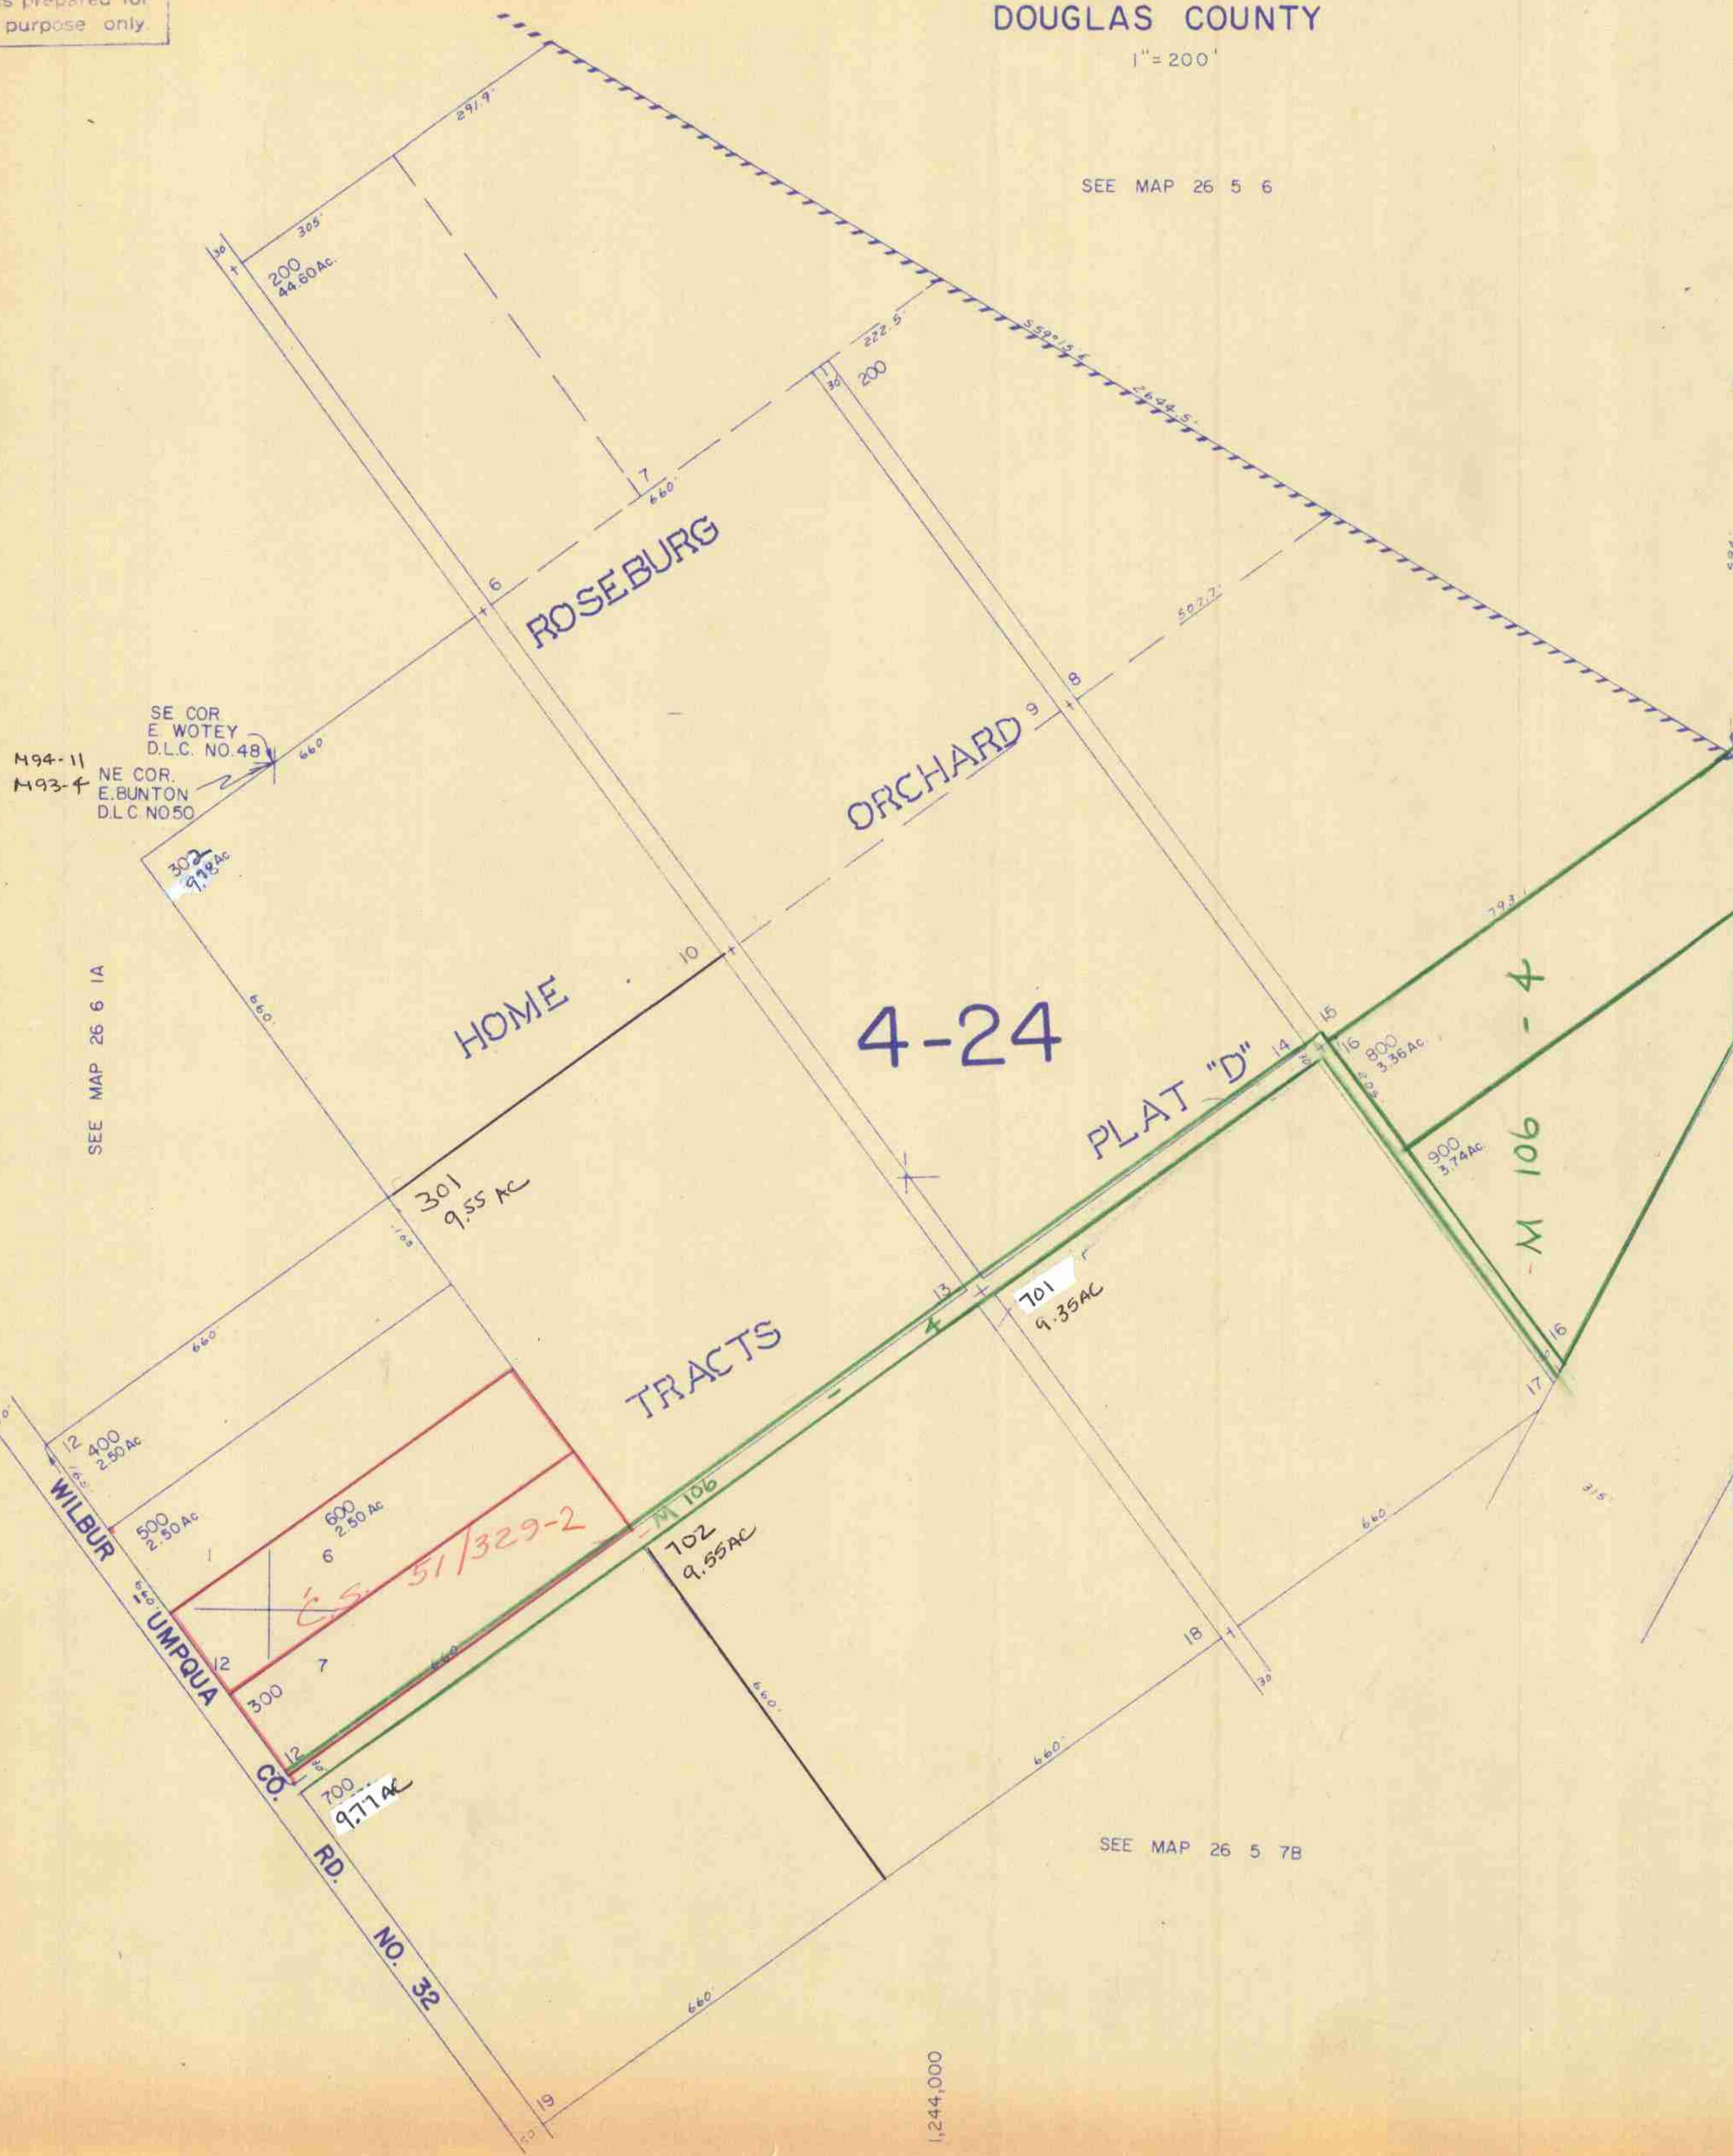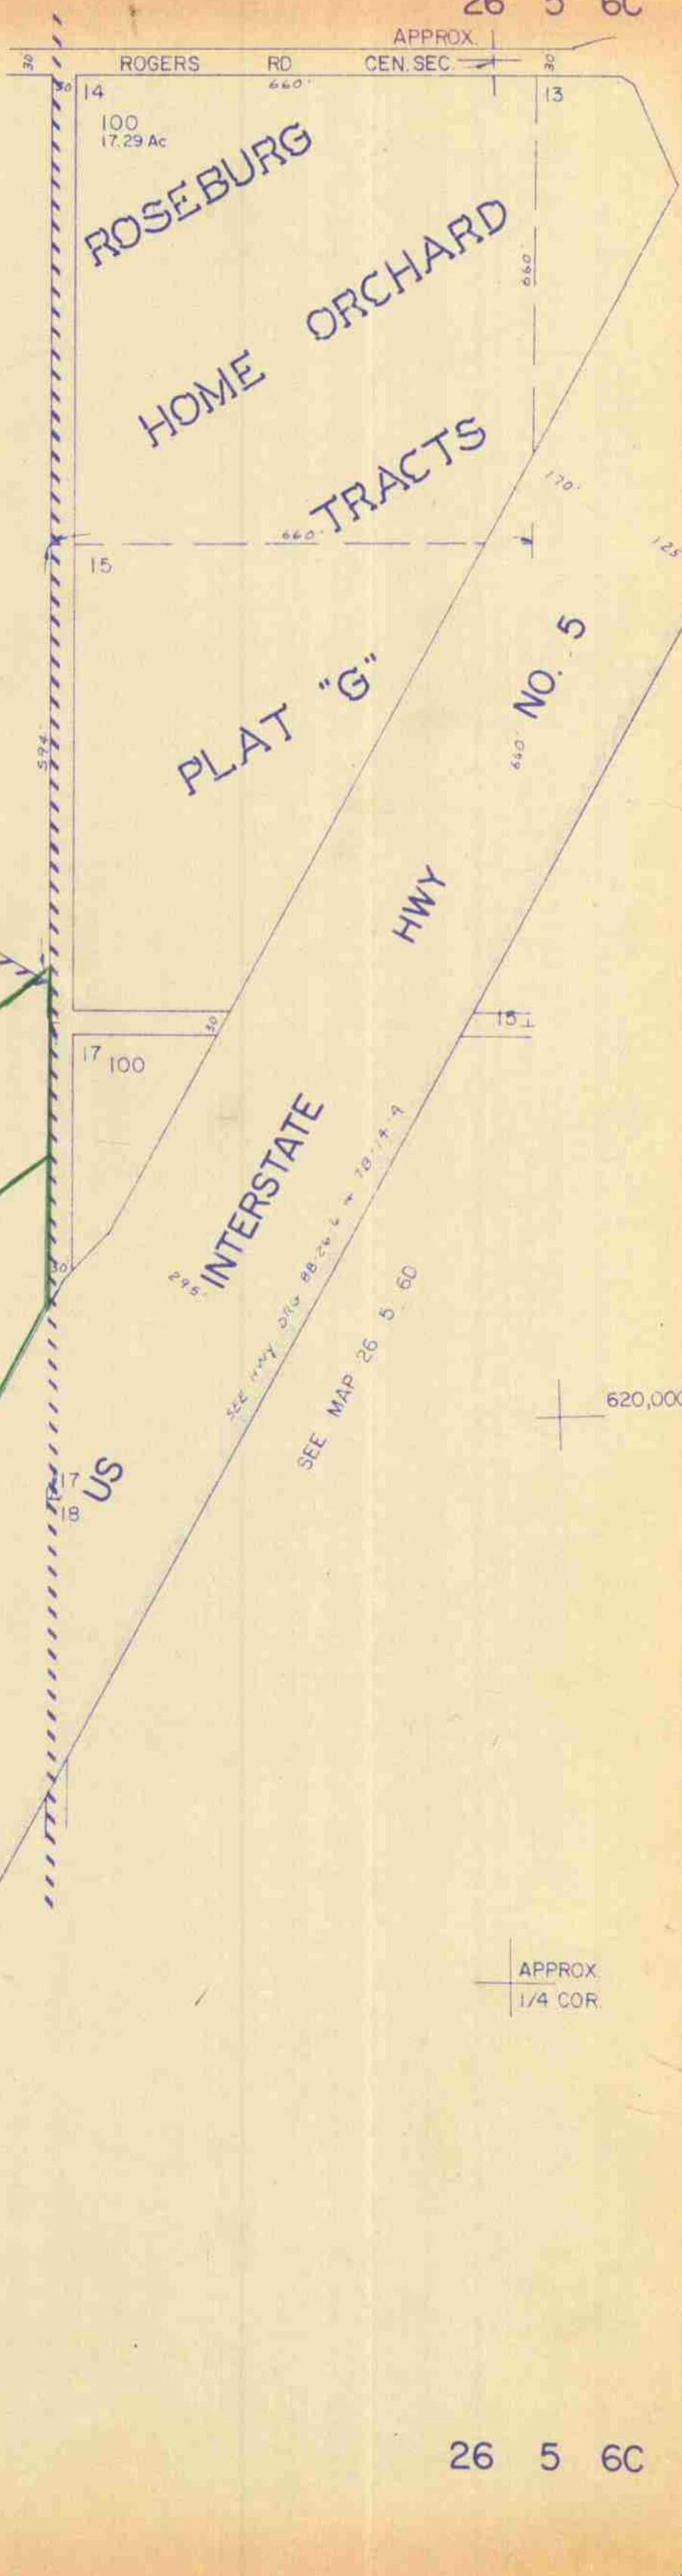

M94-11 SE COR. E WOTEY D.L.C. NO. 48  
M93-f NE COR. E. BUNTON D.L.C. NO. 50

SEE MAP 26 6 1A

620,000

APPROX  
1/4 COR.

SEE MAP 26 5 7B

1,244,000

10/18/21