

THIS MAP WAS PREPARED FOR ASSESSMENT PURPOSE ONLY.


NW1/4 SEC.7 T.26S. R.5W. W.M.  
DOUGLAS COUNTY  
1" = 200'

REVISED ON  
3-30-16

26 5 7B

CANCELLED NO'S  
900 1601

1 6  
12 7

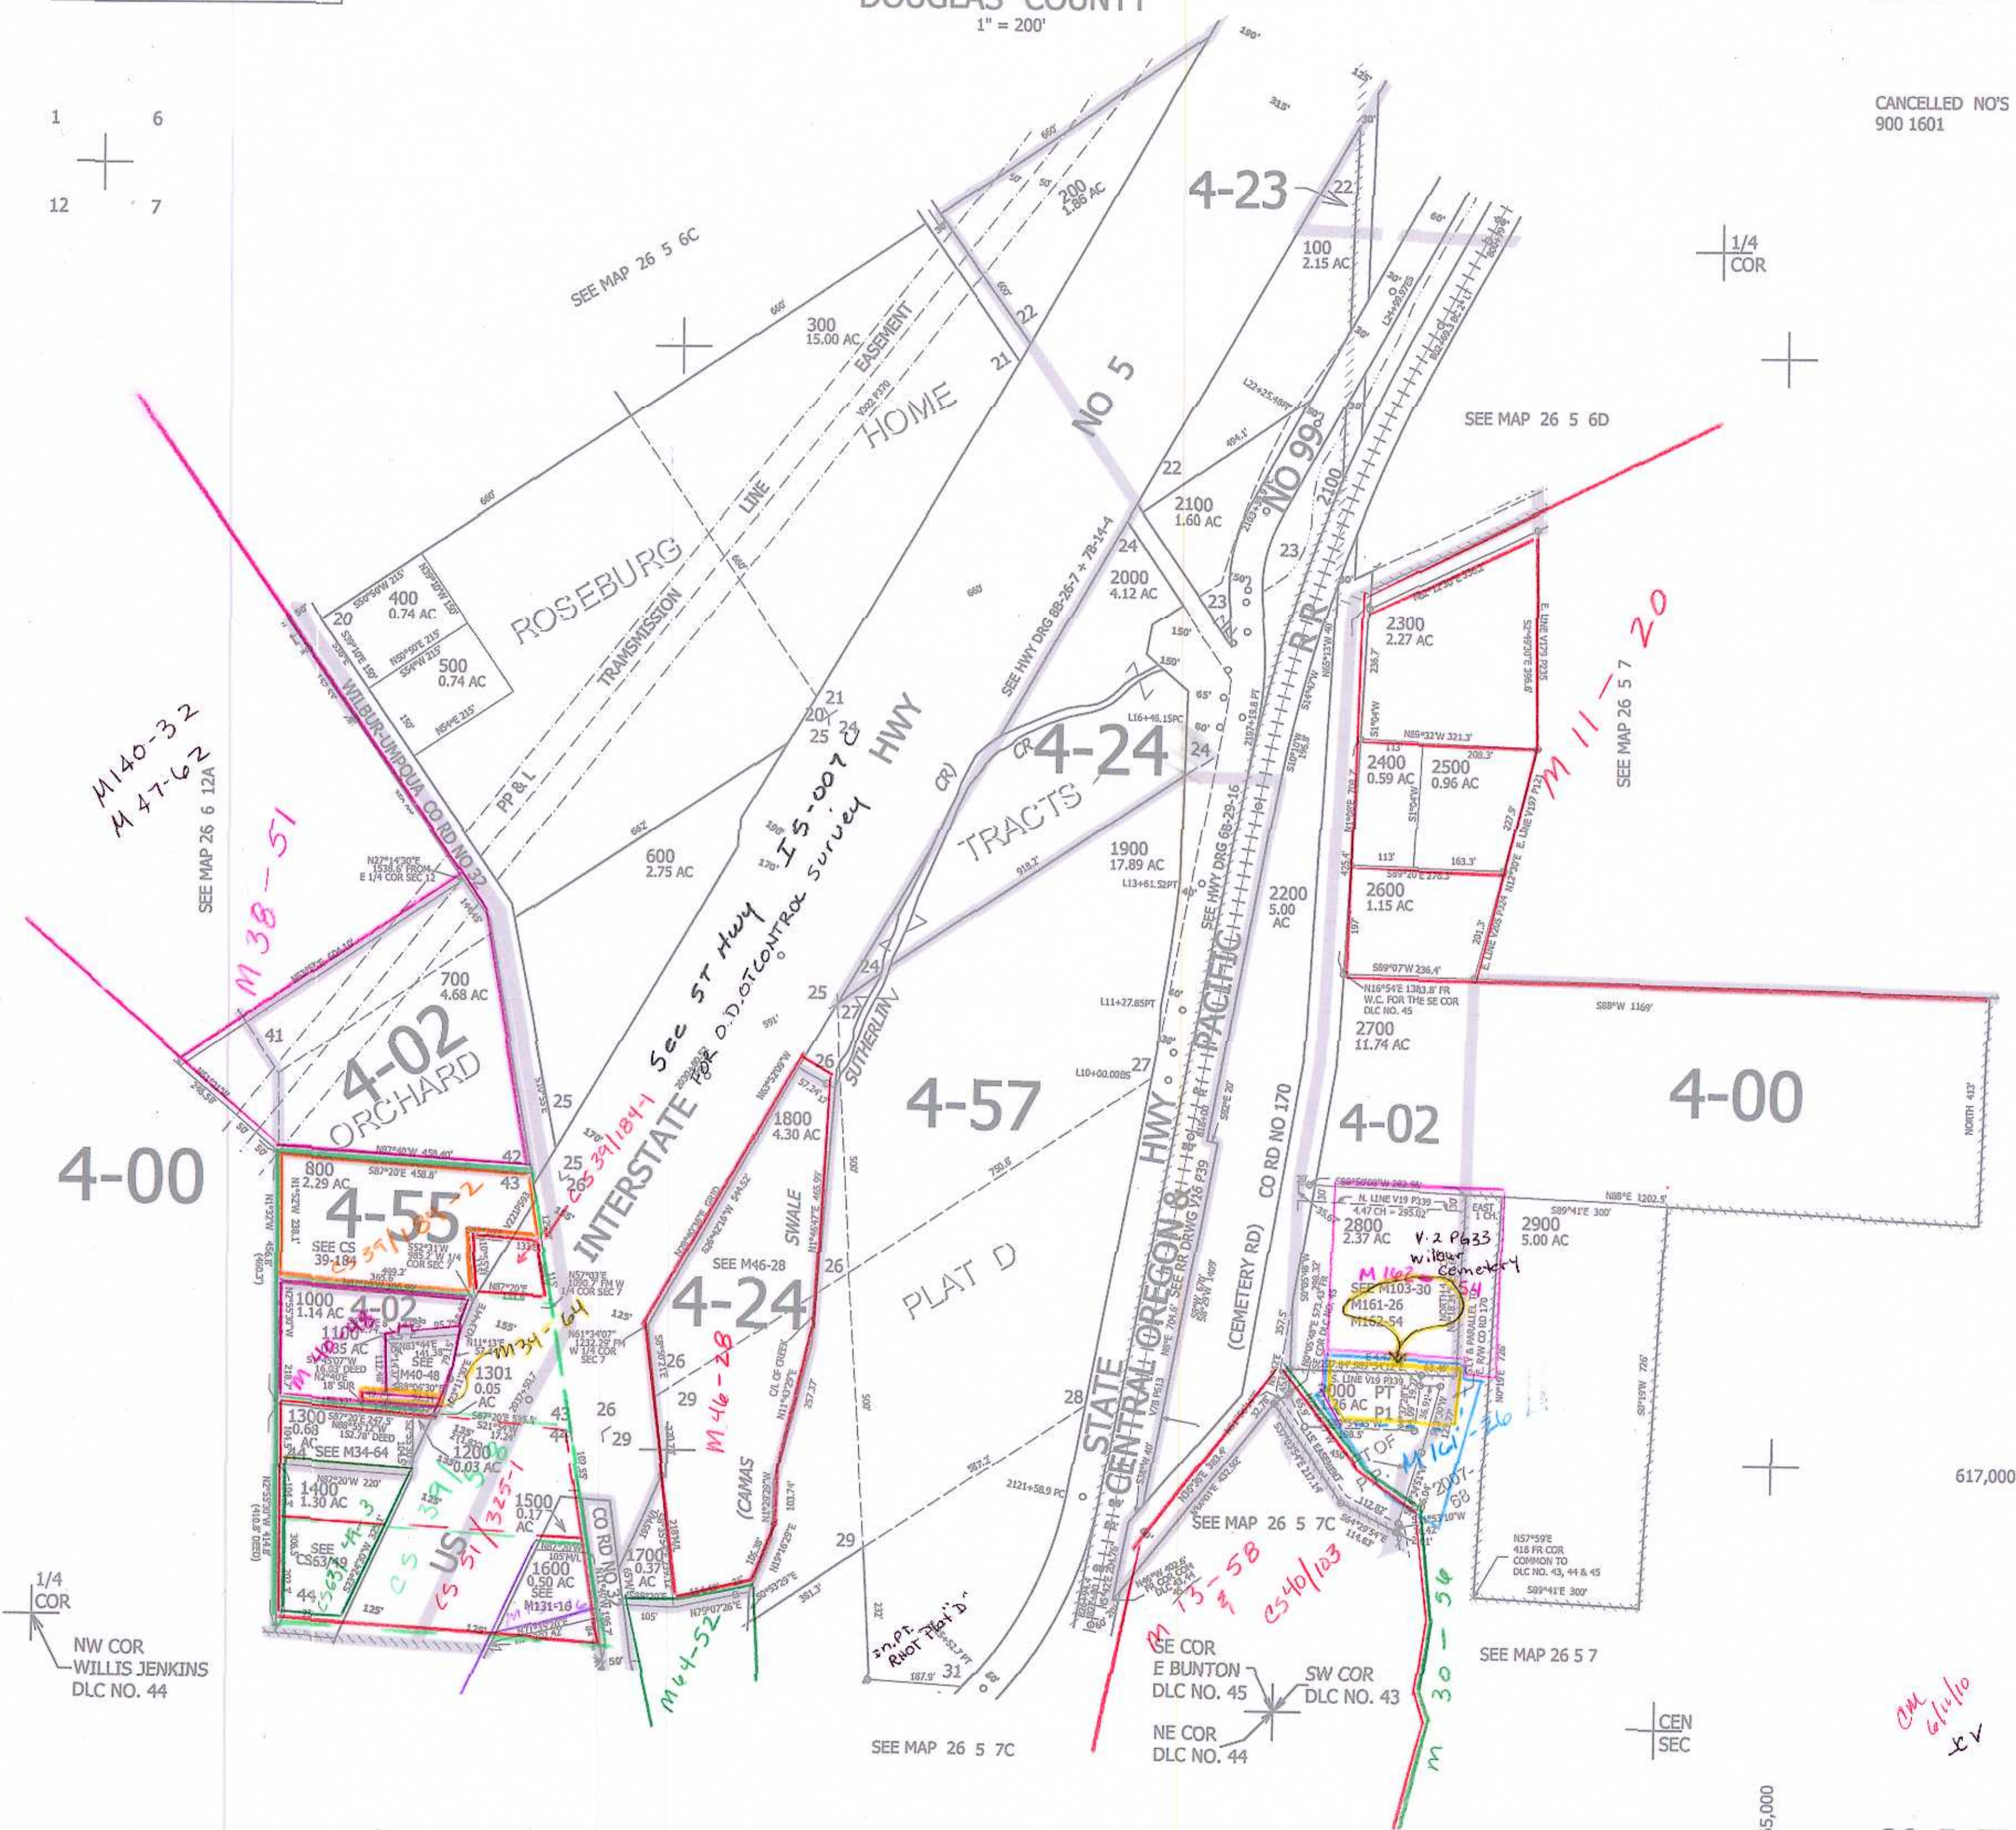

1/4  
COR

+

+

+

4-00

4-02  
ORCHARD

4-55

4-24

4-57

PLAT D

4-23

4-24  
TRACTS

4-02

4-00

1/4  
COR  
NW COR  
WILLIS JENKINS  
DLC NO. 44

SE COR  
E BUNTON  
DLC NO. 45  
SW COR  
DLC NO. 43  
NE COR  
DLC NO. 44

SEE MAP 26 5 7

CEN  
SEC

617,000

4,165,000

am  
6/1/16  
EV

26 5 7B