


THIS MAP WAS PREPARED FOR ASSESSMENT PURPOSE ONLY.

SEC.11 T.26S. R.5W. W.M.
DOUGLAS COUNTY

1" = 400'

REVISED ON
3-3-05

26 5 11

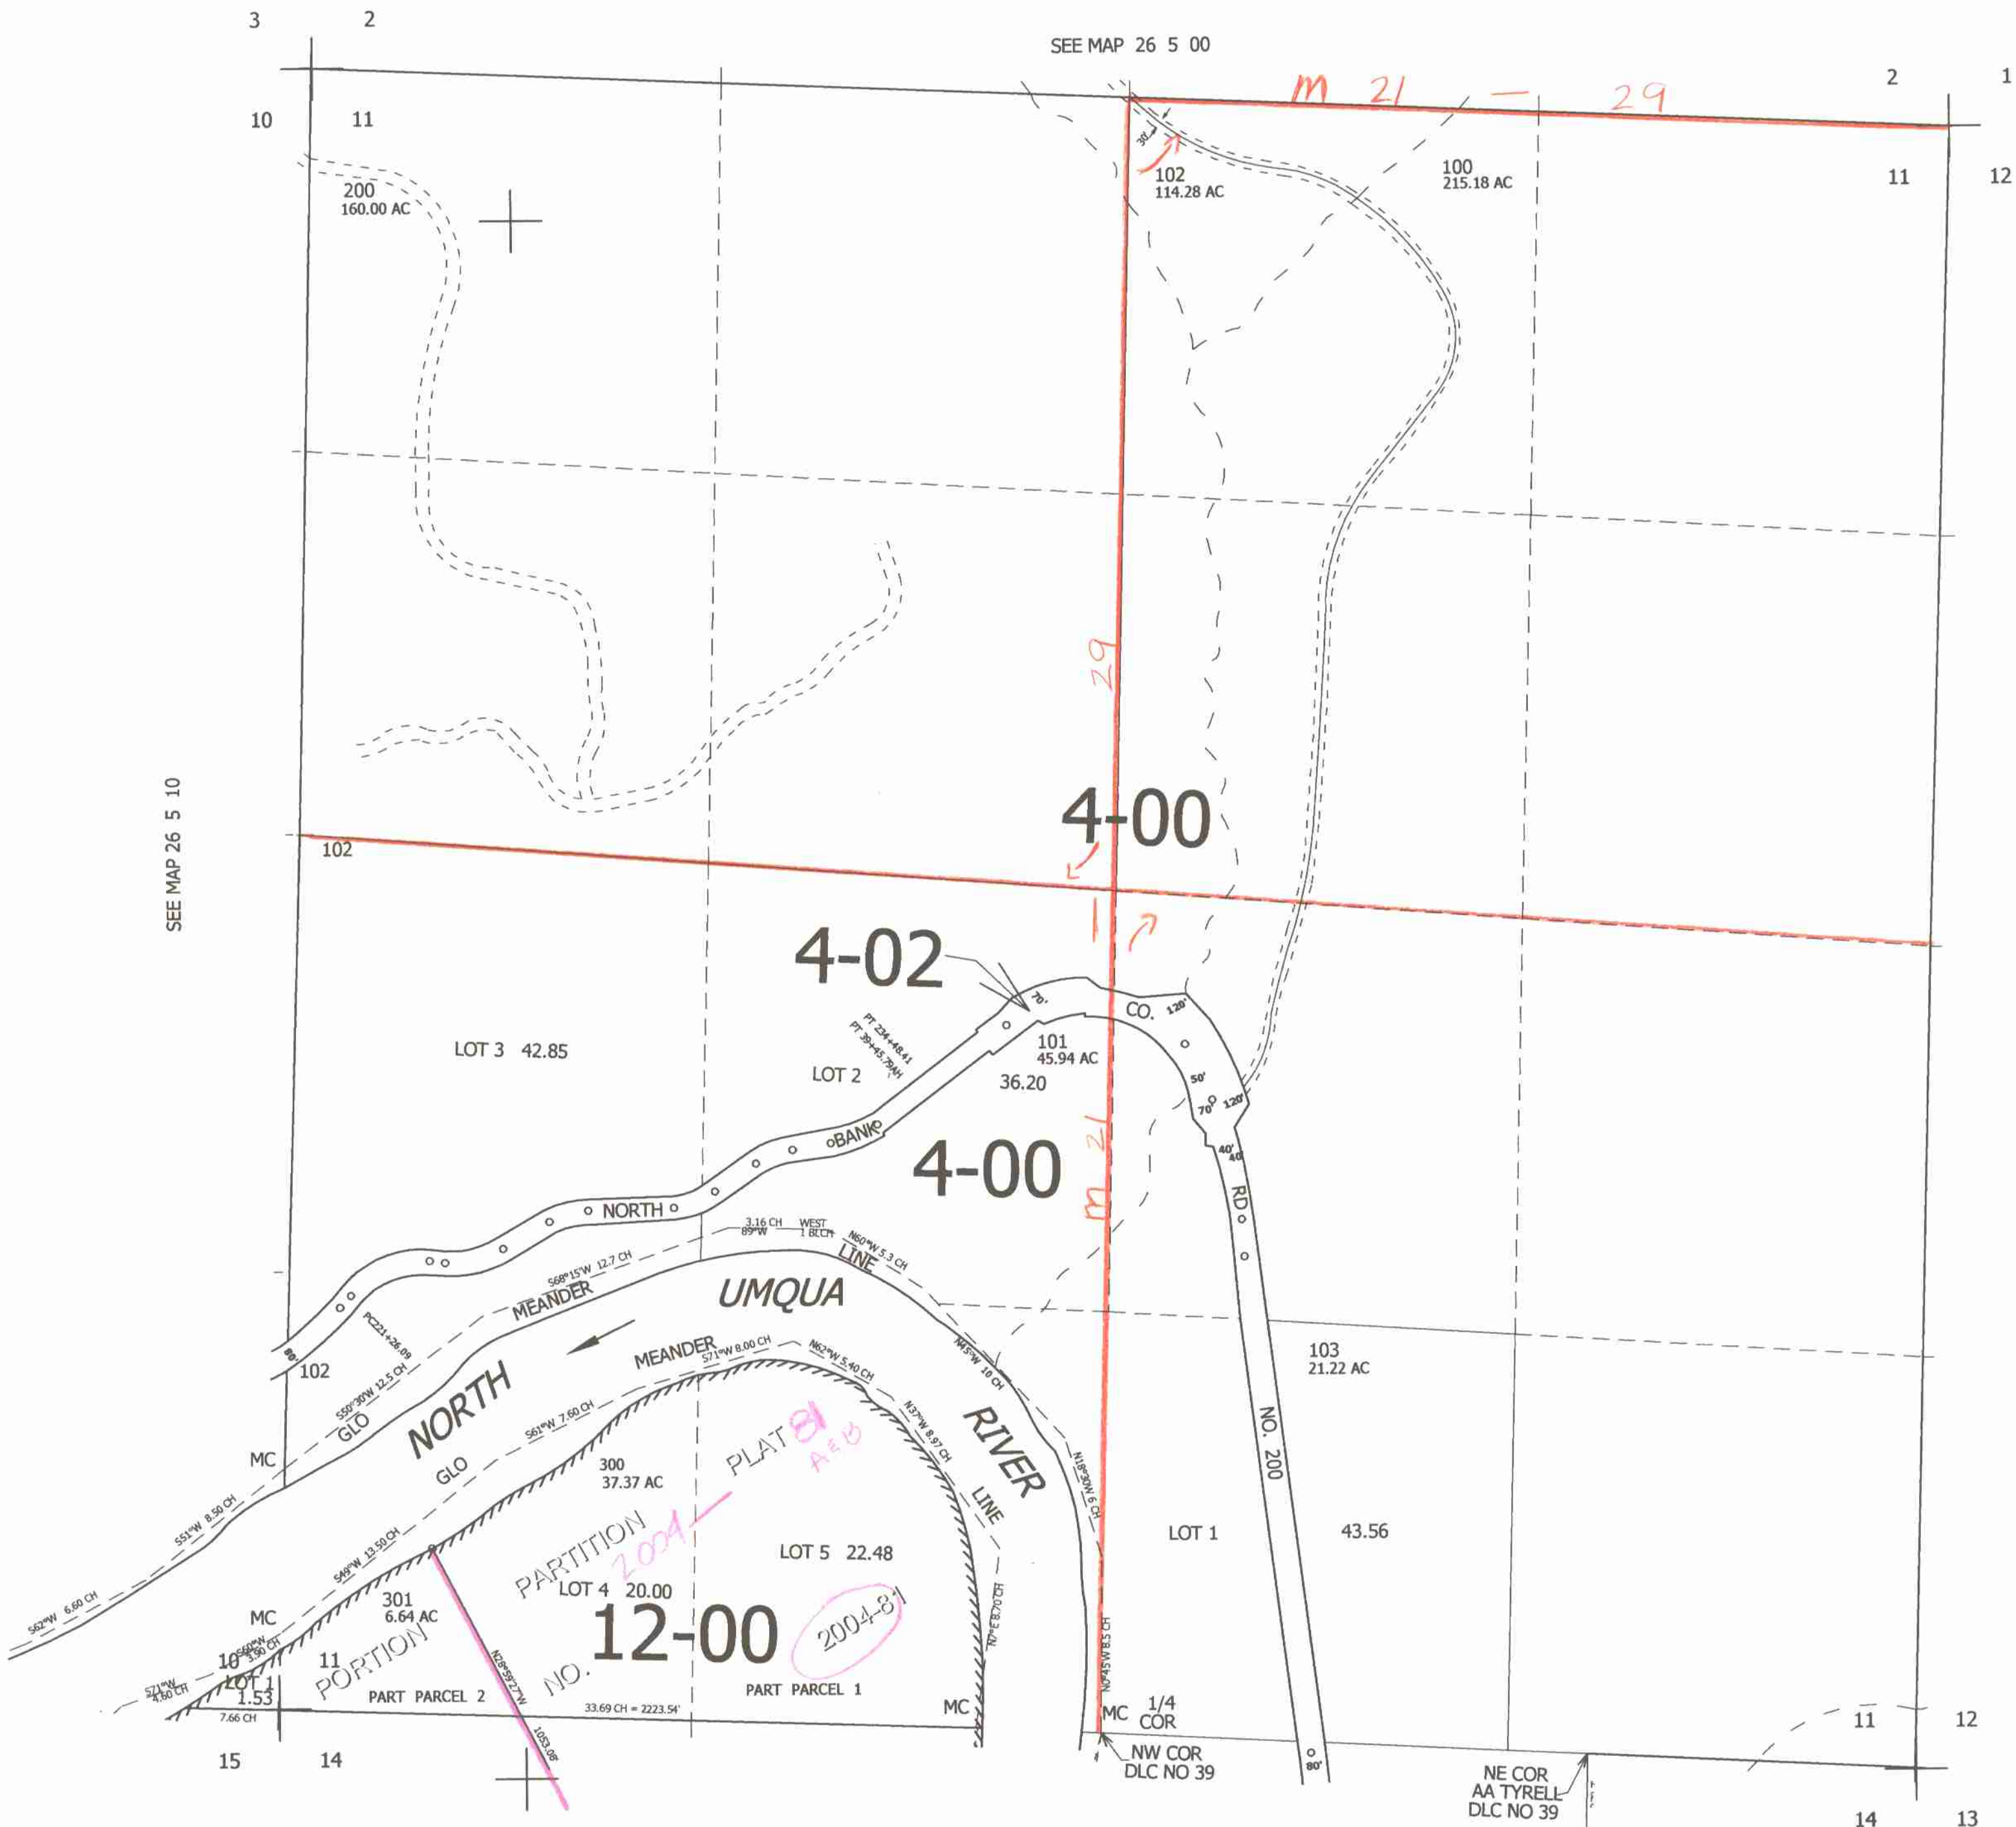

SEE MAP 26 5 10

SEE MAP 26 5 00

SEE MAP 26 5 00

SEE MAP 26 5 14

SEE MAP 26 5 14A

SEE MAP 26 5 14

CANCELLED NO'S
200M1

613,000

4,191,000

26 5 11