


THIS MAP WAS PREPARED FOR ASSESSMENT PURPOSE ONLY.

SEC.15 T.26S. R.5W. W.M. DOUGLAS COUNTY

1" = 400'

REVISED ON 3-3-05

26 5 15

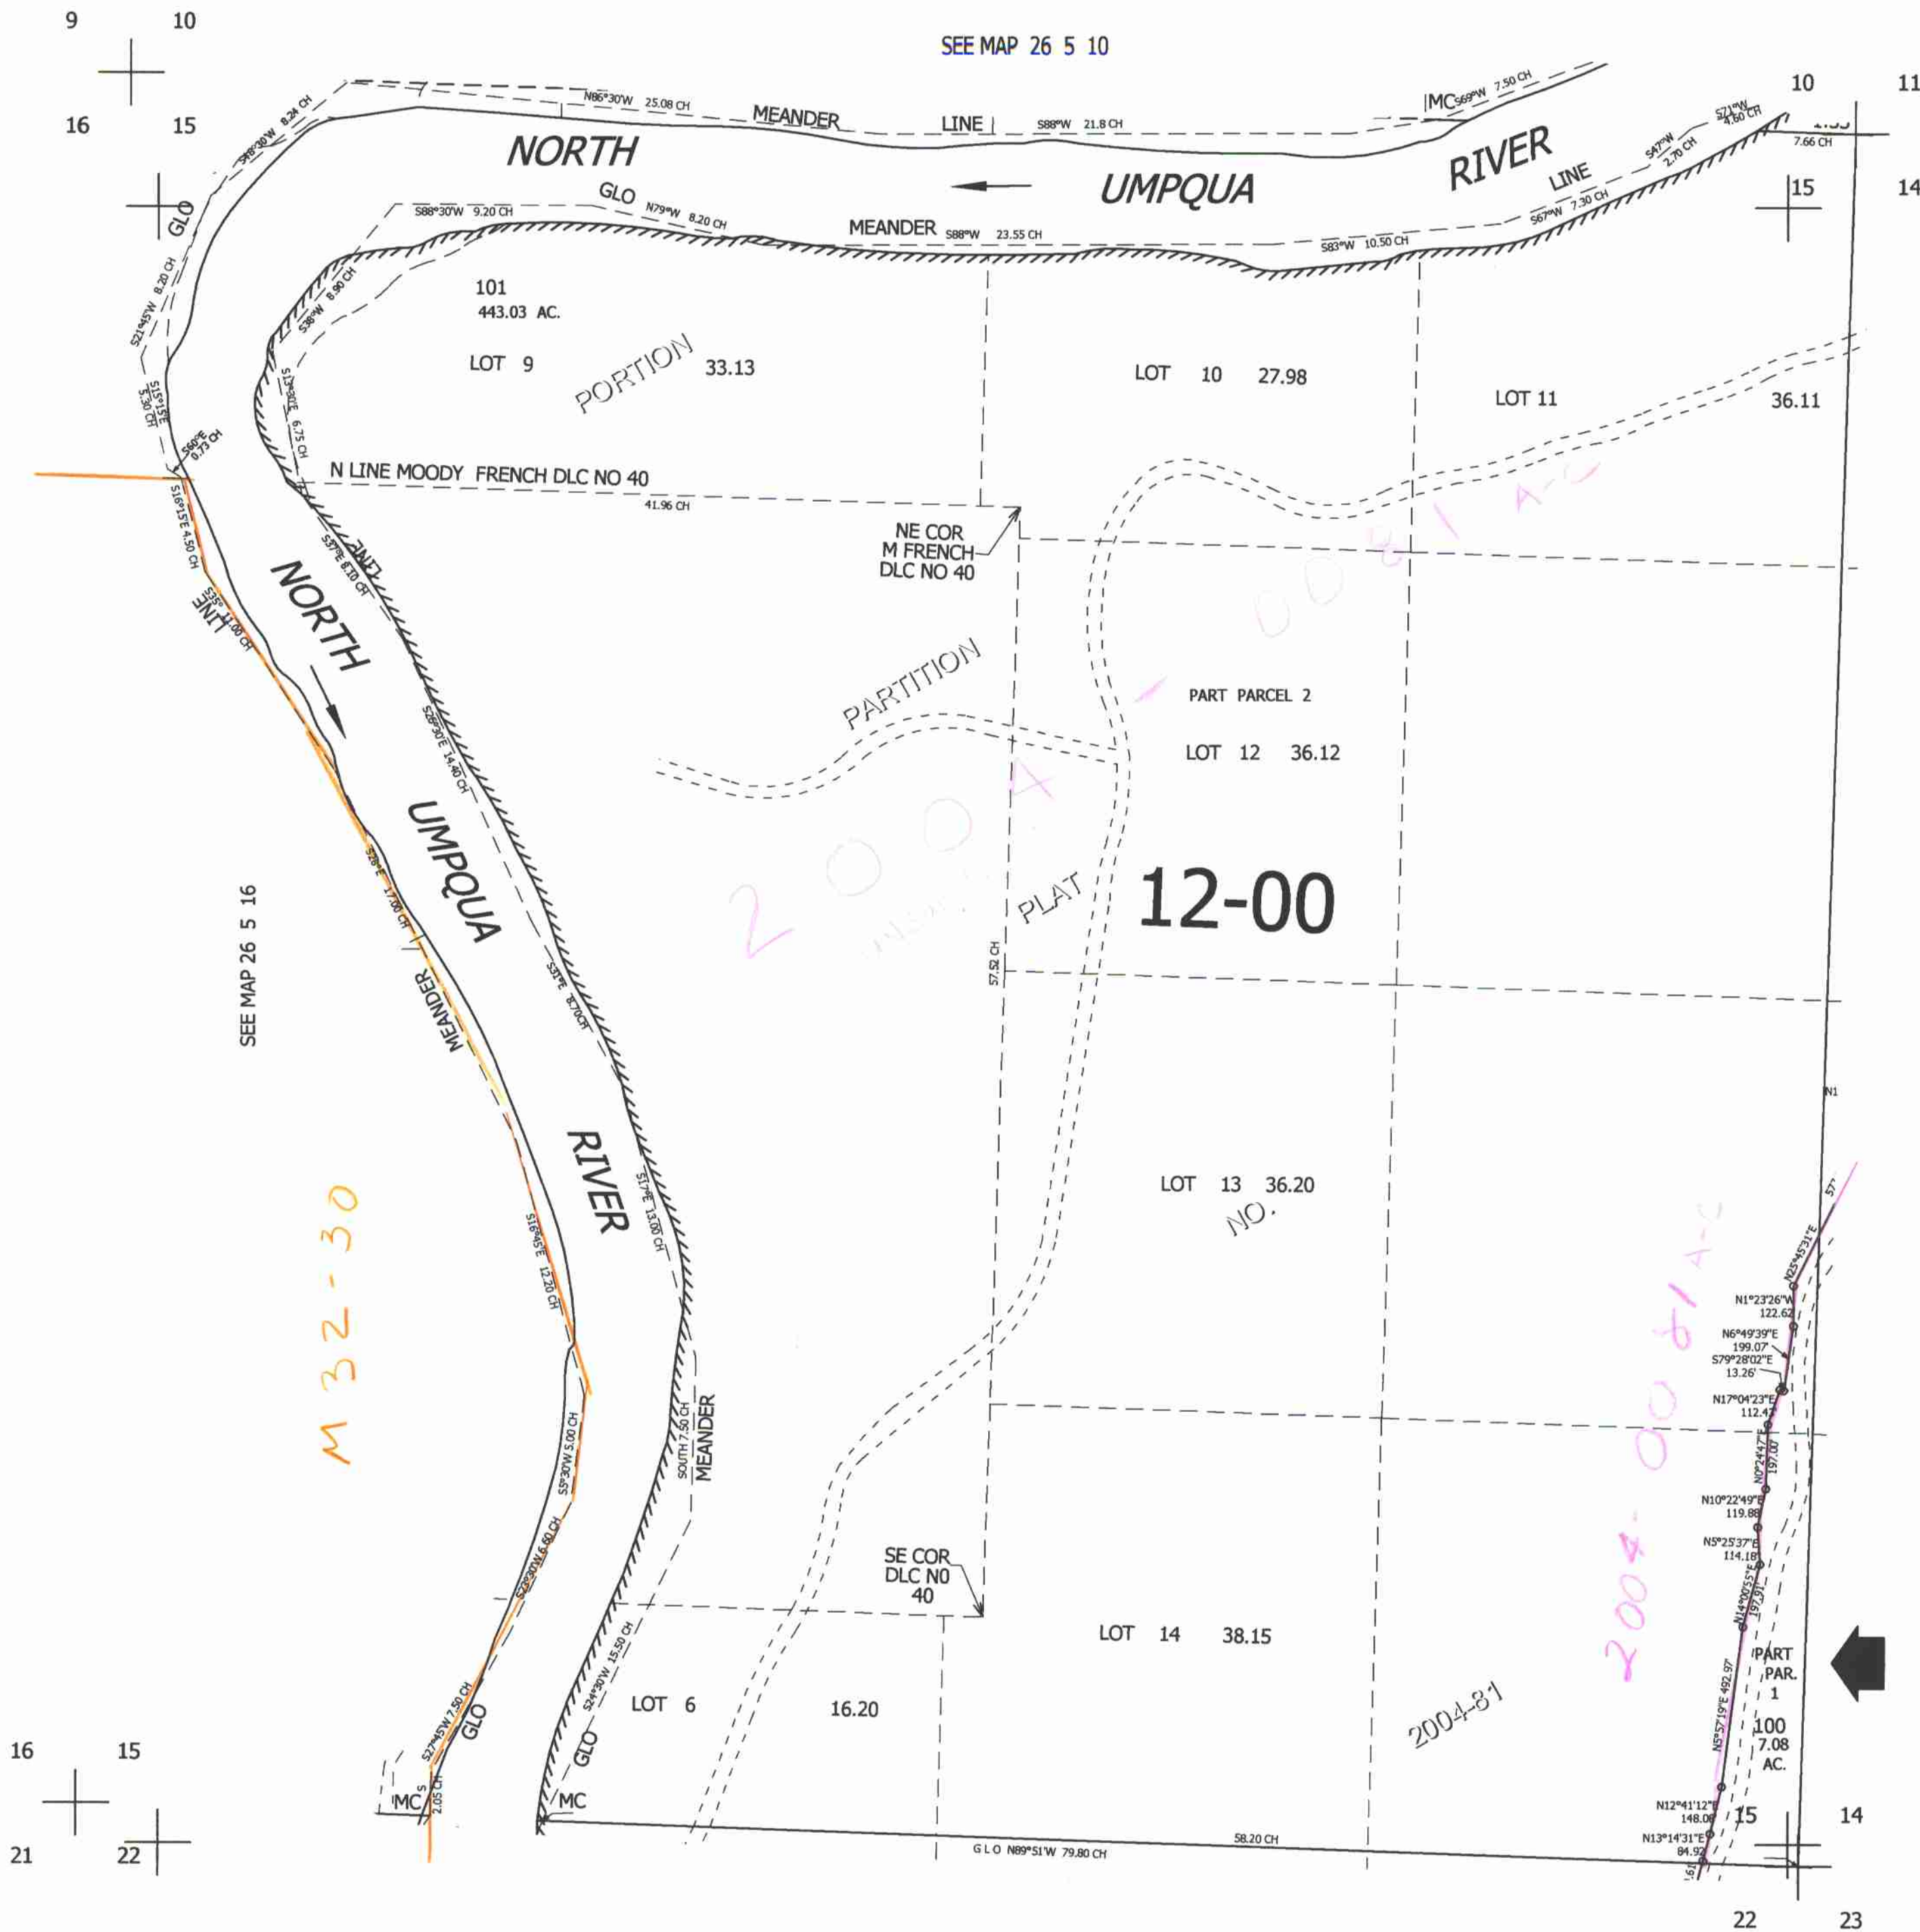

CANCELLED NO'S

SEE MAP 26 5 14

608,000

SEE MAP 26 5 22

4,185,000

26 5 15

cm ✓ 11/07