


NW1/4 NW1/4 SEC.18 T.26S. R.05W. W.M.
DOUGLAS COUNTY

1" = 100'

SEE MAP
2605W07C

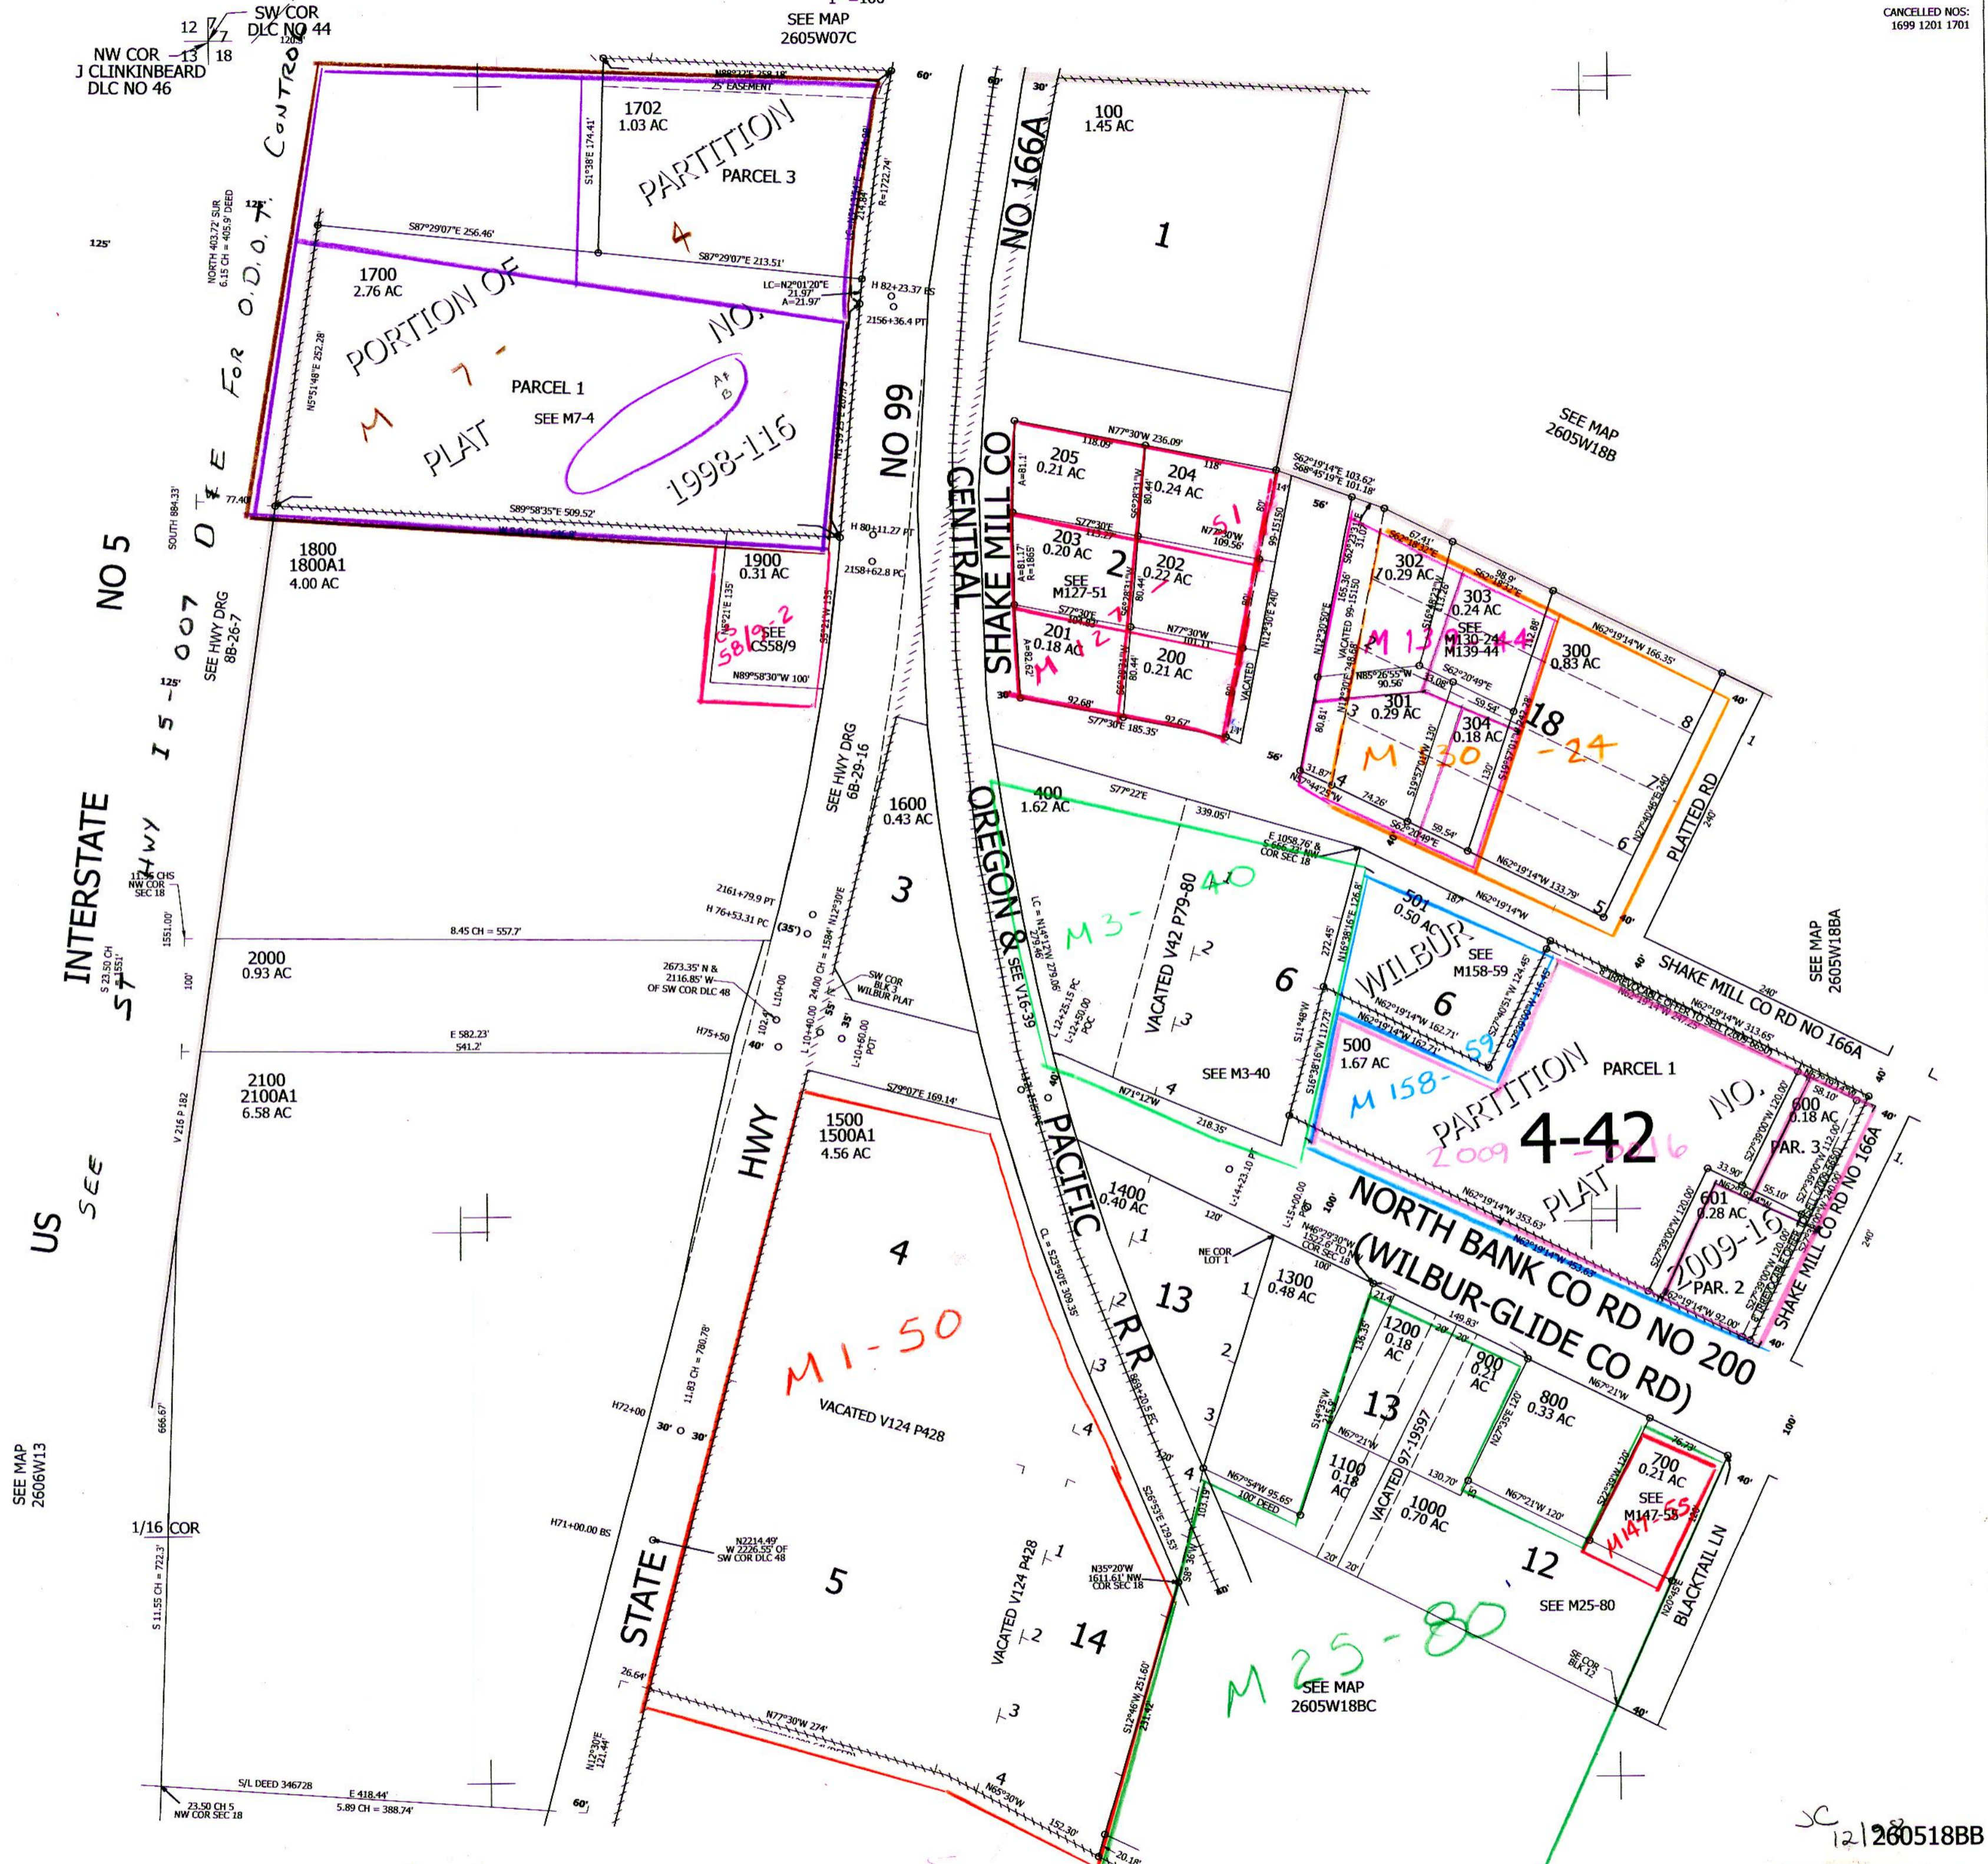

121260518BB