THIS MAP WAS PREPARED FOR ASSESSMENT PURPOSE ONLY

SEC. 23 T.26S. R.5 W W.M.
DOUGLAS COUNTY

1" = 400'

REVISED ON 1-14-02
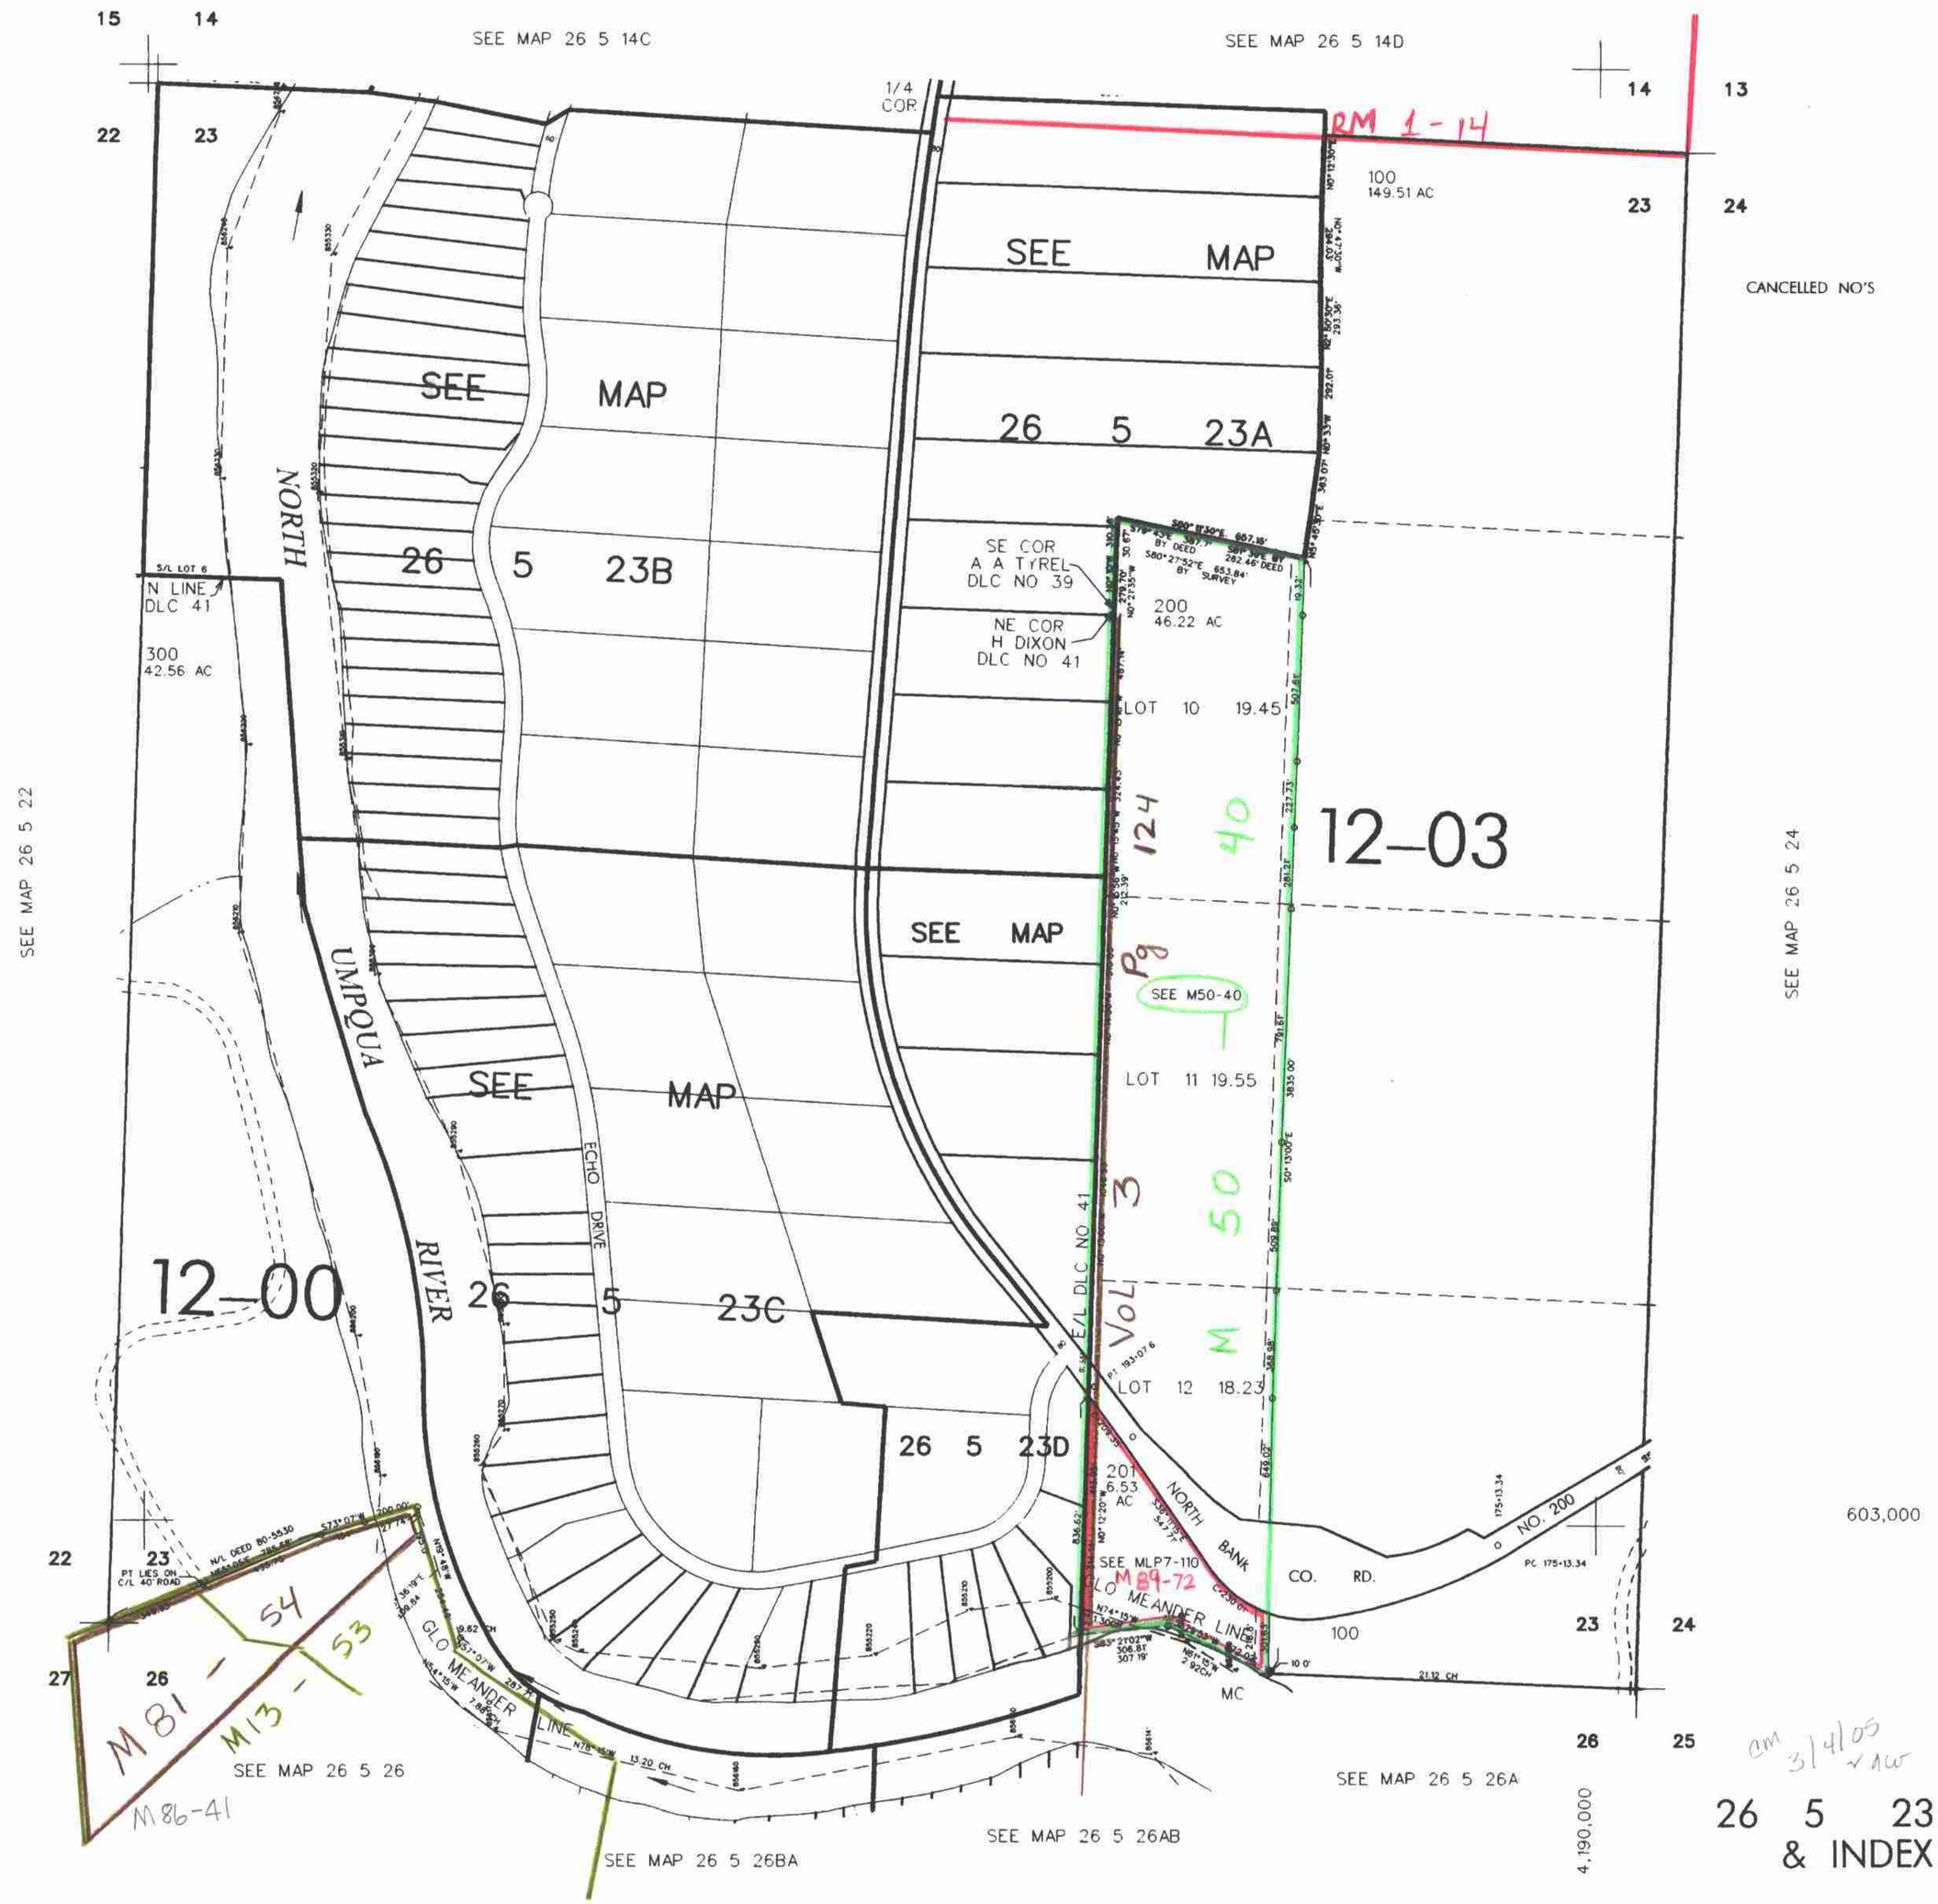
26 5 23 & INDEX