THIS MAP WAS PREPARED FOR ASSESSMENT PURPOSE ONLY.

REVISED ON 4-4-07

26 5 26 & INDEX

SEC.26 T.26S. R.5W. W.M. DOUGLAS COUNTY

1" = 400'

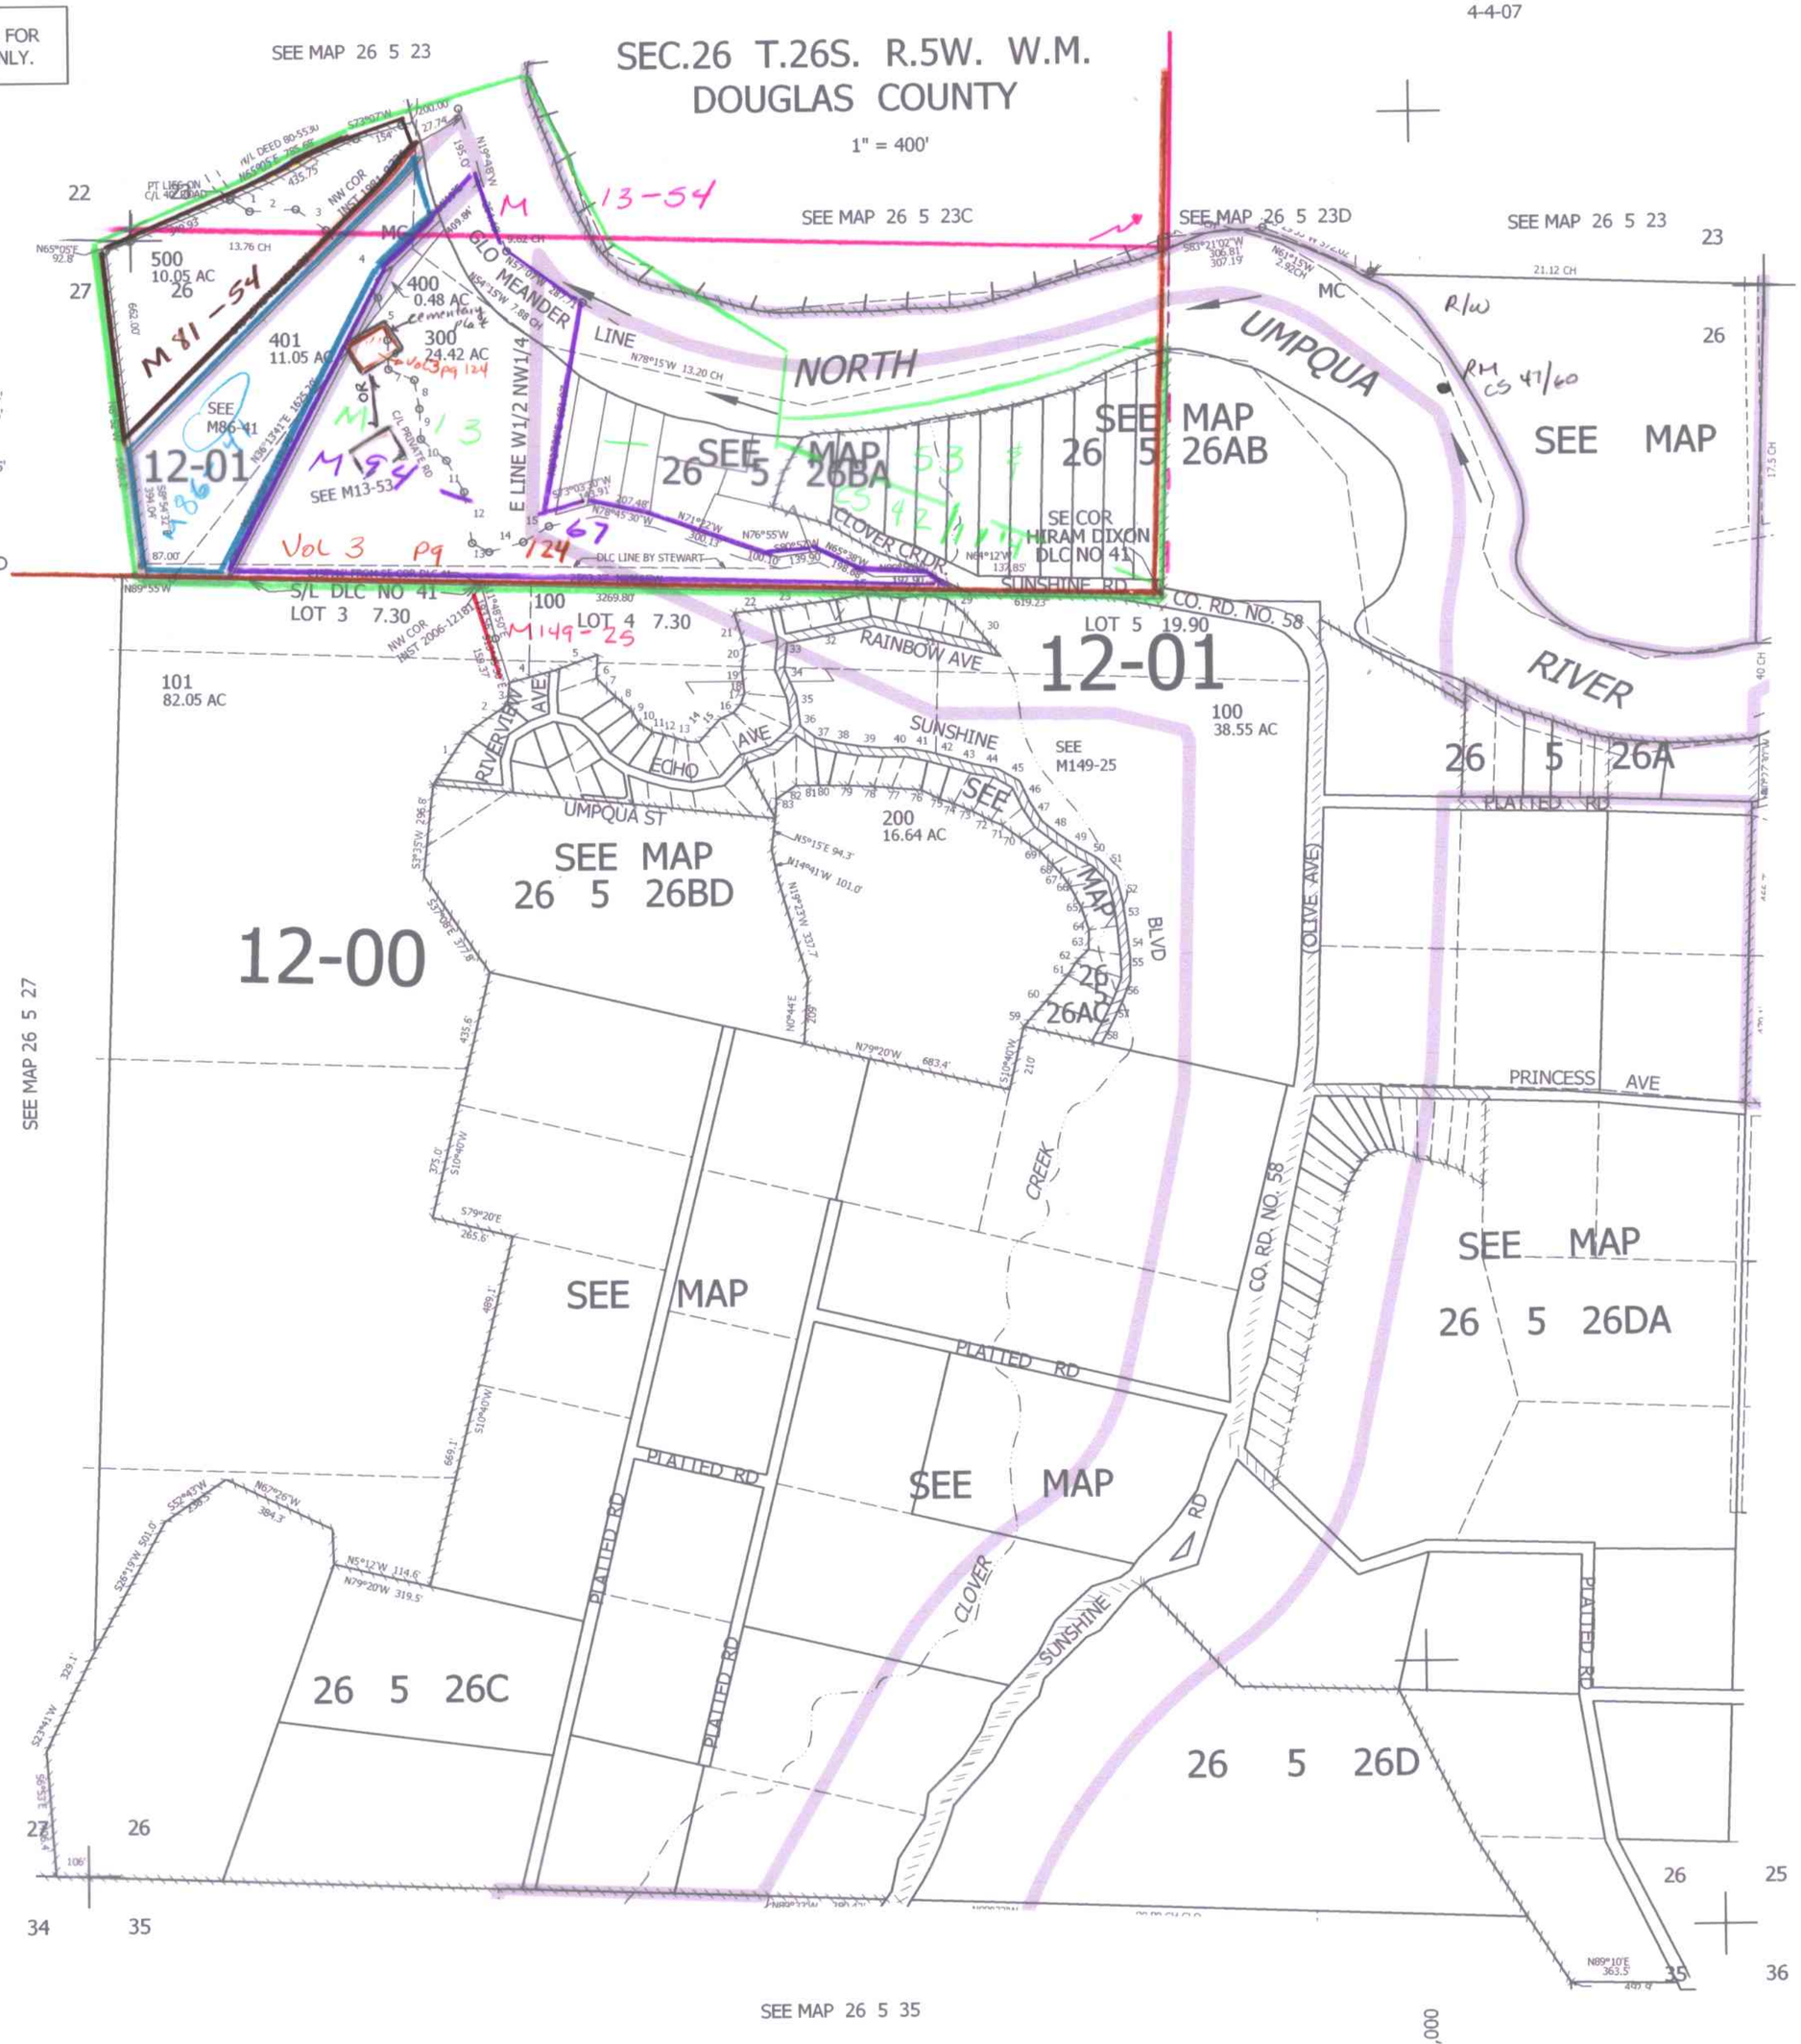

C/L PRIVATE RD

1. S52°27'E 74.44'
2. N85°54'E 142.75'
3. S56°02'30"E 123.65'
4. S39°E 286.19'
5. S13°20'E 137.66'
6. S7°38'E 89.68'
7. S64°48'30"E 91.04'
8. S16°16'E 90.21'
9. S0°42'30"E 102.95'
10. S57°02'E 109.07'
11. S29°05'30"E 114.84'
12. S10°39'30"E 167.36'
13. S65°23'30"E 70.25'
14. N70°21'E 100.05'
15. N51°52'30"E 123.35'

PORTION OF 26 5 26AC, BA, & BD BOUNDARY

1. S30°49'W 147.9'
2. S53°05'W 161.9'
3. S2°35'W 70.5'
4. S72°56'W 150'
5. S68°09'W 150'
6. N1°29'E 75.1'
7. N47°11'W 89'
8. N52°51'W 66.5'
9. N31°41'W 49.3'
10. N61°21'W 52'
11. N79°49"W 38.6'
12. N75°15'W 38.6'
13. N74°43'W 38.6'
14. N87°30'W 38.6'
15. S40°18'W 99.9'
16. S62°52'W 46.6'
17. S31°59'W 31.2'
18. S22°15'W 41.9'
19. S11°35'E 72.2'
20. S6°23'W 81.8'
21. S19°52'E 114.1'
22. S81°55'W 135'
23. S80°03'W 100.4'
24. S80°03'W 100.4'
25. S77°11'W 100'
26. N84°17'W 114.4'
27. S81°31'W 81.6'
28. N78°29'W 75'
29. N51°56'W 67.2'
30. N42°16'W 152.5'
31. S78°28'E 408'
32. N77°10'E 300'
33. N3°35'E 100'
34. N26°43'W 100'
35. N10°W 100'
36. S55°48'E 75'
37. S79°30'E 75'
38. S82°39'E 75'
39. S87°21'E 75'
40. N88°08'E 75'
41. S79°59'E 75'
42. S77°40'E 75'
43. S75°35'E 75'
44. S81°23'E 75'
45. S63°15'E 75'
46. S29°02'E 75'
47. S34°22'E 75'
48. S54°47'E 75'
49. S57°26'E 75'
50. S62°39'E 75'
51. S46°48'E 75'
52. S17°25'E 75'
53. S10°45'E 75'
54. S8°27'E 100'
55. S4°33'E 75'
56. S18°24'W 75'
57. S24°05'W 80'
58. S26°19'W 69.7'
59. N39°26'E 108.5'
60. N38°18'E 107.5'
61. N28°12'E 46.5'
62. N42°48'E 61'
63. N2°13'W 63.9'
64. N22°23'W 74.8'
65. N29°59'W 79'
66. N37°37'W 48.6'
67. N45°19'W 40.2'
68. N46°12'W 59.9'
69. N58°02'W 77.1'
70. N55°24'W 75.7'
71. N74°02'W 38.8'
72. N63°57'W 64.7'
73. N70°05'W 66.9'
74. N73°16'W 48.5'
75. N65°54'W 67.9'
76. N87°22'W 98.7'
77. N86°51'W 55.8'
78. N89°41'W 83'
79. S87°55'W 62.9'
80. S88°22'W 30.9'
81. S88°28'W 75.6'
82. S53°48'W 76.5'
83. S0°35'E 64.6'

26 5 26 & INDEX