


THIS MAP WAS PREPARED FOR ASSESSMENT PURPOSE ONLY.

SECTION 28 T.26S. R.5W. W.M. DOUGLAS COUNTY

1"=400'

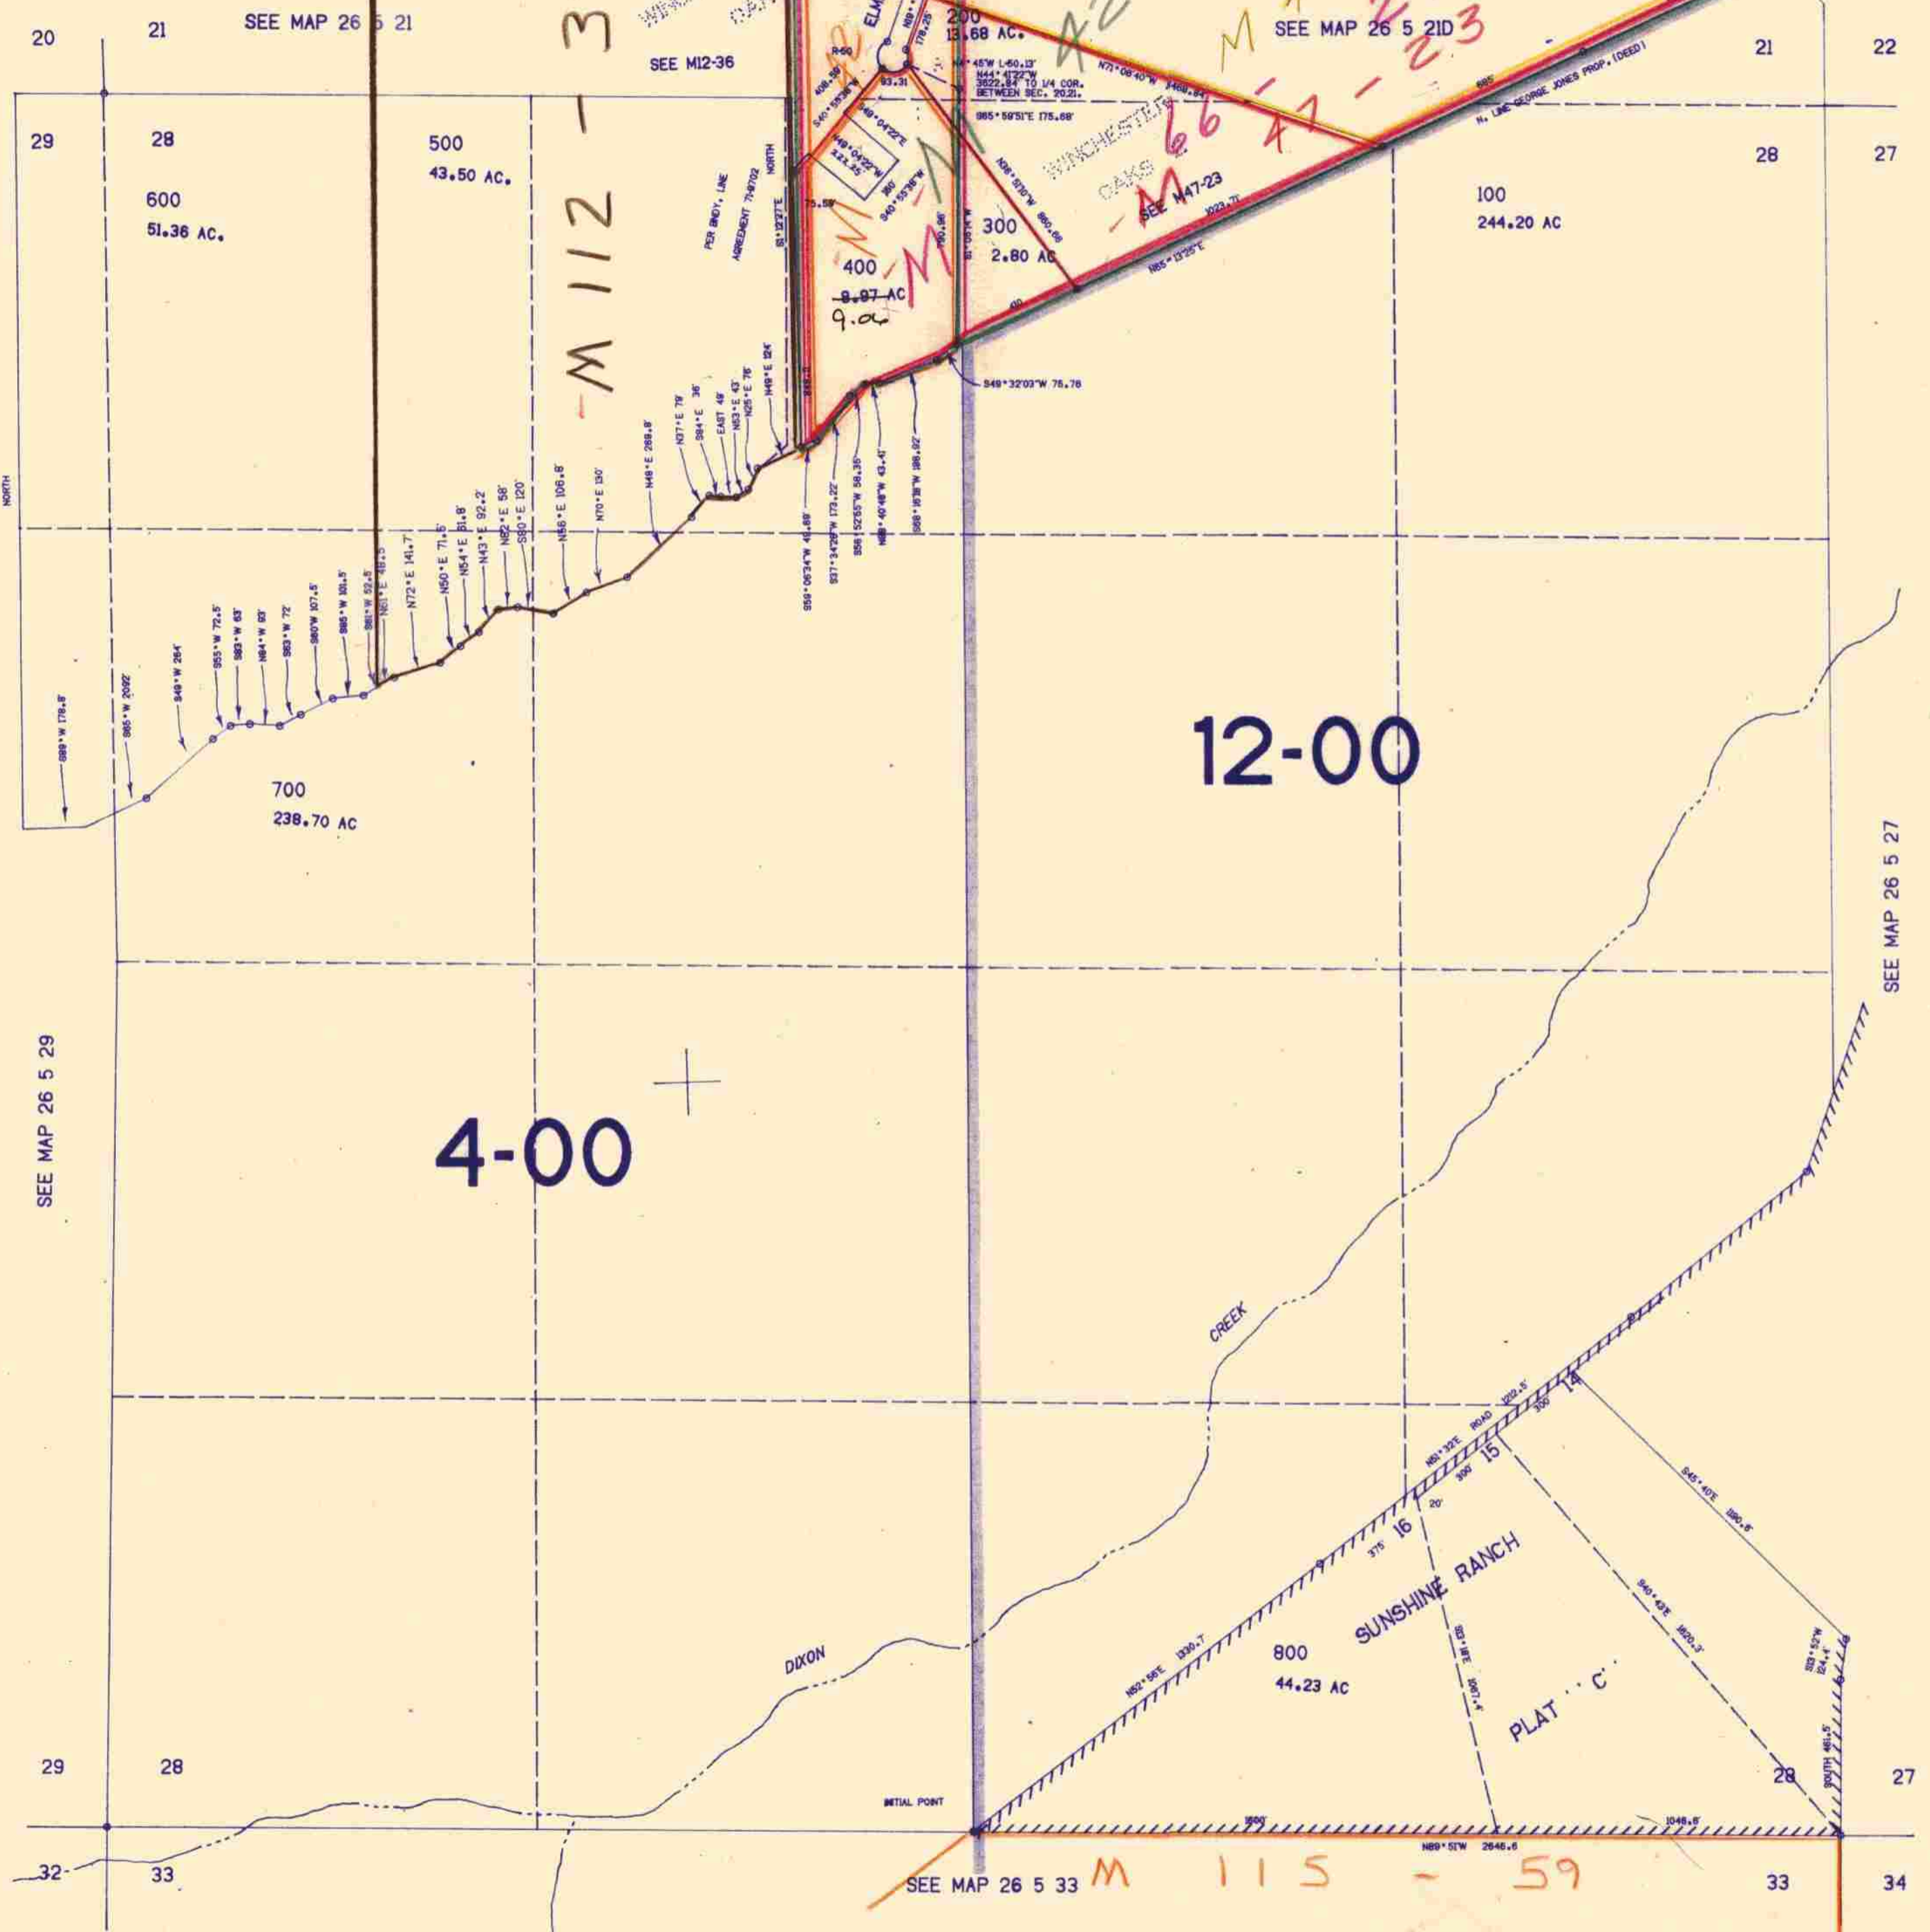

600.000

10/18/21

CONTROL LAYOUT TRACED CHECKED

1.255.000