

THIS MAP WAS PREPARED FOR ASSESSMENT PURPOSE ONLY.

NW1/4 SW1/4 SEC.30 T.26S. R.5W. W.M.  
DOUGLAS COUNTY

REVISED ON  
1-31-17

26 5 30CB

1" = 100'

CANCELLED NO'S  
401 301 101  
1300 102 103  
104 105 106  
107


SEE MAP 26 5 30BD

1/16 COR

SEE MAP 26 5 30


600,000

4,165,000

SEE MAP 26 5 30CC

26 5 30CB

4/03 JP

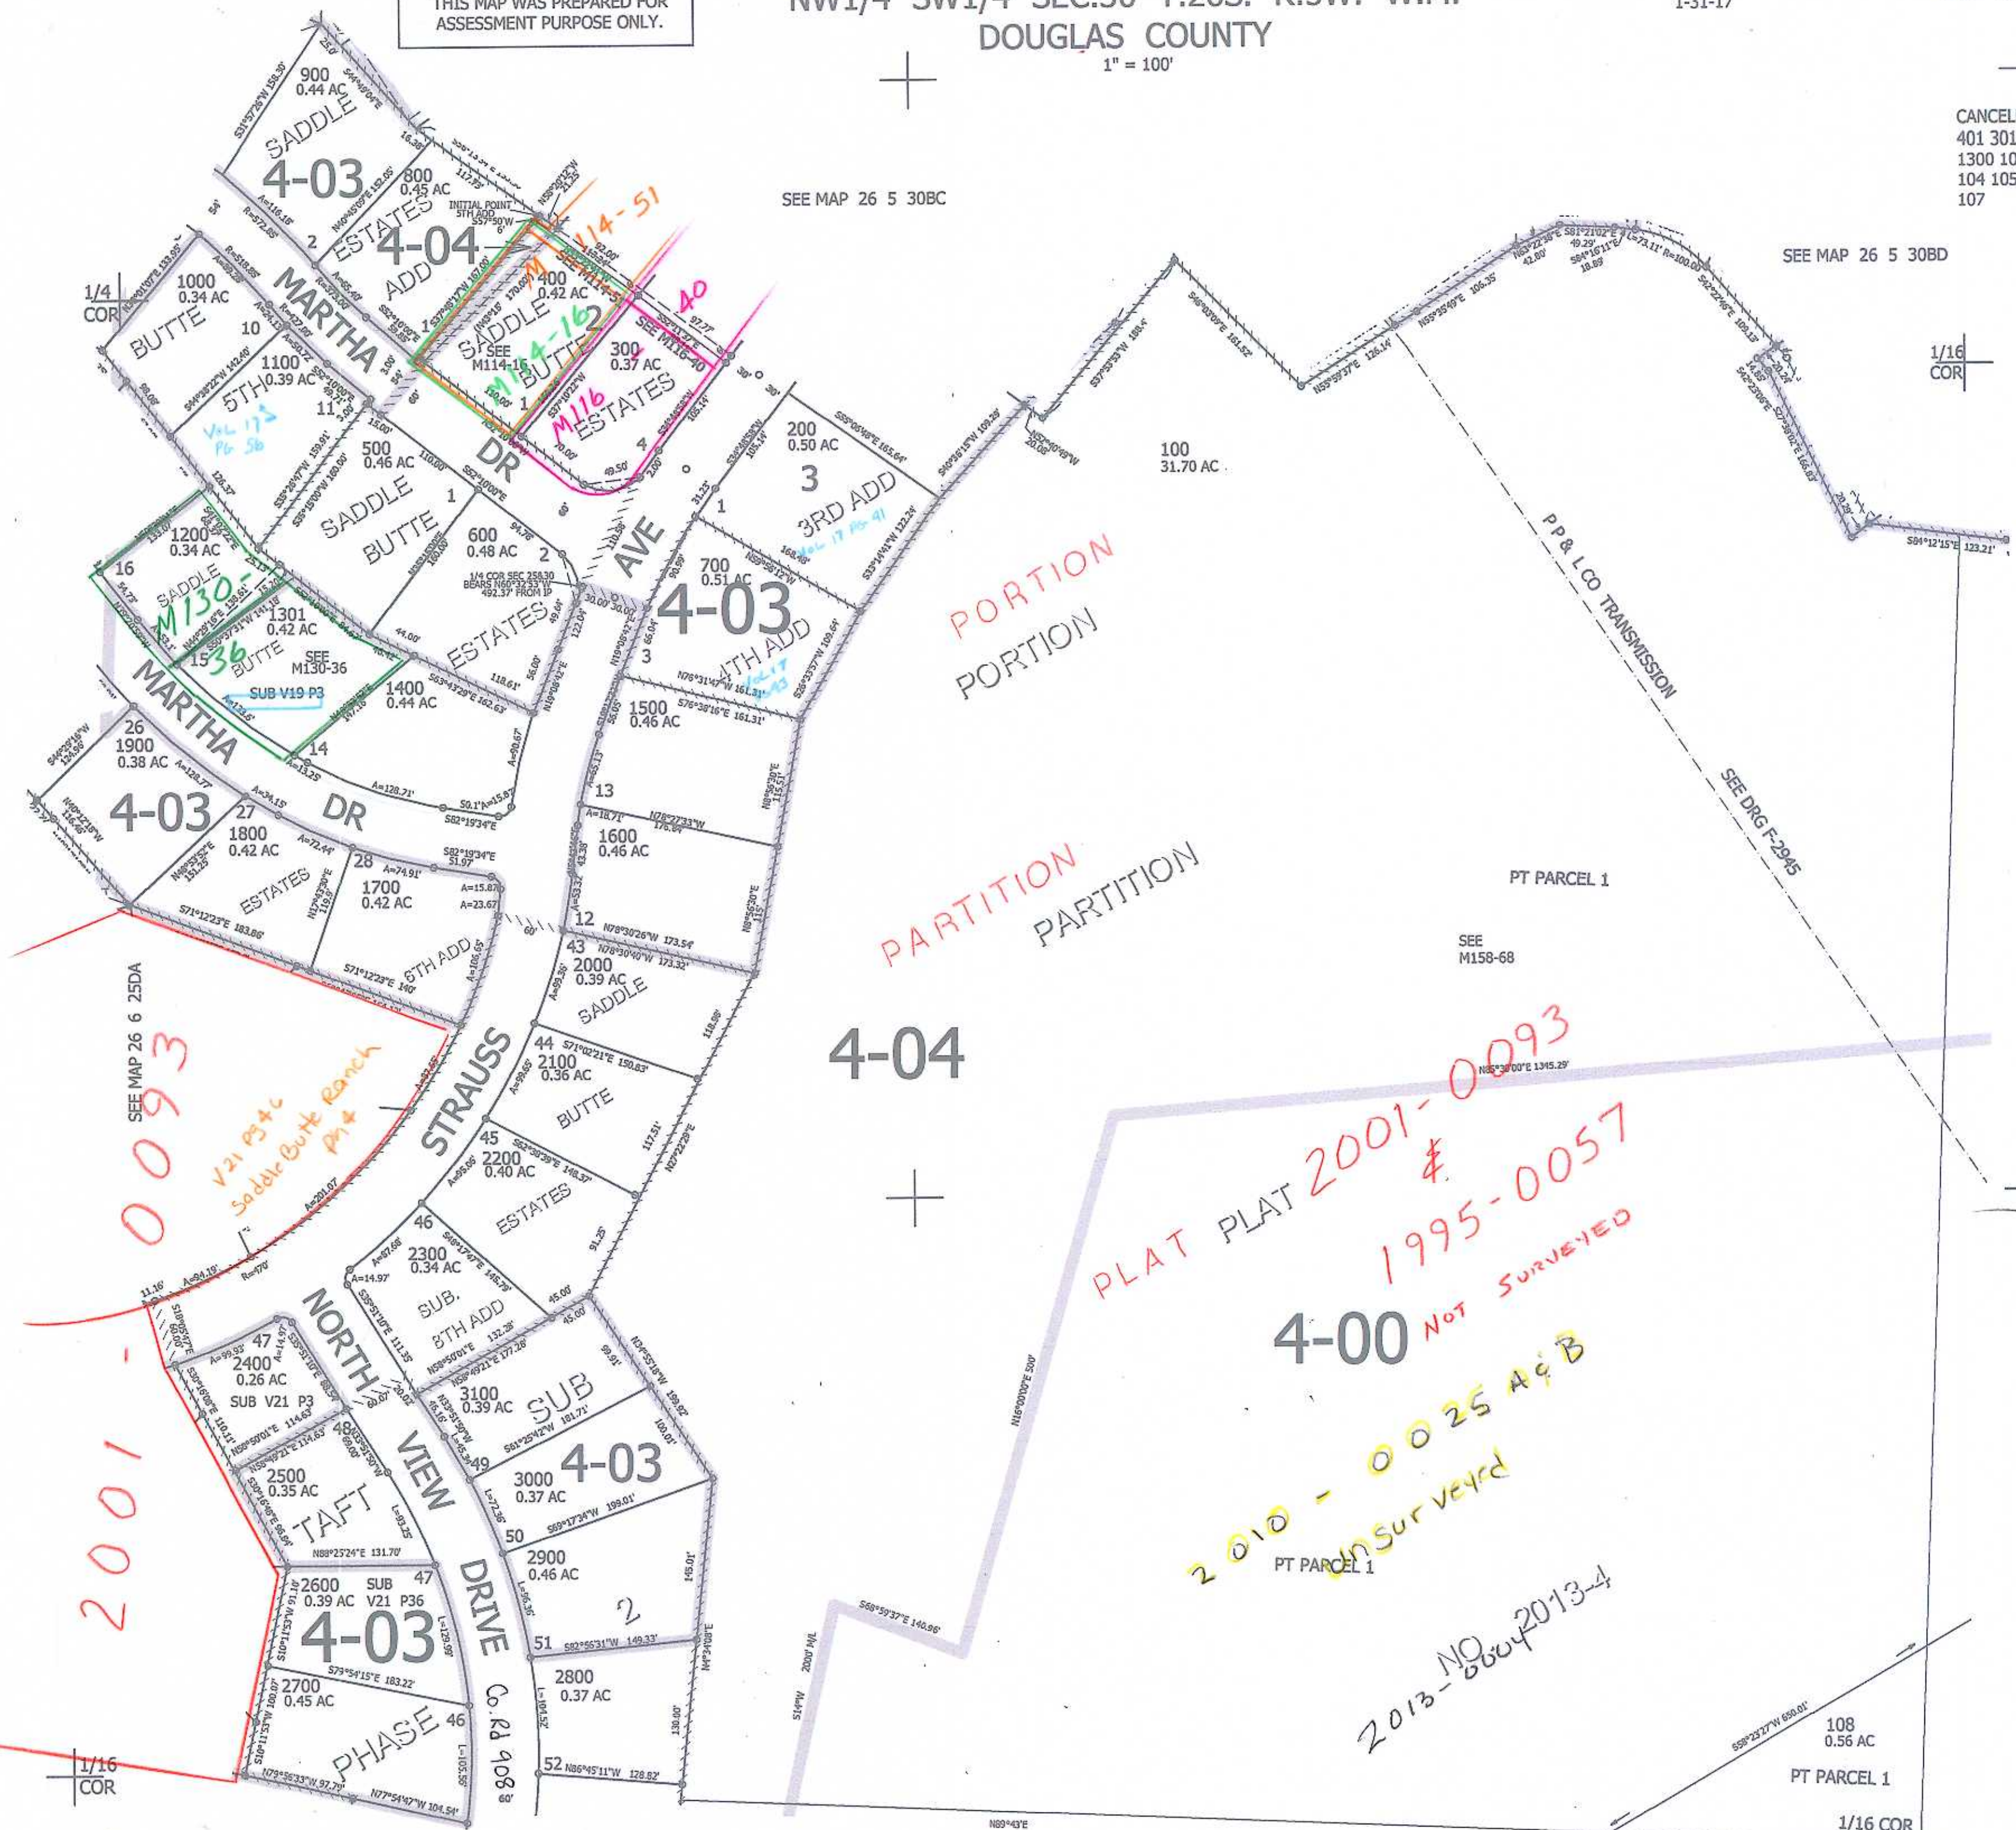

SEE MAP 26 6 25DA  
2001-0093

V21 P3+6  
Saddle Butte Ranch  
P1+2

PLAT 2001-0093  
PLAT 1995-0057  
4-00 NOT SURVEYED

2010-0025 A & B  
PT PARCEL 1  
NOT SURVEYED

2013-0004 2013-4