


THIS MAP WAS PREPARED FOR ASSESSMENT PURPOSE ONLY.

NW1/4 NW1/4 SEC.31 T.26S. R.5W. W.M.  
DOUGLAS COUNTY  
1" = 100'

26 5 31BB

REVISED ON  
7-12-10

CANCELLED NO'S  
200 100

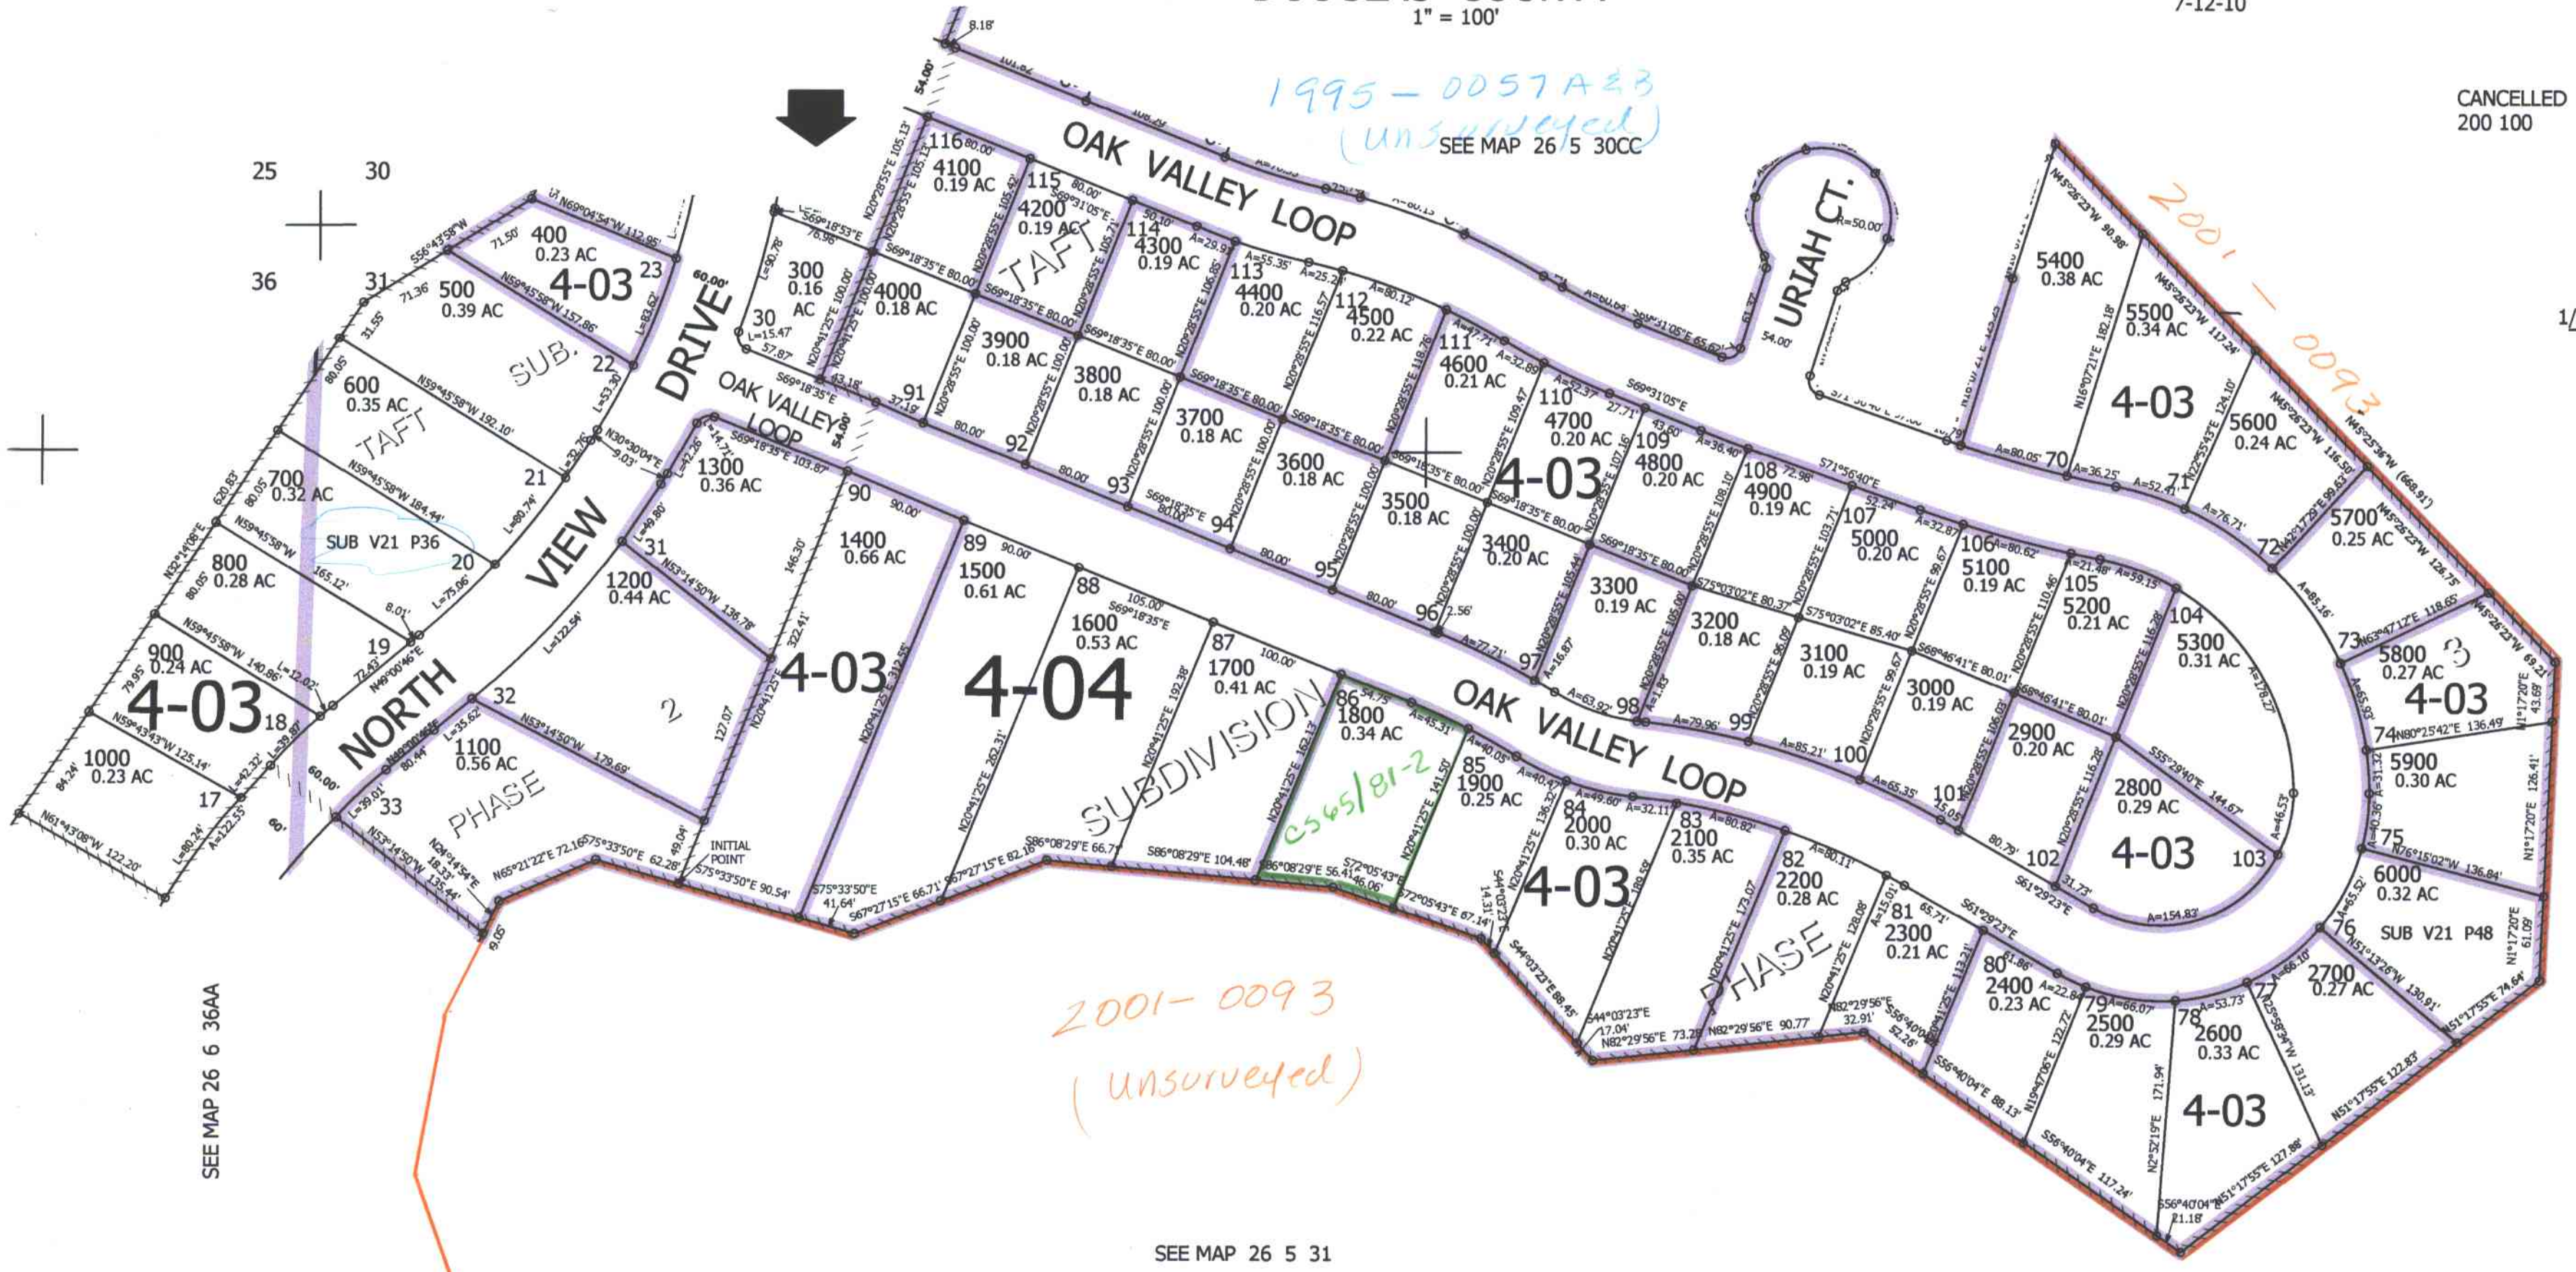

1/16 COR

SEE MAP 26 5 31

SEE MAP 26 6 36AA

SEE MAP 26 5 31

SE COR JOHN AKIN DLC NO 53  
 SW COR JOHN AKIN DLC NO 51  
 NE COR JOHN AKIN DLC NO 64  
 NW COR WILLIAM J. MARTIN DLC NO 50

1/16 COR

597,000

1/16 COR

4,164,000

26 5 31BB