THIS MAP WAS PREPARED FOR ASSESSMENT PURPOSE ONLY

SEC. 36 T.26S. R.5 W W.M.
DOUGLAS COUNTY

1" = 400 '

REVISED ON

26 5 36

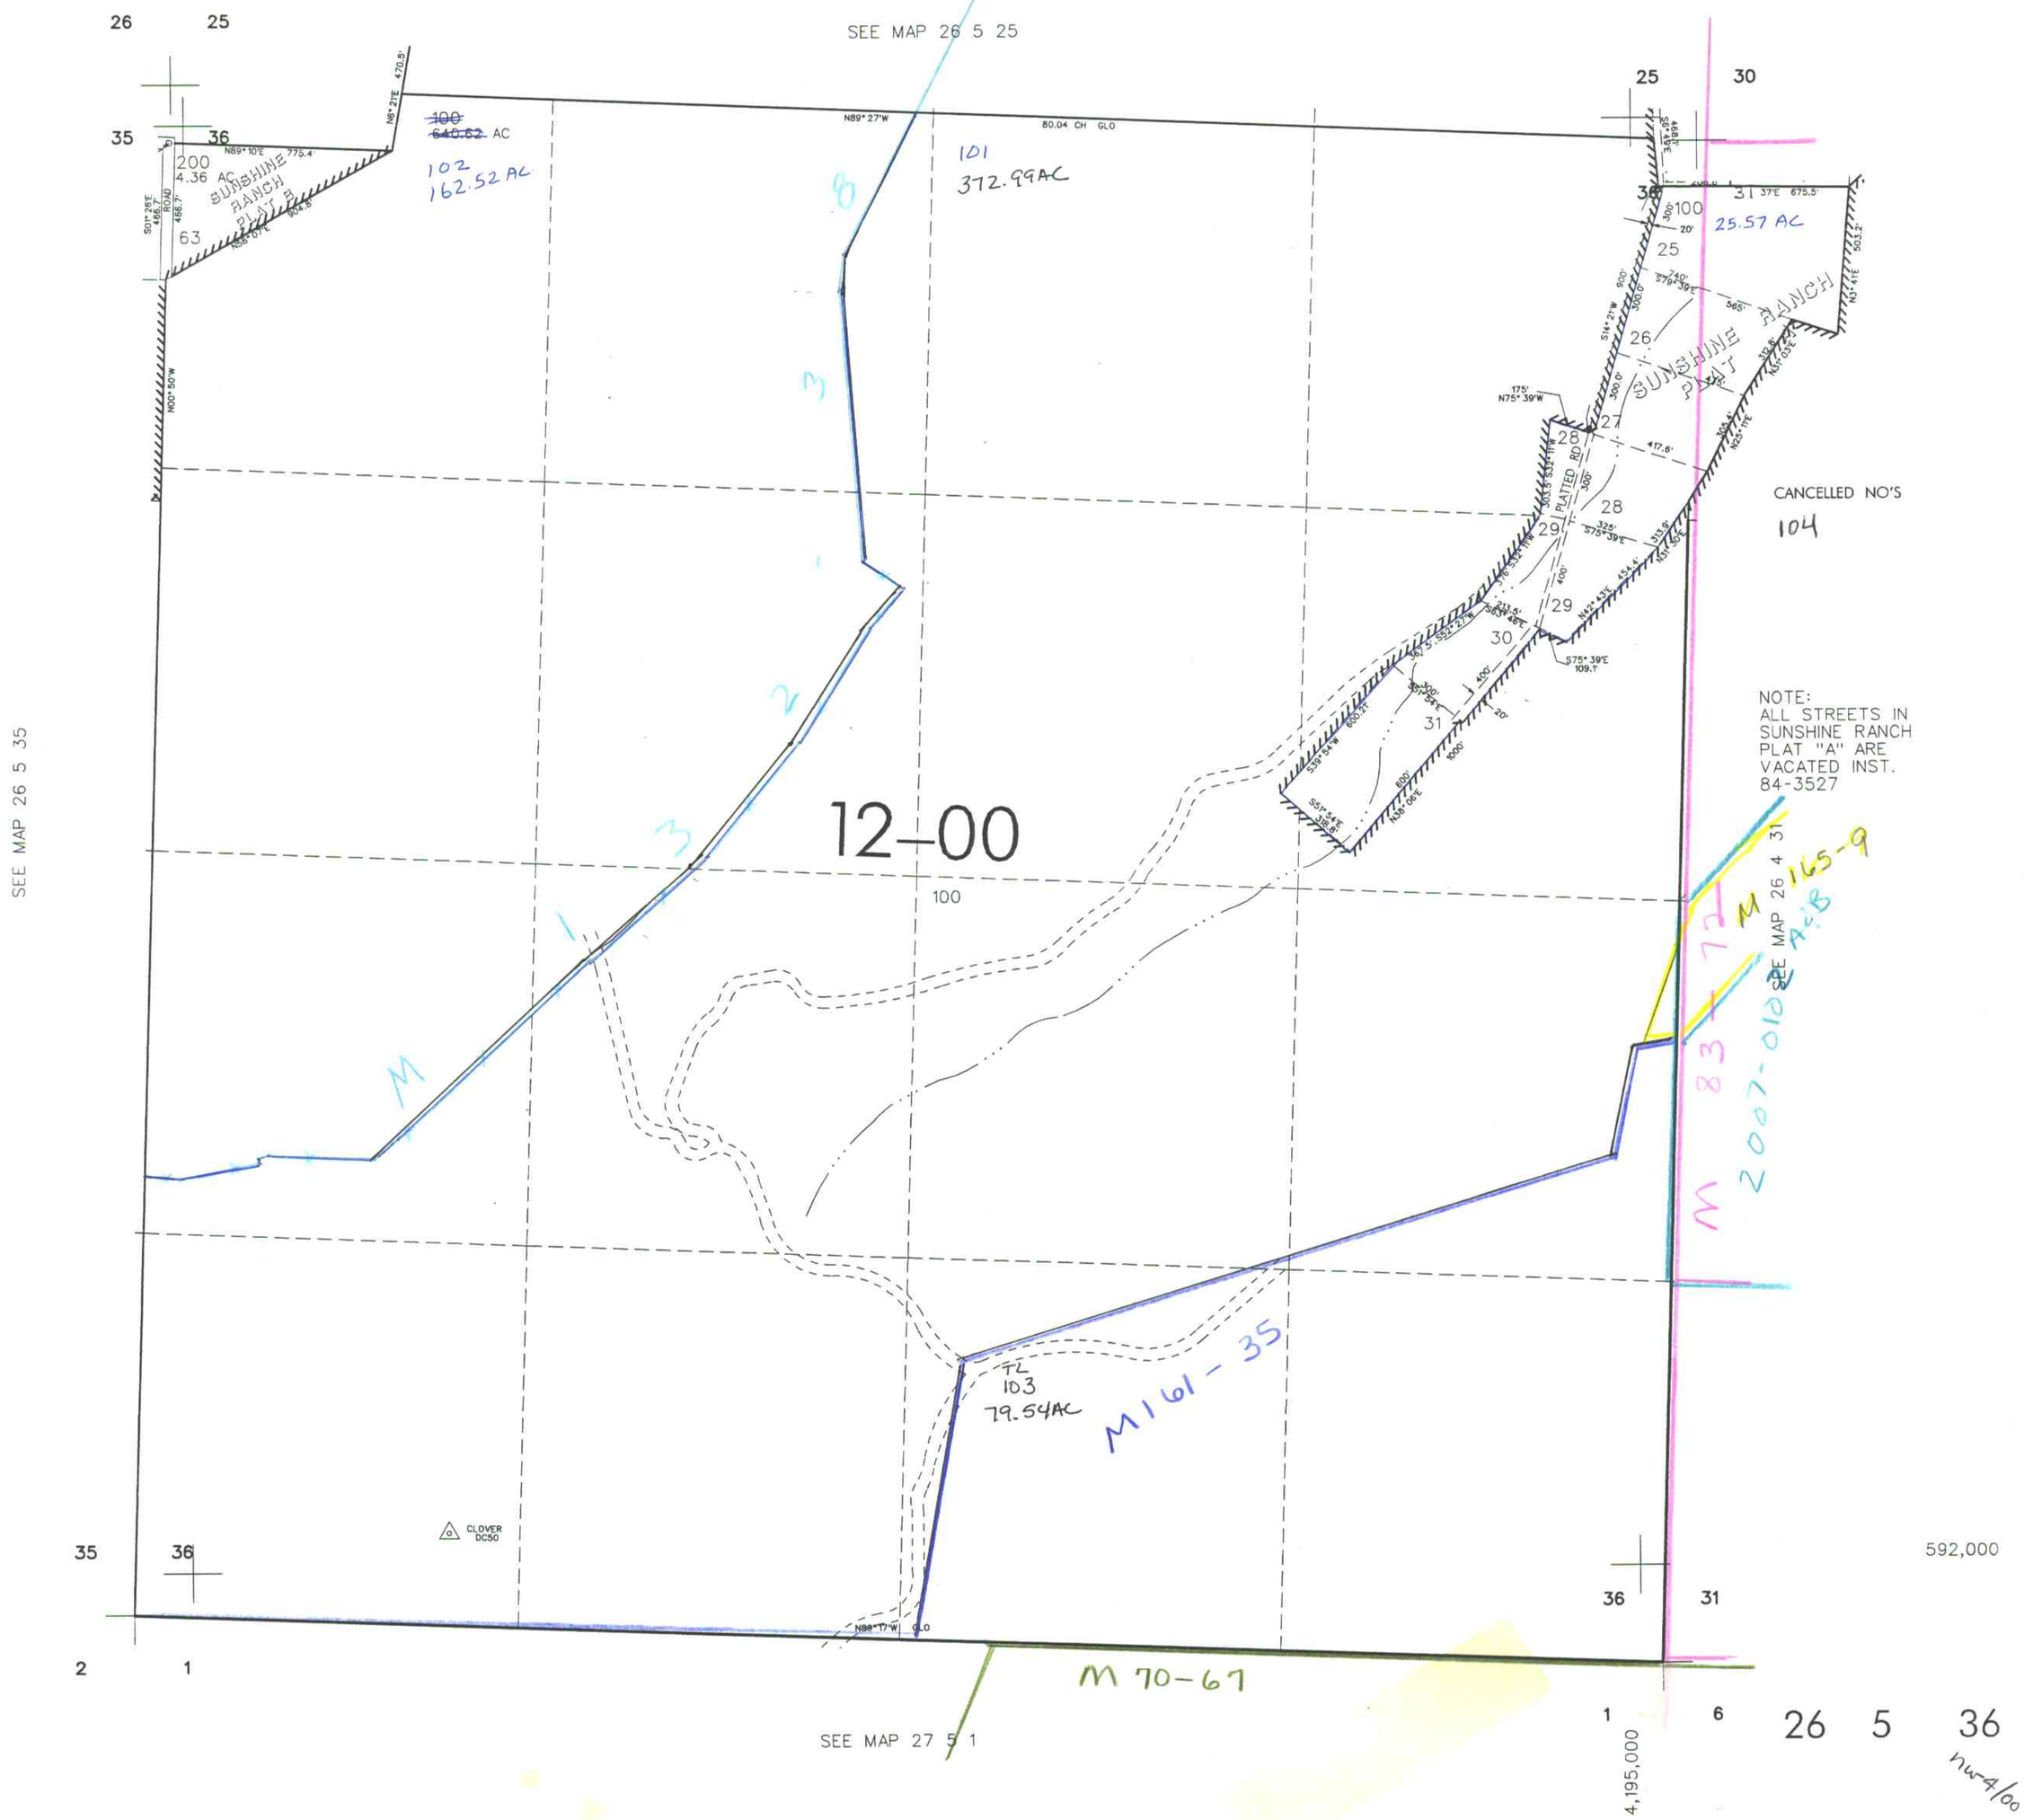

26 5 36

nw-4/00