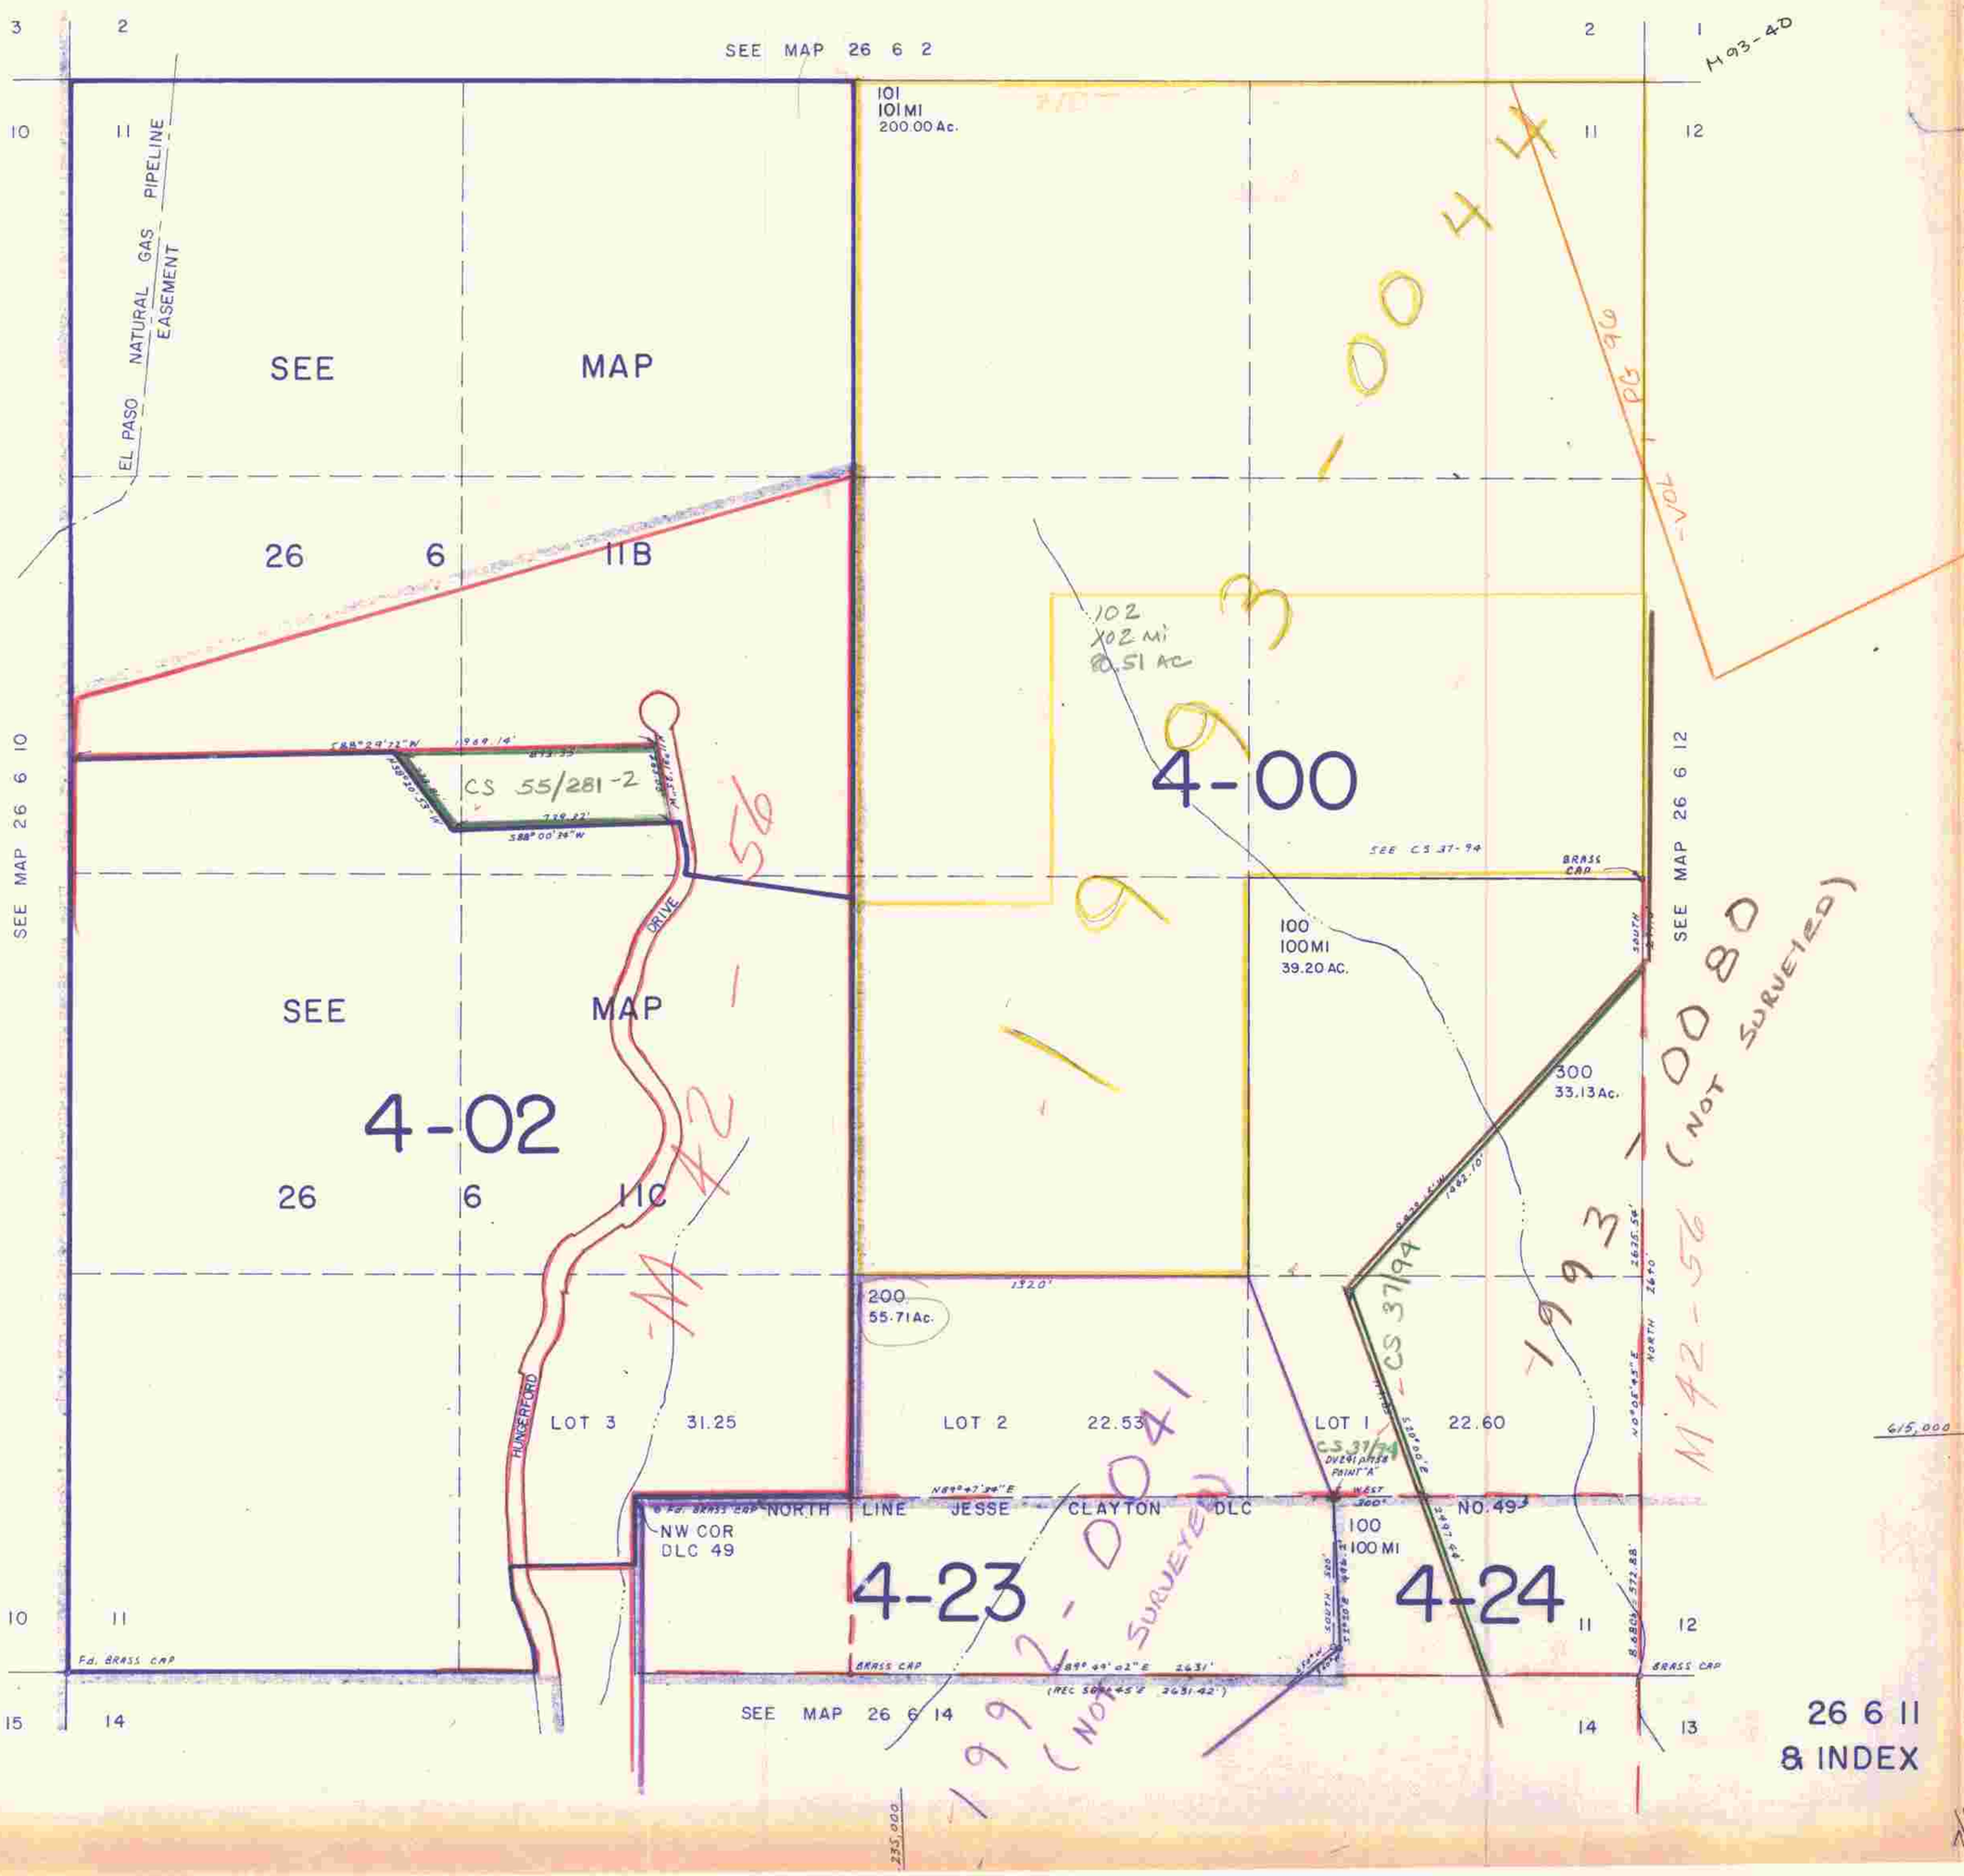SECTION 11 T26S R6W WM
DOUGLAS COUNTY
1" = 400'