


NW1/4 SEC. 11 T.26S. R.6W. WM.
DOUGLAS COUNTY

1" = 200'

SEE MAP 26 6 2

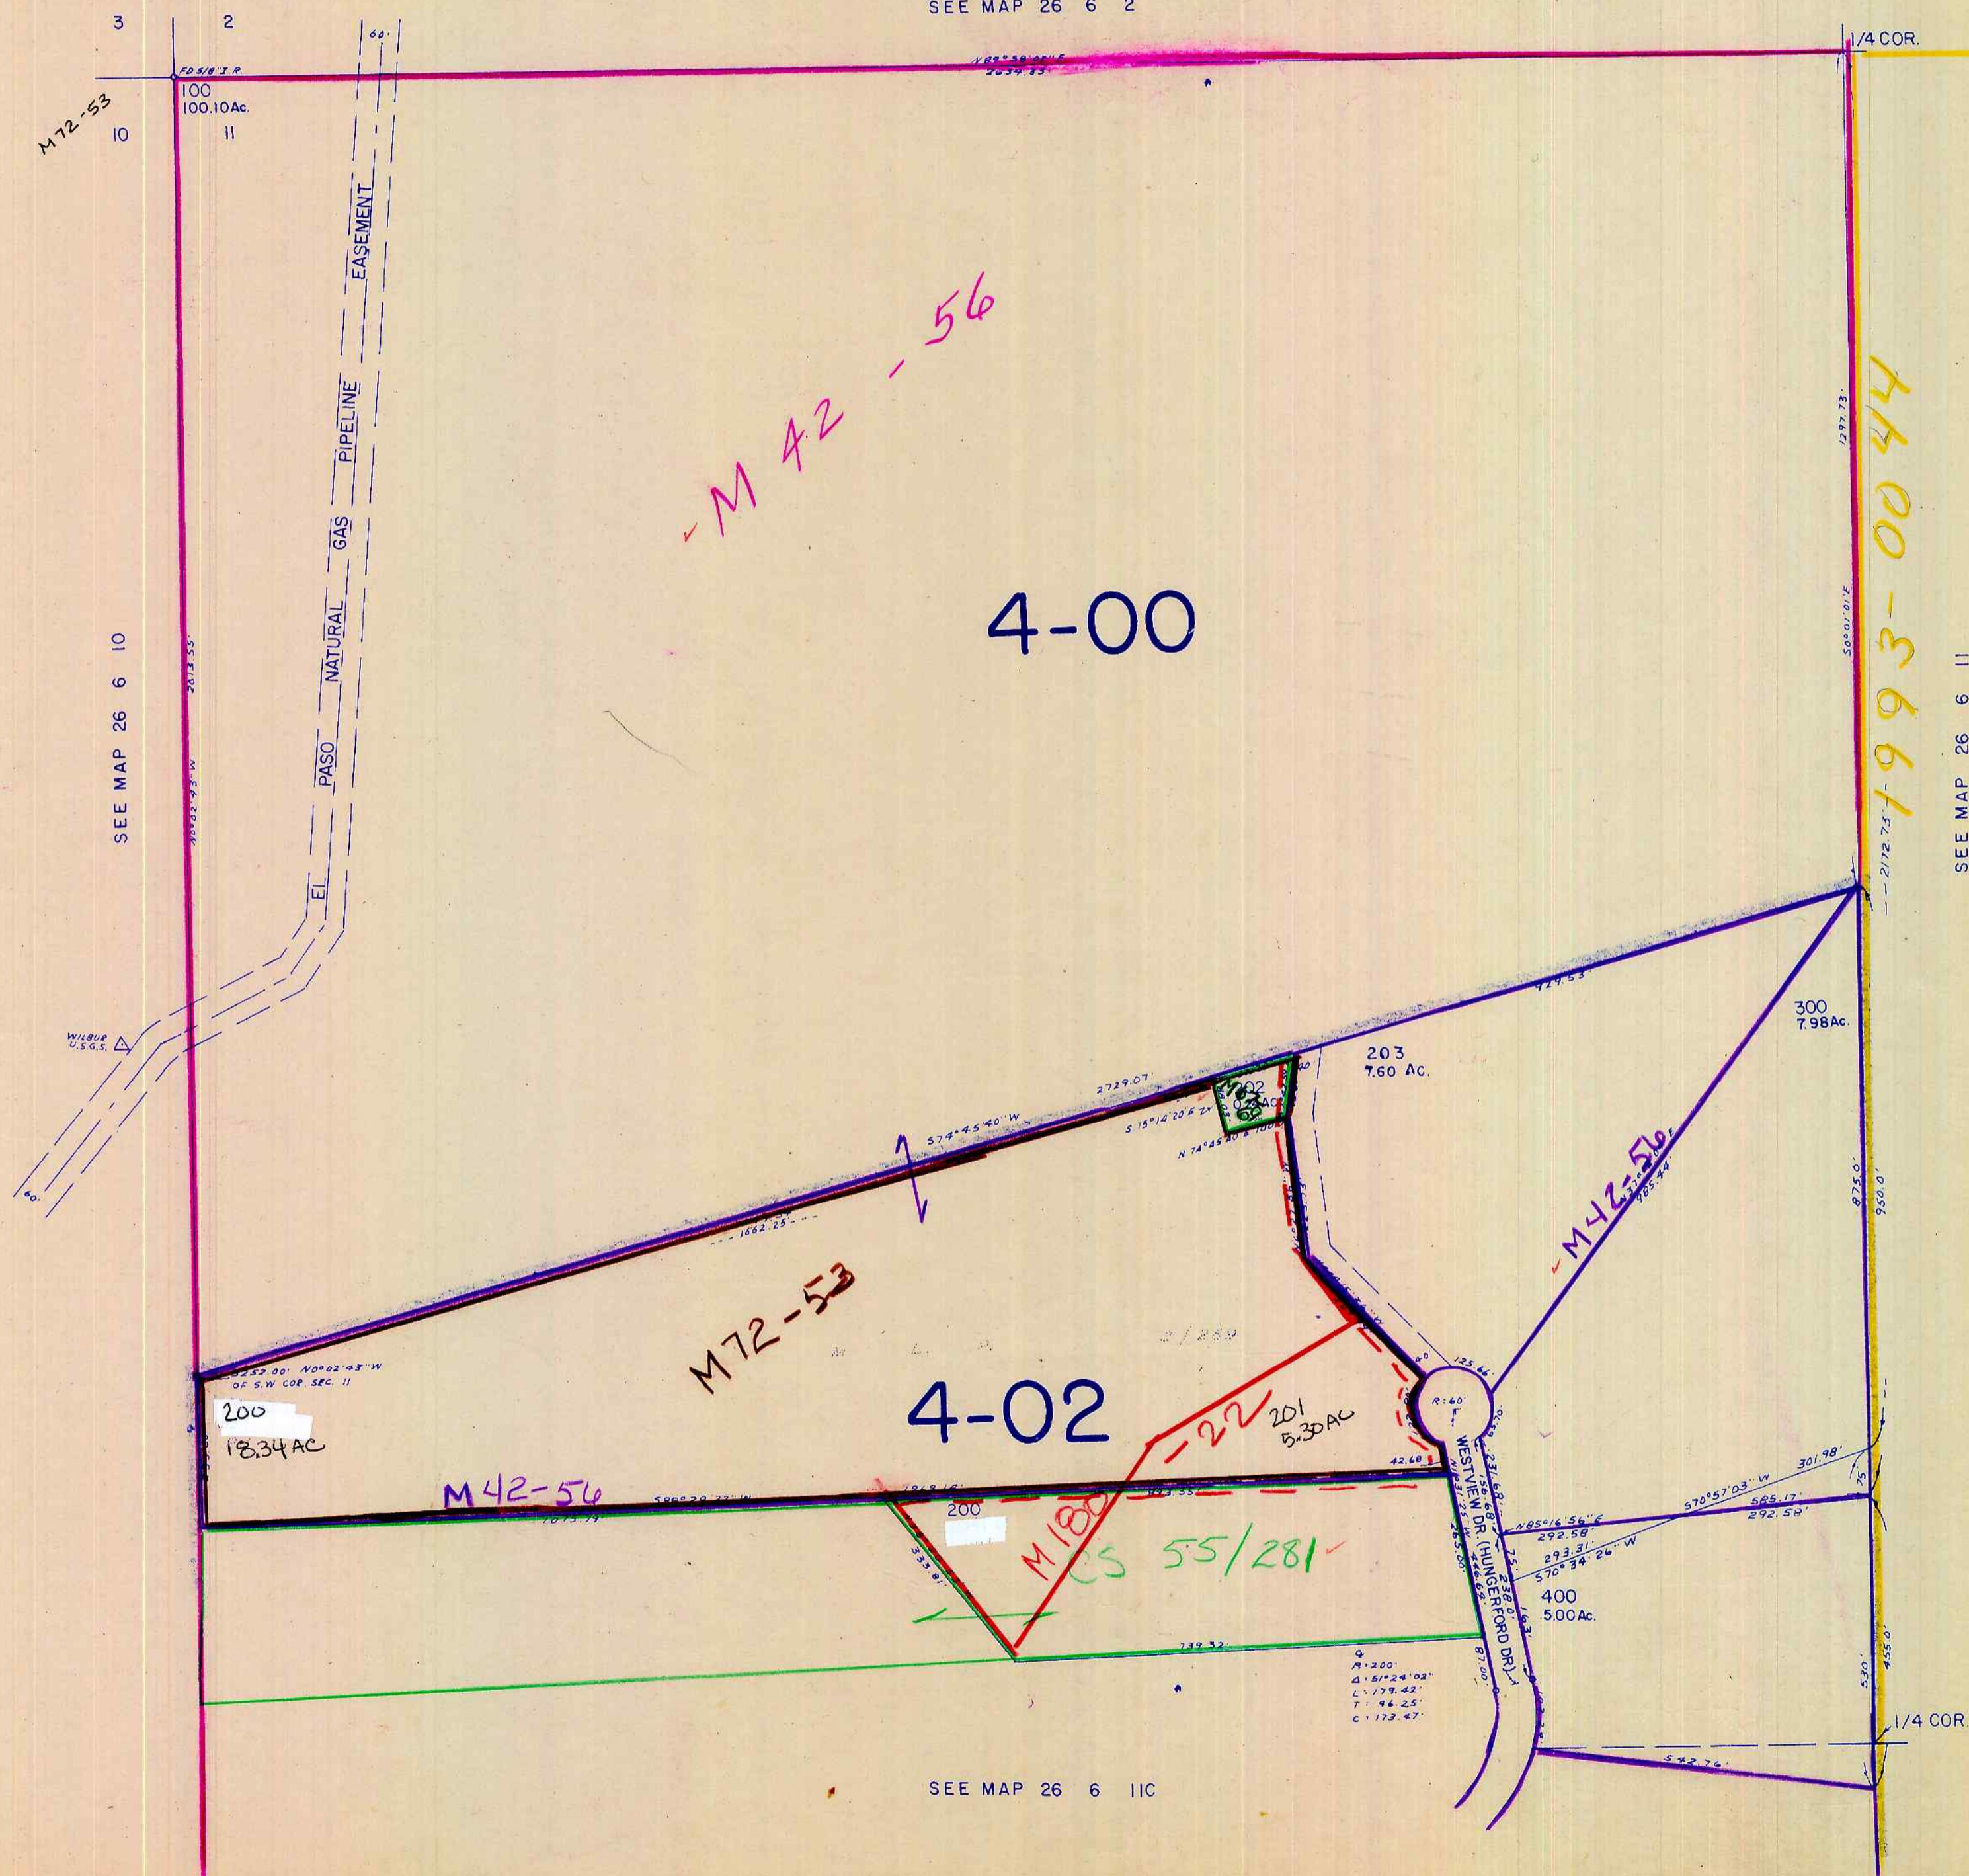

SEE MAP 26 6 10

SEE MAP 26 6 11

SEE MAP 26 6 IIC

CONTROL 2/21 8/75 LAYOUT OK 3/76 CHECKED 2/78 TRACED 2/78