

NE 1/4 SEC. 12 T.26S. R.6W. W.M.
DOUGLAS COUNTY

26 6 12A

1" = 200'

SEE MAP 26 6 ID

Cancelled No's


1000
100
202

1/4 COR.

SEE MAP 26 6 12

SEE MAP 26 5 7

CONTROL P.N. 376 LAYOUT OF 5/76 CHECKED D.T. 7/76 TRACED P.N. 474

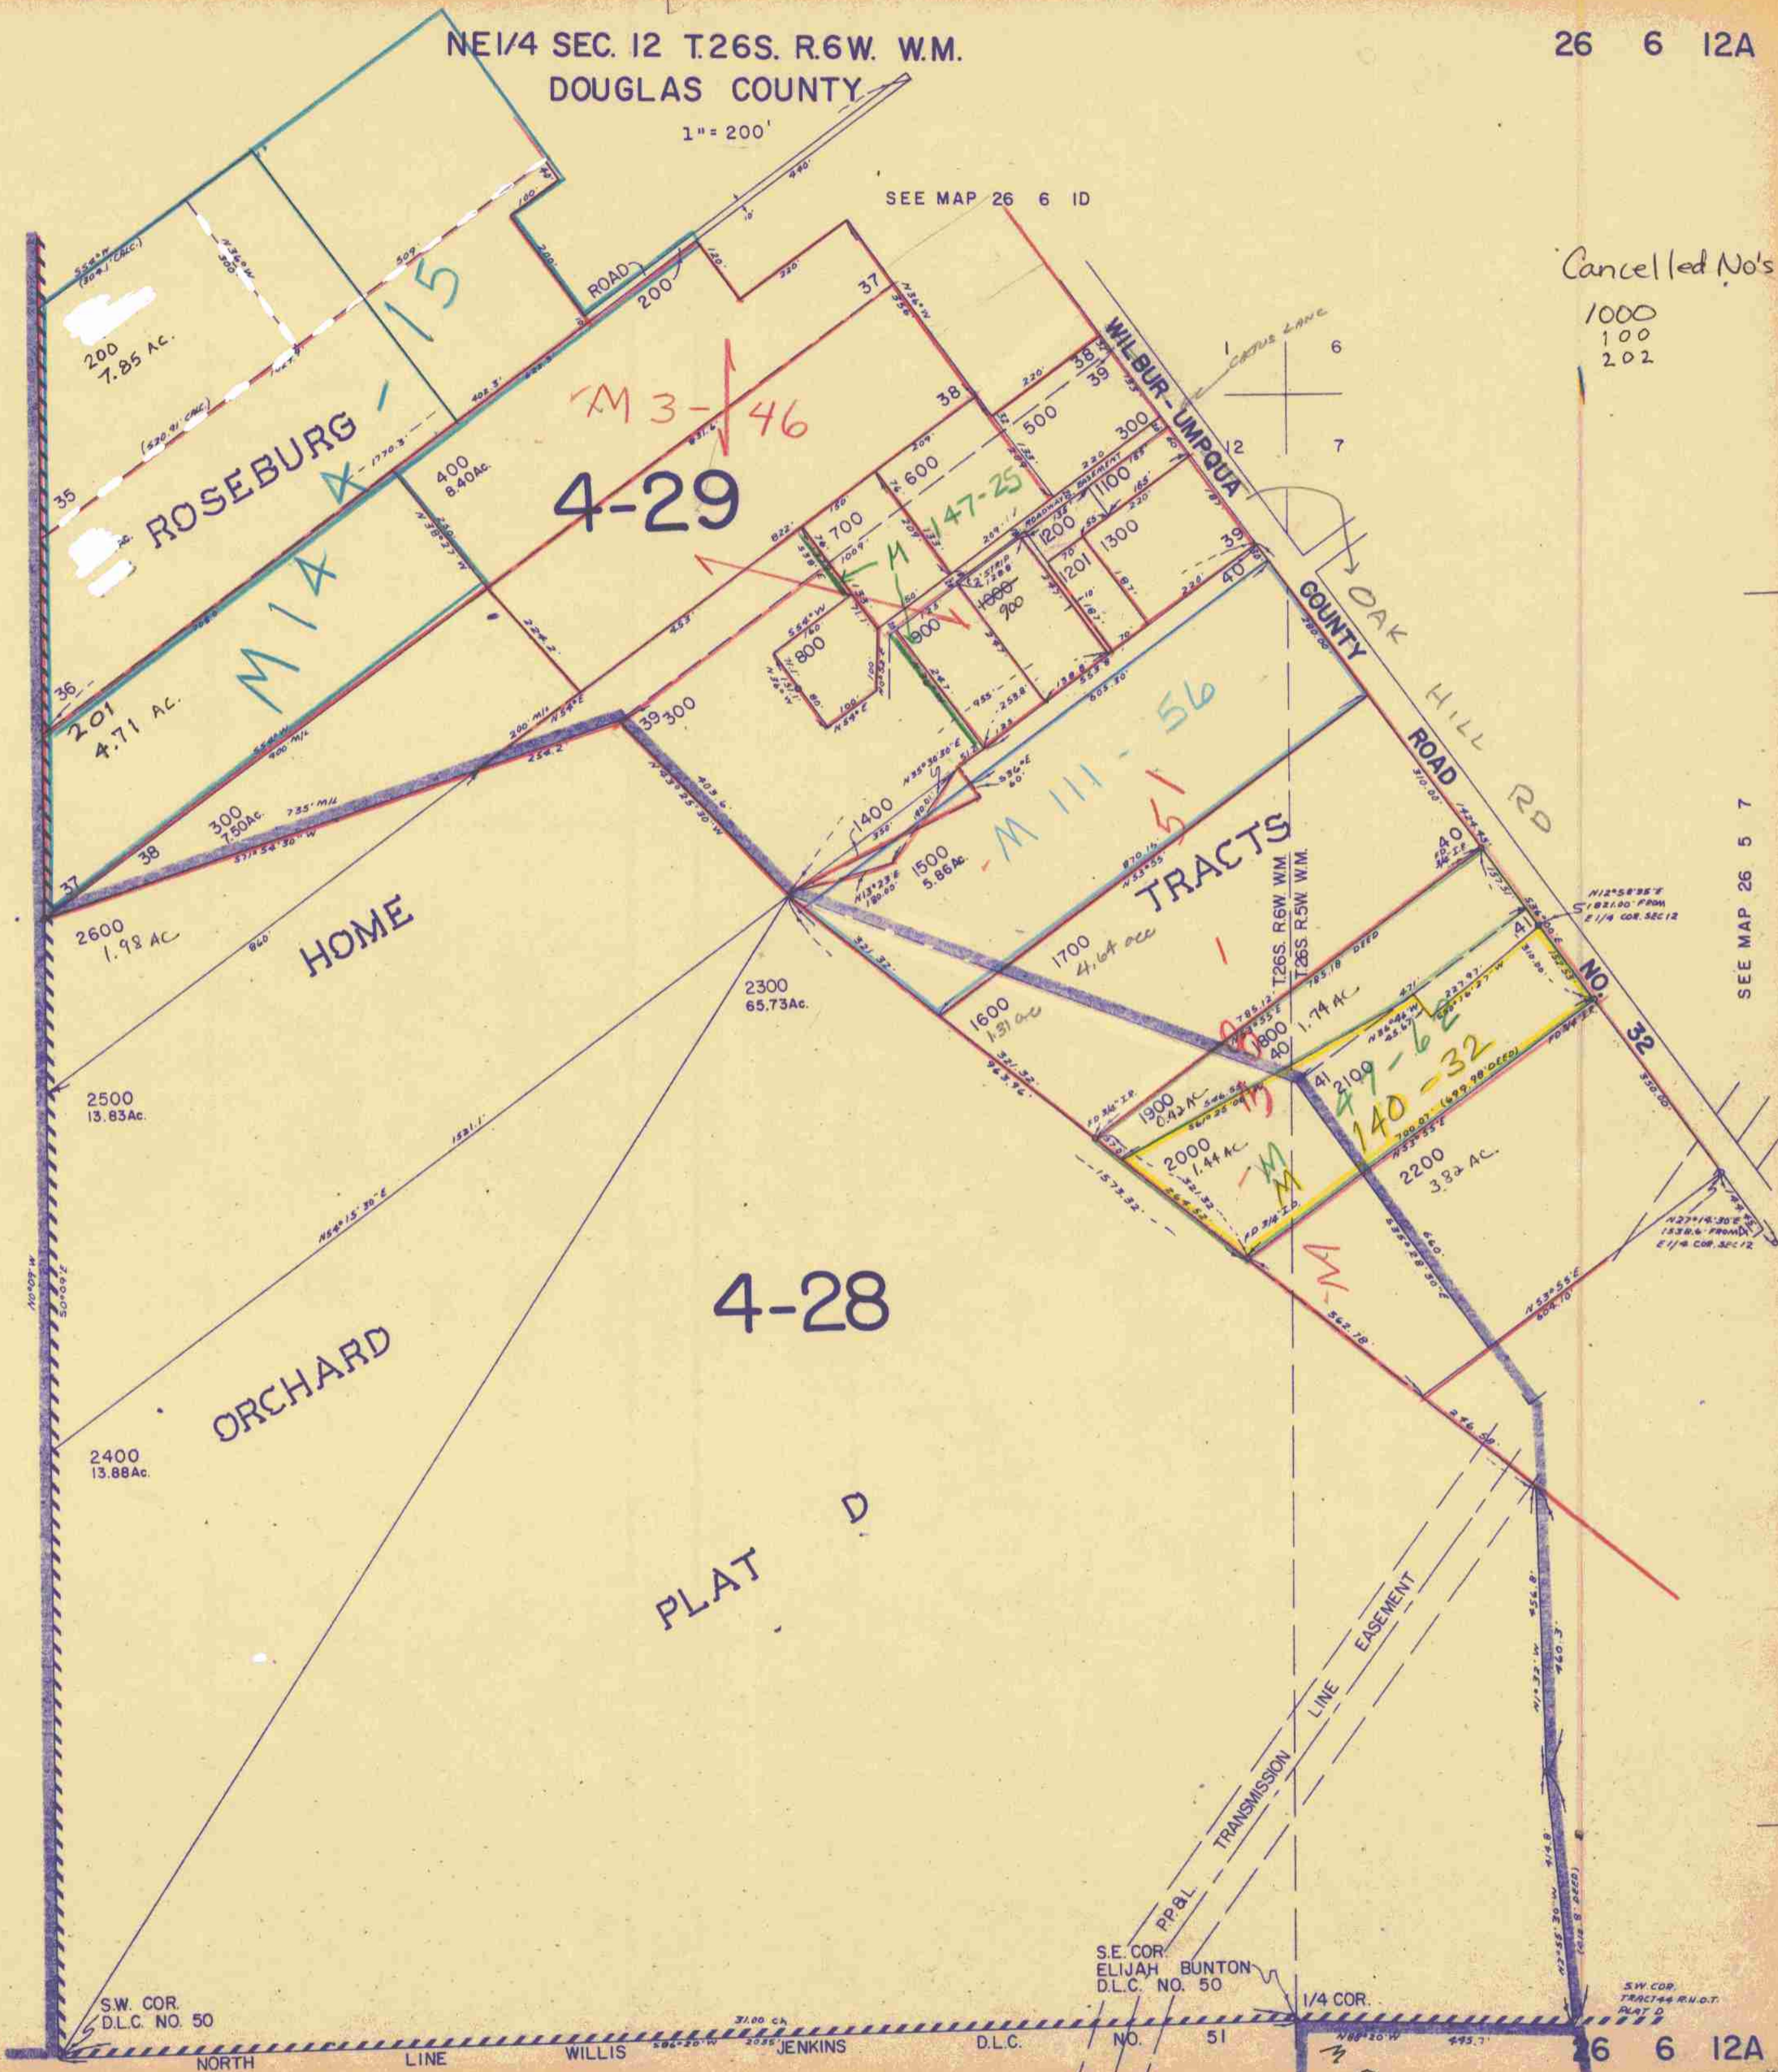

SEE MAP 26 6 12

26 6 12A

M 57-73