THIS MAP WAS PREPARED FOR ASSESSMENT PURPOSE ONLY.

Upper Left:
123°24'41"W 43°19'5"N
4146664E 615353N ft

SEC.15 T.26S. R.06W. W.M.
DOUGLAS COUNTY
1" = 400'

Date Exported 2026-04-20

260615

CANCELLED NOS:
1001 800 1000
1303 1304 1305
1406 1501 1306
1307 501 601
1405 1409 101
201 1410 202
502 1412 1413

PARCEL 801
1. N40°24'57"W 35.59'
2. N66°30'30"W 29.58'
3. N25°09'23"E 114.73'

PARCEL 1401 & 1500
1. N1°33'47"E 84.78'
2. N15°04'31"E 30'
3. N15°04'31"E 77.93'
4. N27°13'16"E 38.24'
5. N1°01'25"W 28.29'
6. N2°48'54"W 63.87'
7. N4°02'58"W 37.14'
8. N32°34'33"W 19.14'
9. N7°03'56"W 33.73'
10. N23°44'08"E 40.79'
11. N8°45'08"E 30.48'
12. N47°36'42"E 62.57'
13. N27°30'51"E 1.72'
14. S39°21'19"E 28'
15. N39°21'19"W 67.67'

PARCEL 1404
1. S88°38'22"E 54.53'
2. N74°44'38"E 68.09'
3. S38°53'42"E 132.01'
4. S42°21'35"E 190.55'
5. N48°53'16"E 42.79'
6. N22°27'17"W 119.46'
7. N27°20'02"W 87.84'
8. N23°30'28"W 150.51'
9. N48°15'16"W 218.94'
10. N63°20'22"W 319.16'
11. S77°02'35"W 89.60'
12. S24°19'51"W 28.17'
13. S18°30'13"E 53.96'
14. S29°58'07"E 88.84'
15. S36°11'01"E 85.12'
16. S51°23'51"E 278.97'

PARCEL 600
1. S59°42'34"E 32.6
2. S68°42'54"E 55.27'
3. S76°48'43"E 151.02'
4. S86°07'16"E 36.61'
5. N84°34'53"E 109.62'
6. N84°48'40"E 177.59'
7. S88°20'25"E 24.1'
8. S46°33'20"E 25.8'
9. S40°19'39"E 103.8'
10. S36°49'14"E 53.26'
11. S42°35'31"E 53.74'
12. A=51.09' R=383.69'
LC=N30°25'37"W 51.06'
13. N26°36'44"W 59.01'
14. A=90.8 R=264.97'
LC=N36°25'43"W 90.35'
15. N46°14'43"W 22.5'
16. A=115.8 R=125.68'
LC=N72°38'26"W 111.75'
17. S80°57'52"W 26.71'
18. A= 49.92' R=164.58'
LC=S89°39'16"W 49.73'
19. N72°15'34"W 139.38'
20. N82°07'29"W 103.3'
21. N60°53'07"W 77.79'
22. N42°08'05"W 142.62'
23. N47°51'51"W 90.21'
24. N47°16'36"E 44.62'
25. N47°30'52"E 56.67'
26. N45°48'01"E 62.33'
27. N46°51'29"E 97.26'
28. N47°10'27"E 68.04'
29. N48°13'12"E 74.48'
30. N46°51'34"E 42.99'
31. N46°51'34"E 15.41'
32. N49°38'56"E 57.54'
33. S24°19'14"E 40.45'
34. S33°57'43"E 41.72'
35. S44°38'42"E 66.76'

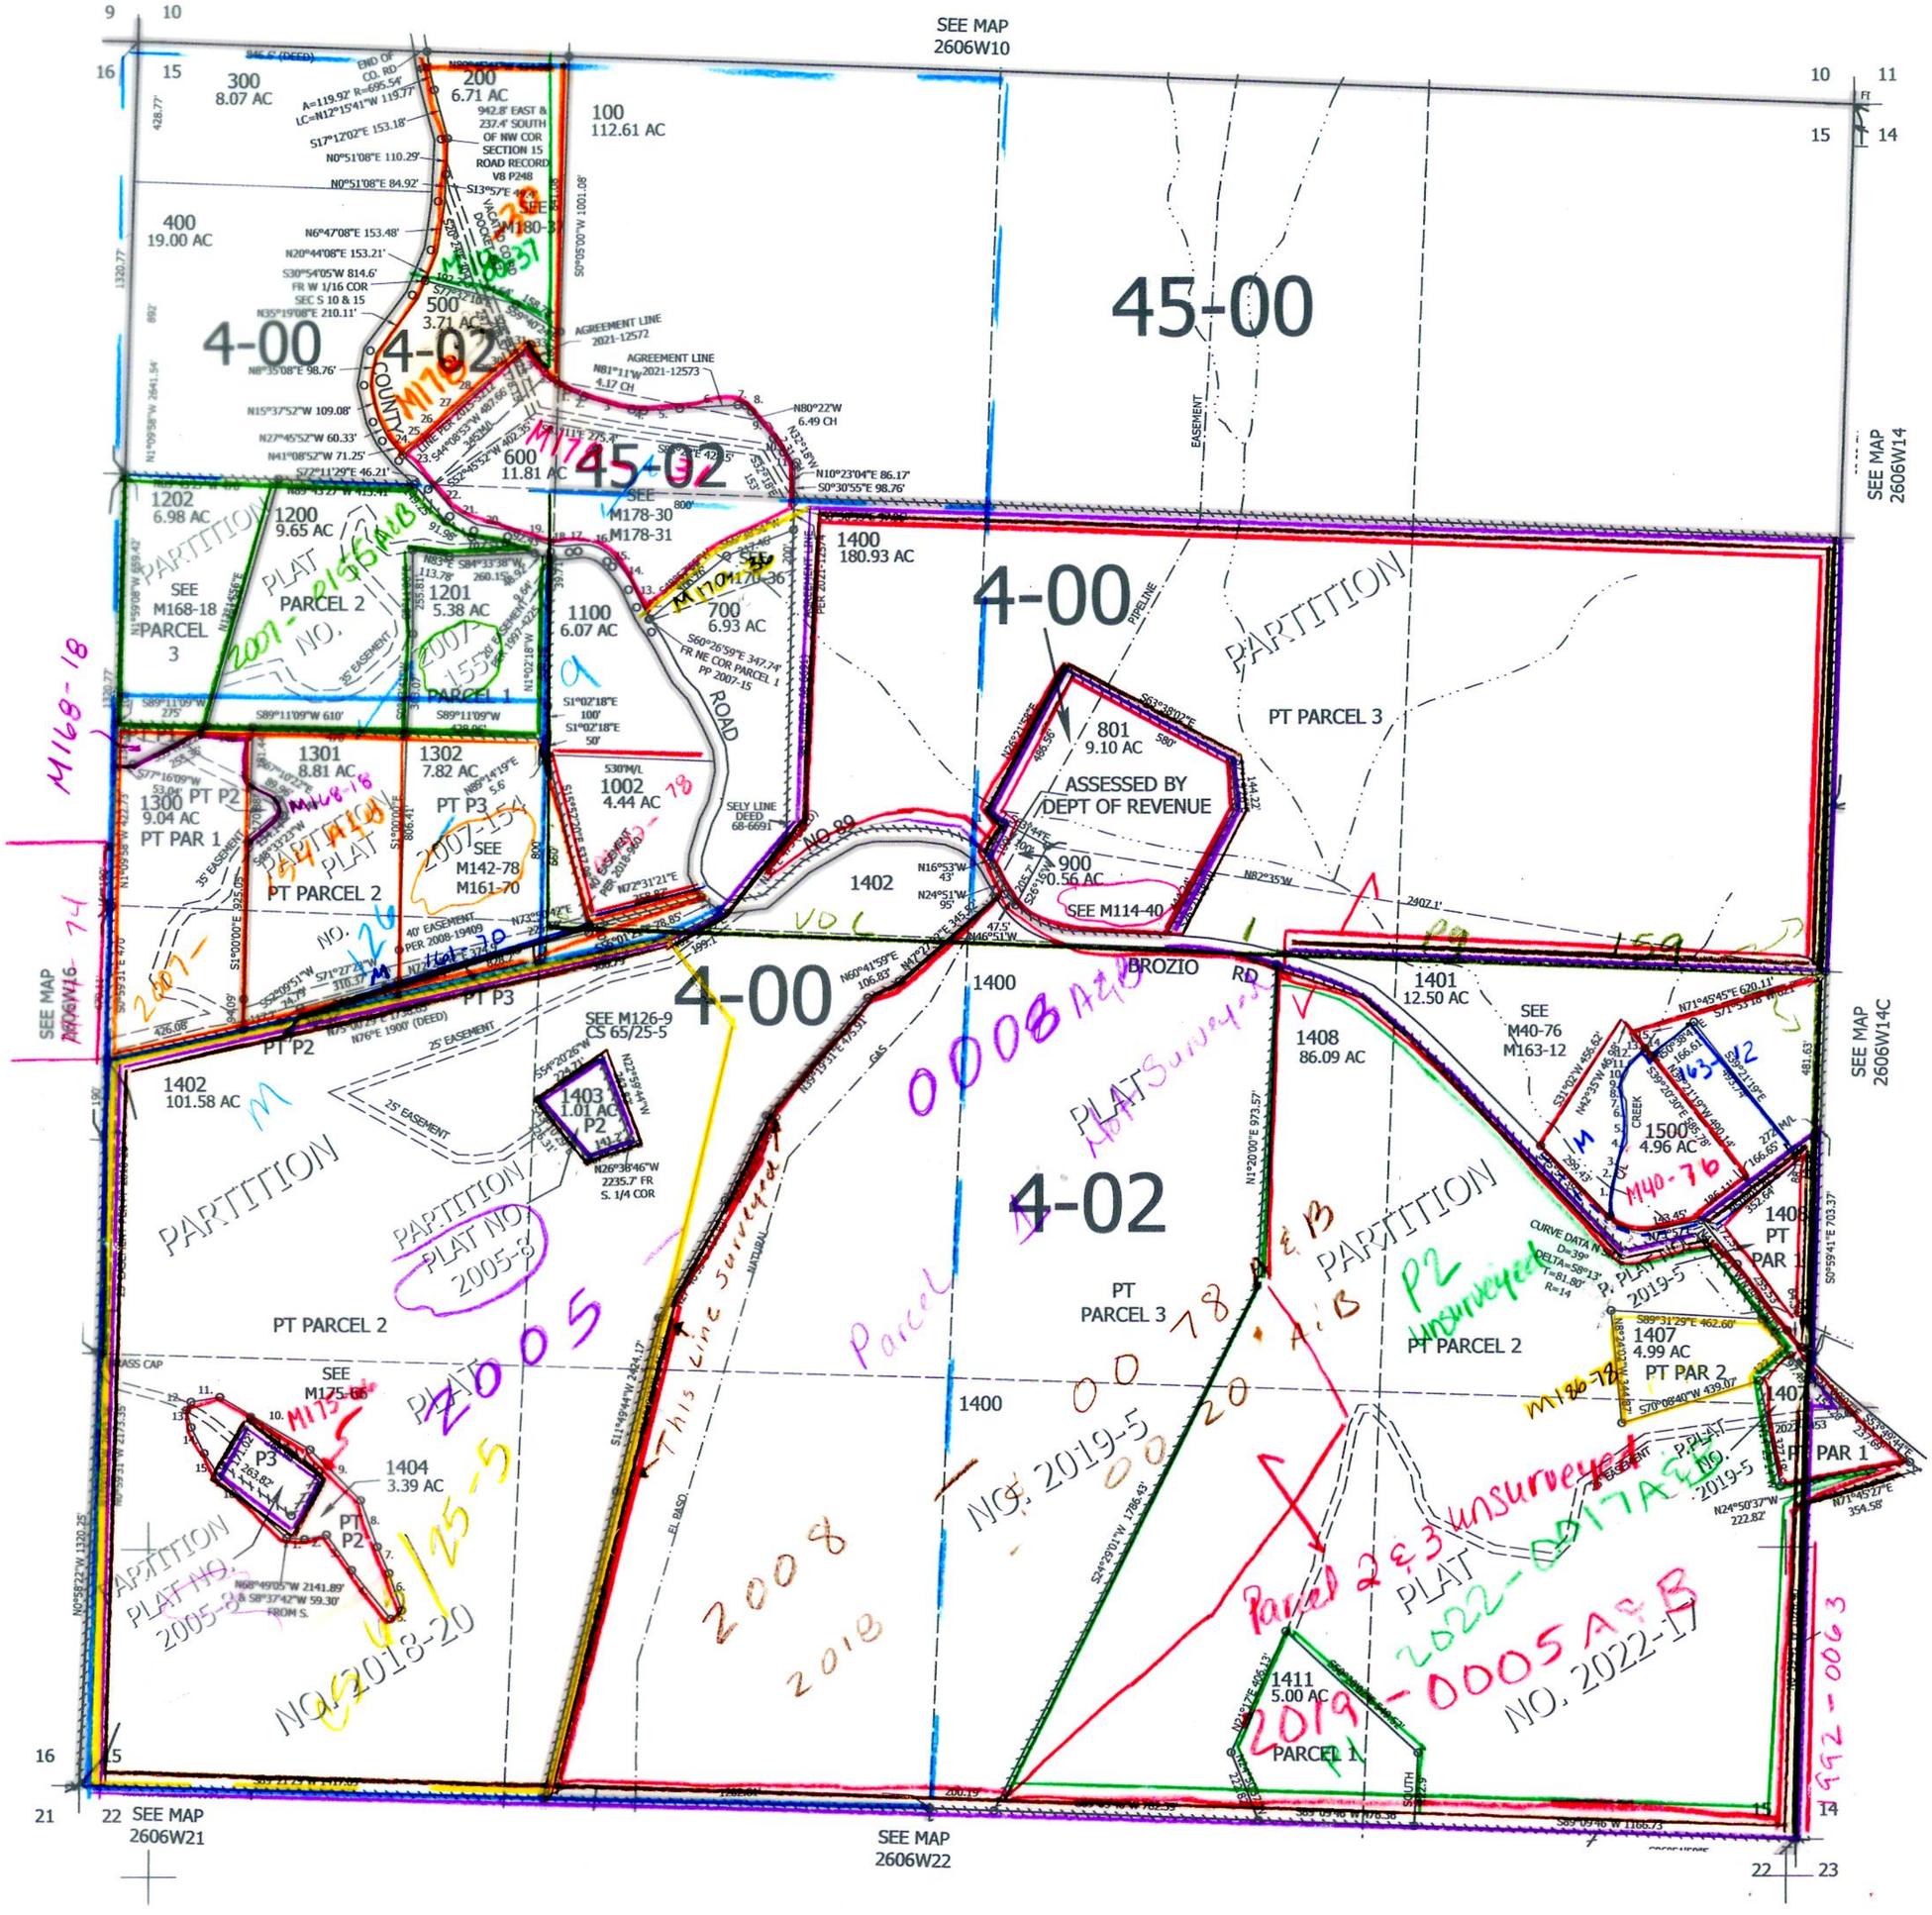

Lower Right:
123°22'52"W 43°18'N
4154514E 608398N ft

260615