

SEE MAP 26 6 16

INT ELL COR  
DLC NO 61

SEE MAP 26 6 20A

CANCELLED NO'S  
104 108 109

SEE MAP 26 6 22

SEE MAP 26 6 20D

1994-0095  
M 44-57

SEE MAP 26 6 22C


605,000

SEE MAP 26 6 28BB

SEE MAP 26 6 28BA

SEE MAP 26 6 28A

4,147,000

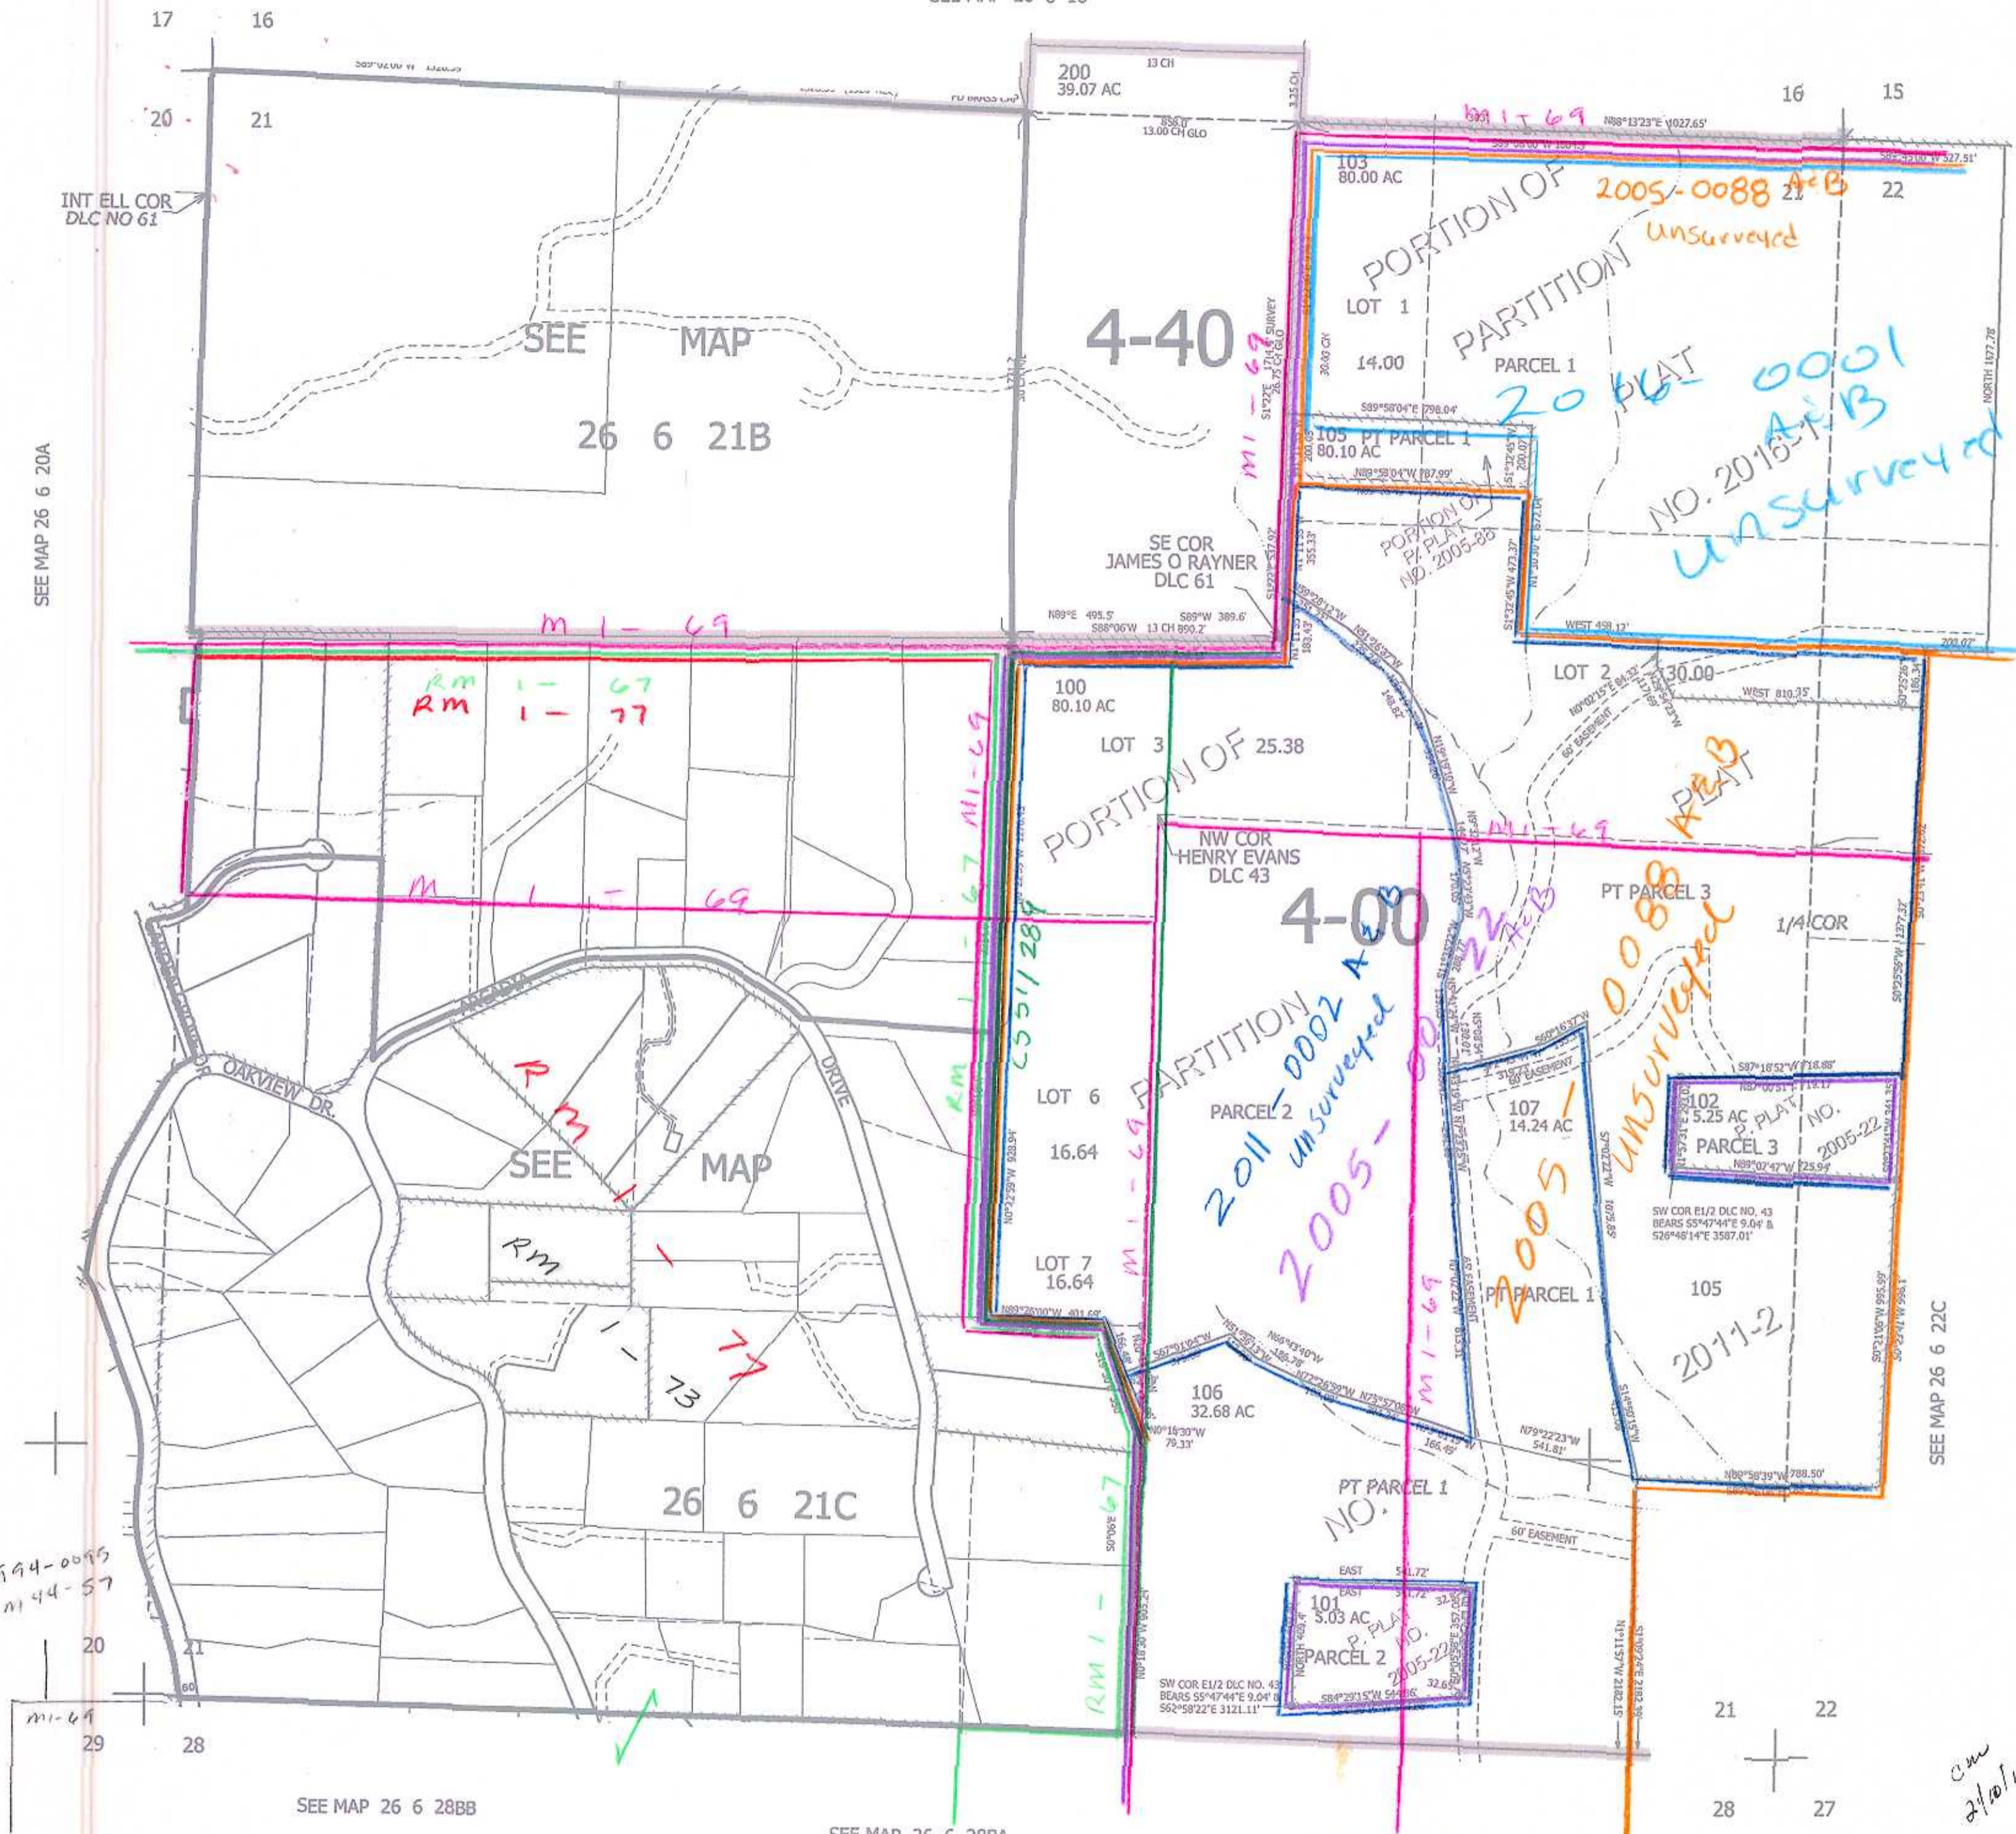

cm  
2/10/11

sc