


SEE MAP
2606W13DD

1" = 100'

CANCELLED NOS.

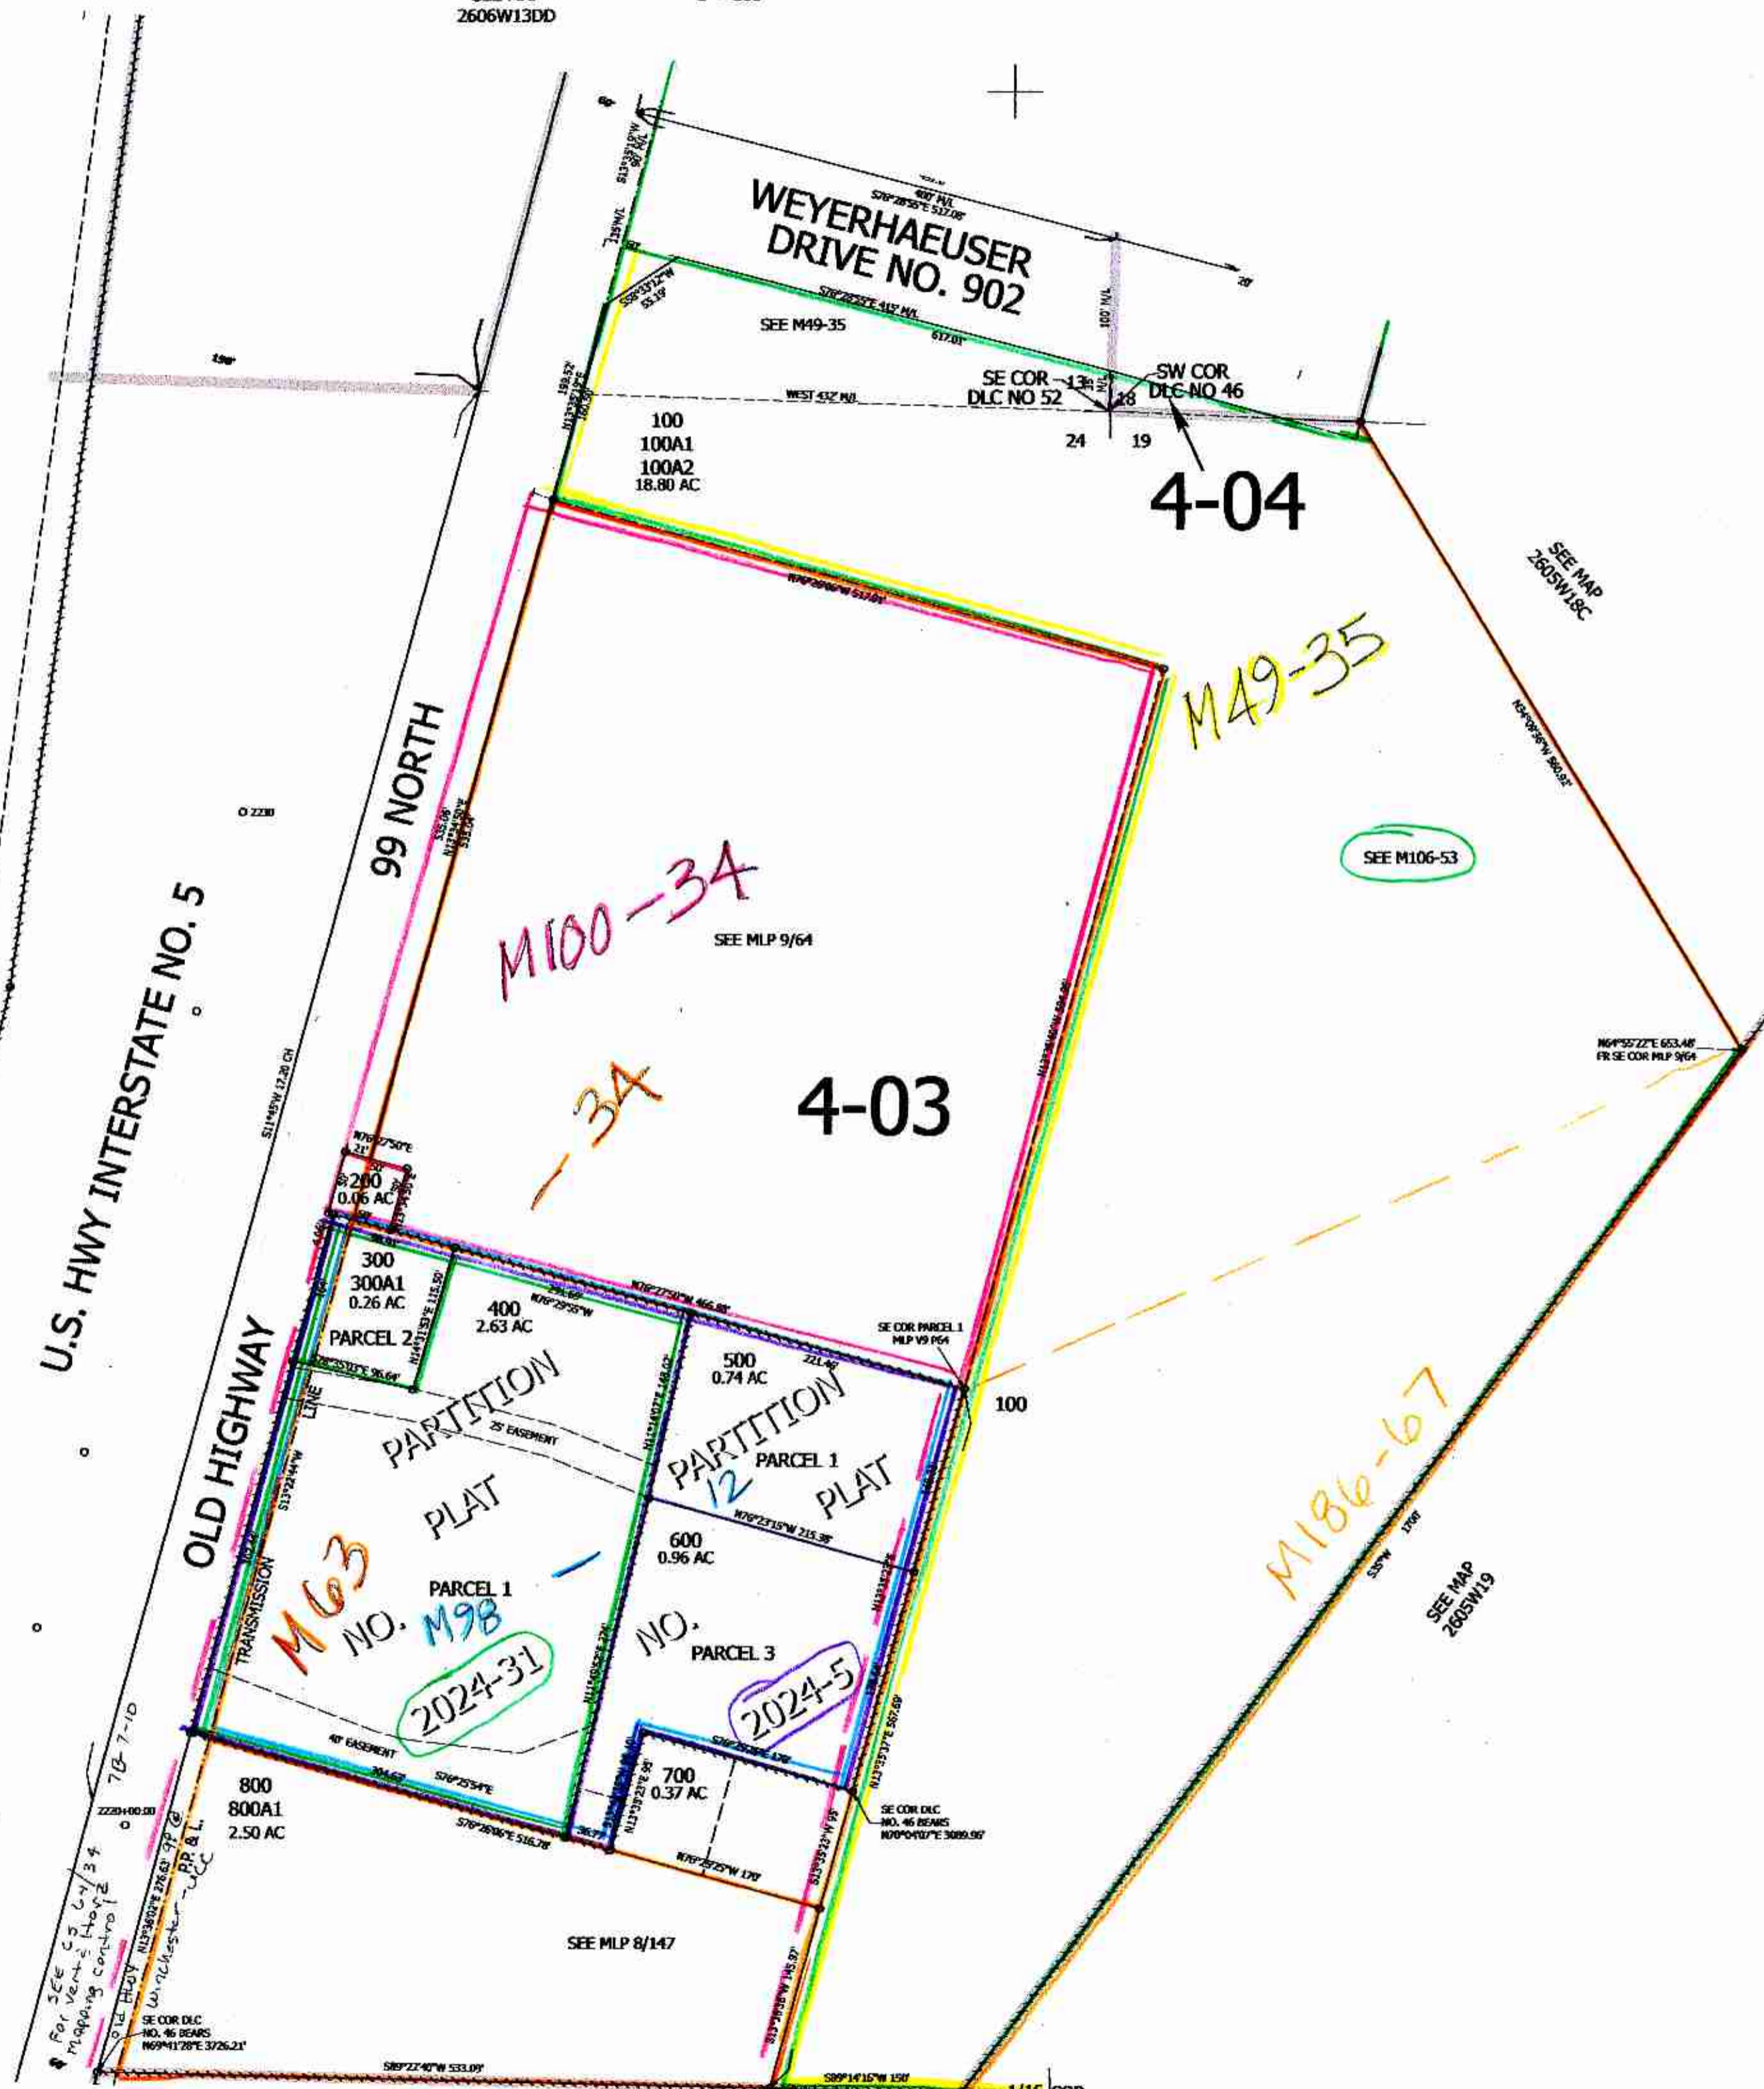

SEE MAP
2606W24

U.S. HWY INTERSTATE NO. 5

OLD HIGHWAY

99 NORTH

WEYERHAEUSER
DRIVE NO. 902

4-04

M100-34

M49-35

4-03

SEE M106-53

M63
NO. M98

M186-67

2024-31

2024-5

1/2025

SEE MAP
2606W24