NW1/4 SEC 26 26 S R6W WM
DOUGLAS COUNTY
1" = 200'

REVISED ON
4-4-91

26 6 26B

CANCELLED PARCEL NO'S

500 M1	1001
600 M2	1001 M1
800 M2	100 M1
900 M2	601
1000 M2	200 M1
1001 M2	201 M1
1600 M2	300 M1
601 M1	400 M1
700 M1	600 M1
	800 M1
	900 M1
	1000 M1
	1100 M1
	1200 M1
	1300 M1
	1400 M1
	1500 M1
	1600 M1
	1000

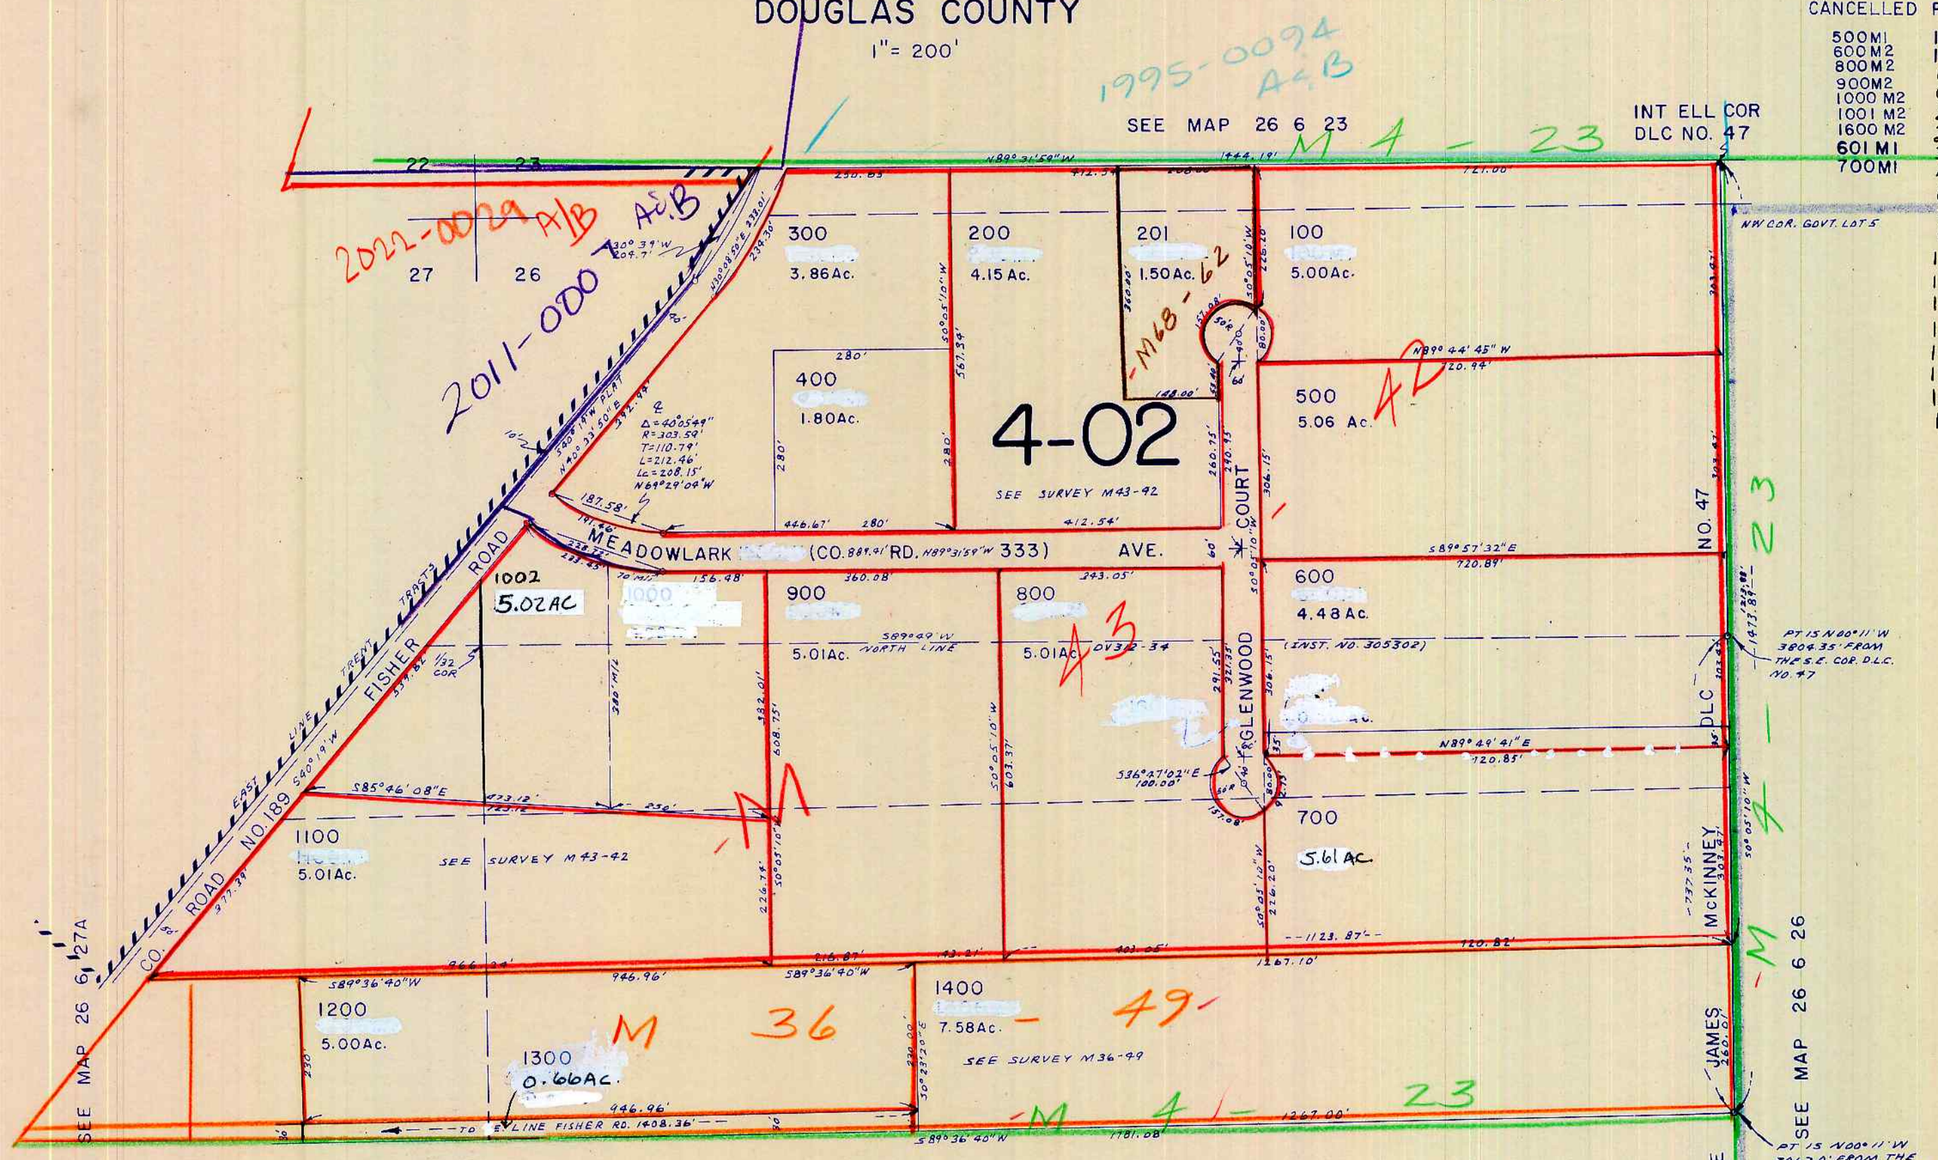

SEE MAP 26 6 26

APPROX
1/4 COR

60,000

26 6 26B

135,000

4/91