THIS MAP WAS PREPARED FOR ASSESSMENT PURPOSE ONLY.

SEC.27 T.26S. R.6W. W.M.
DOUGLAS COUNTY

1" = 400'

REVISED ON 5-30-07

26 6 27 & INDEX

CANCELLED NO'S
107 105 102
112 104 211
111 213 214
215 203 204
207 200 201
205 206 300
401 101 113
212 106 110
402 403 404

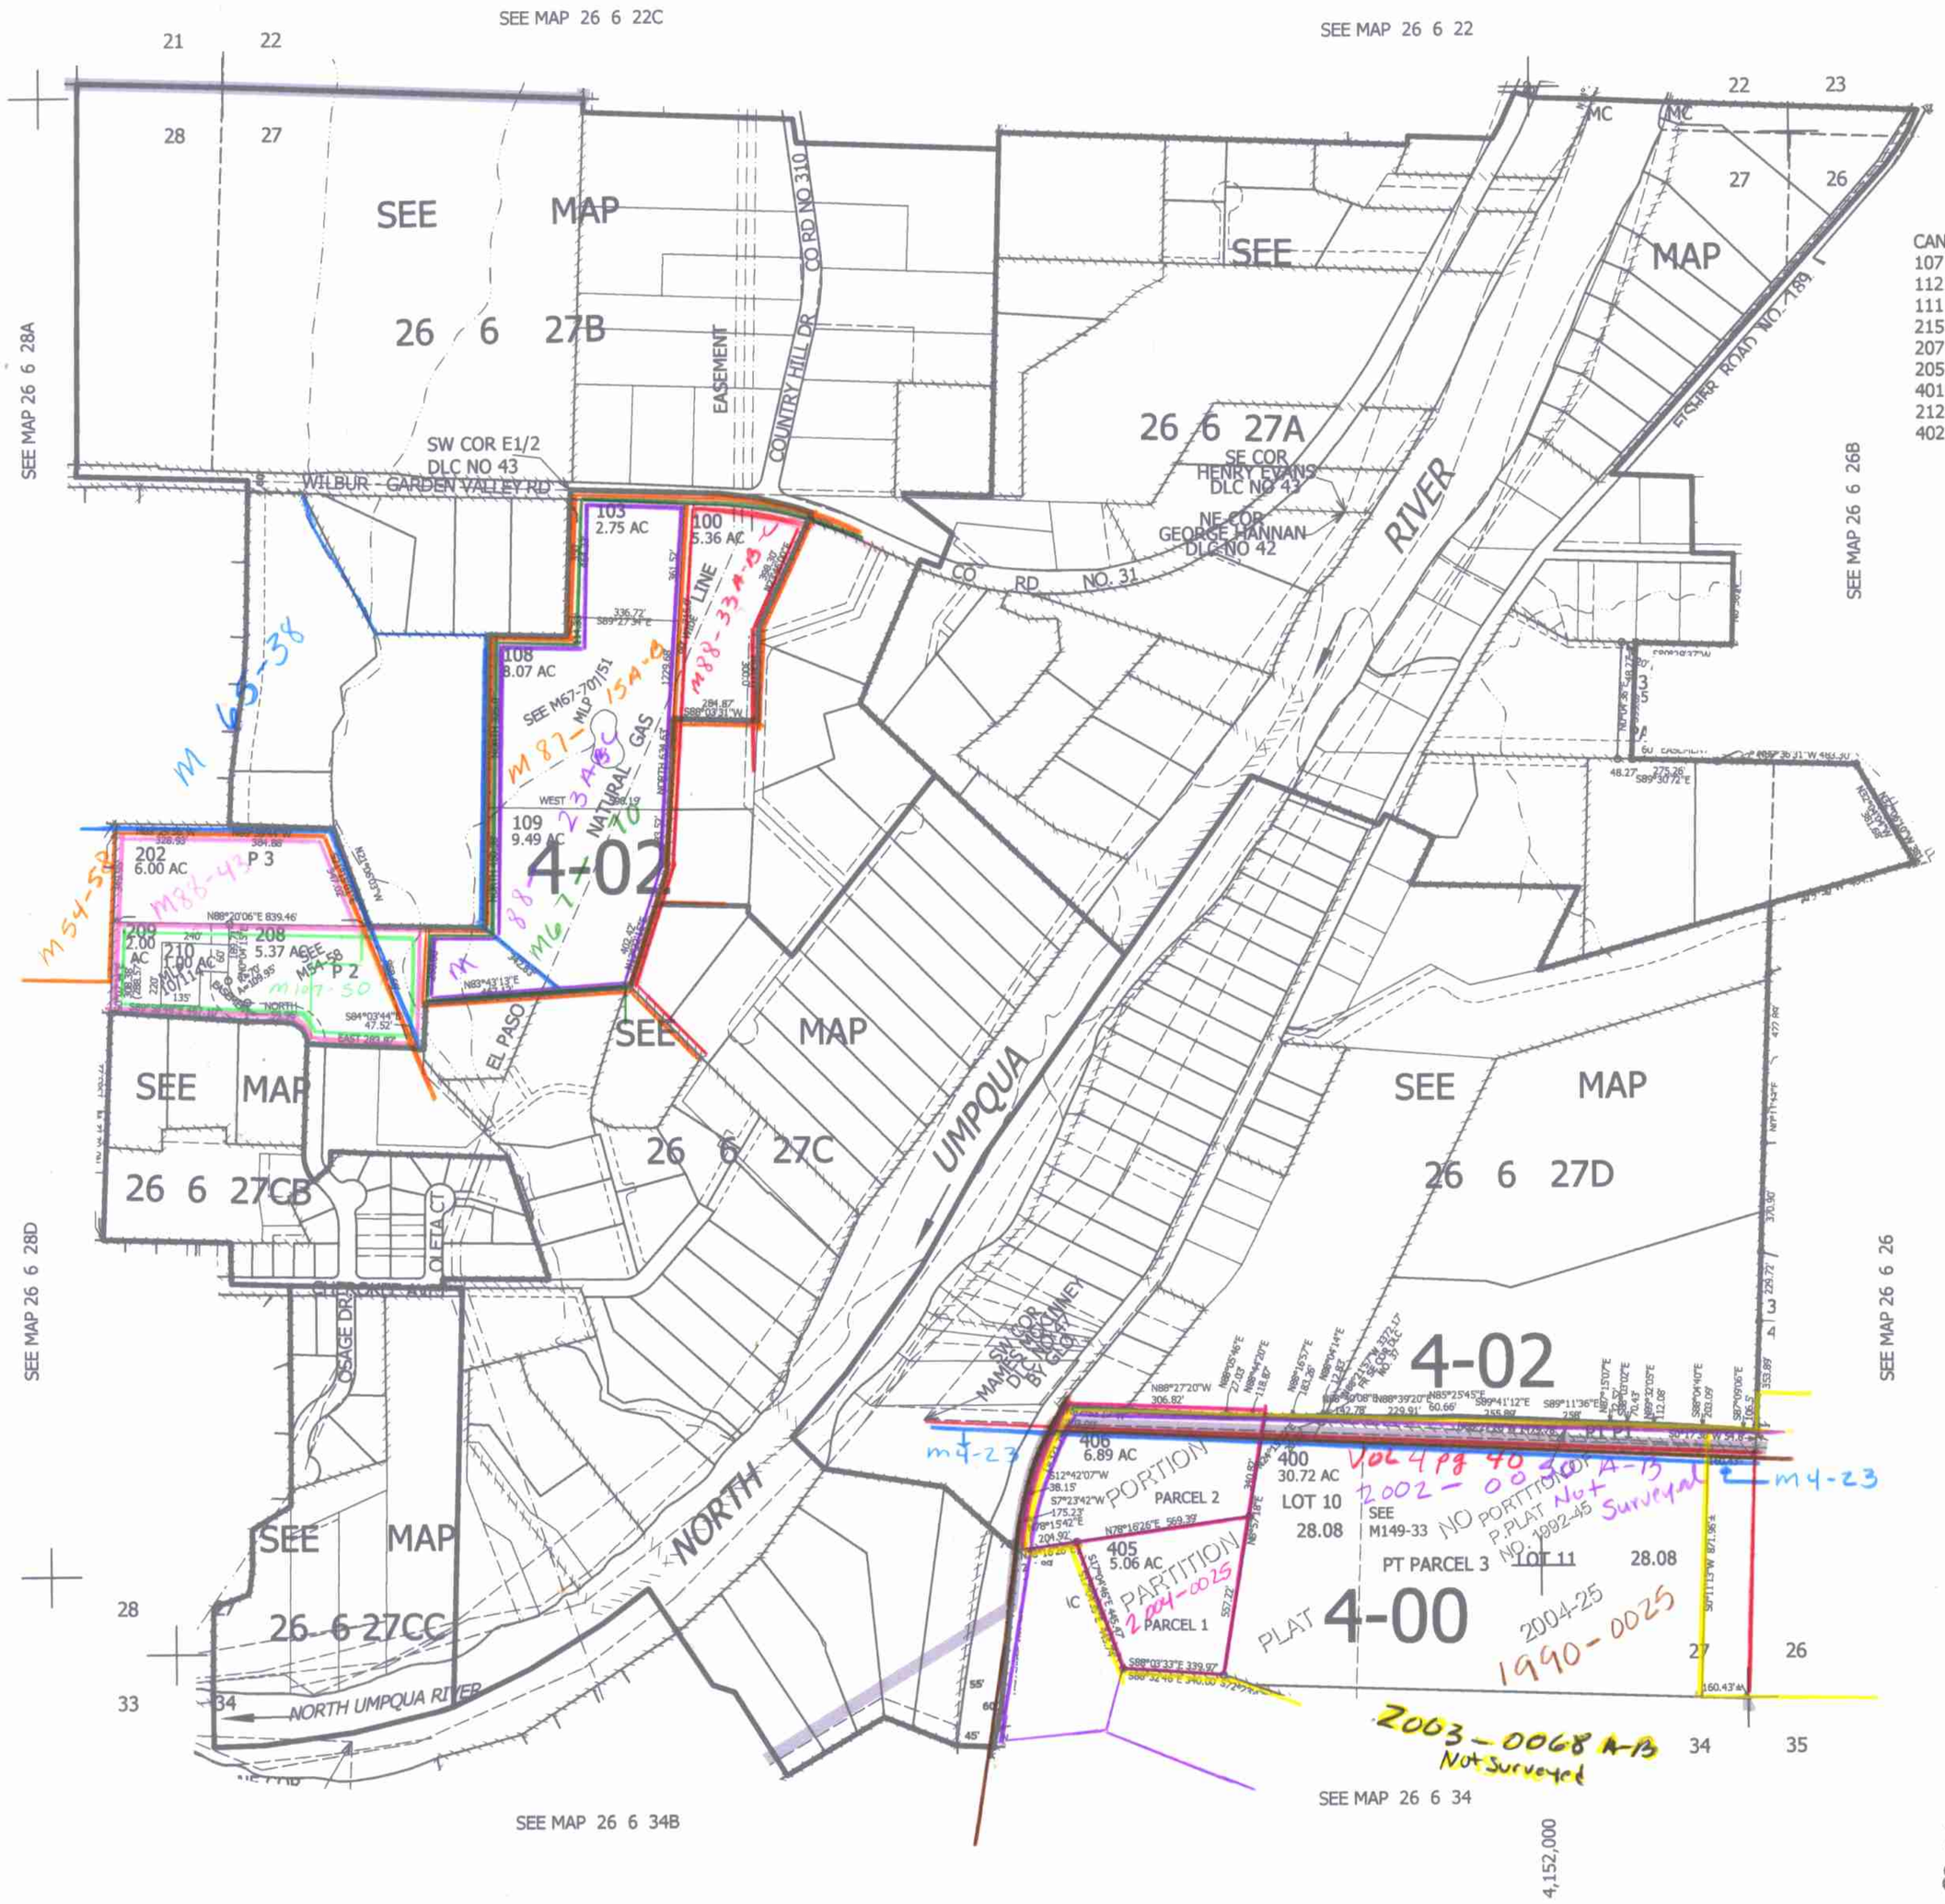

26 6 27 & INDEX