


SW1/4 SW1/4 SEC. 27 T.26S. R.6W. W.M.
DOUGLAS COUNTY

26 6 27CC

1" = 100'

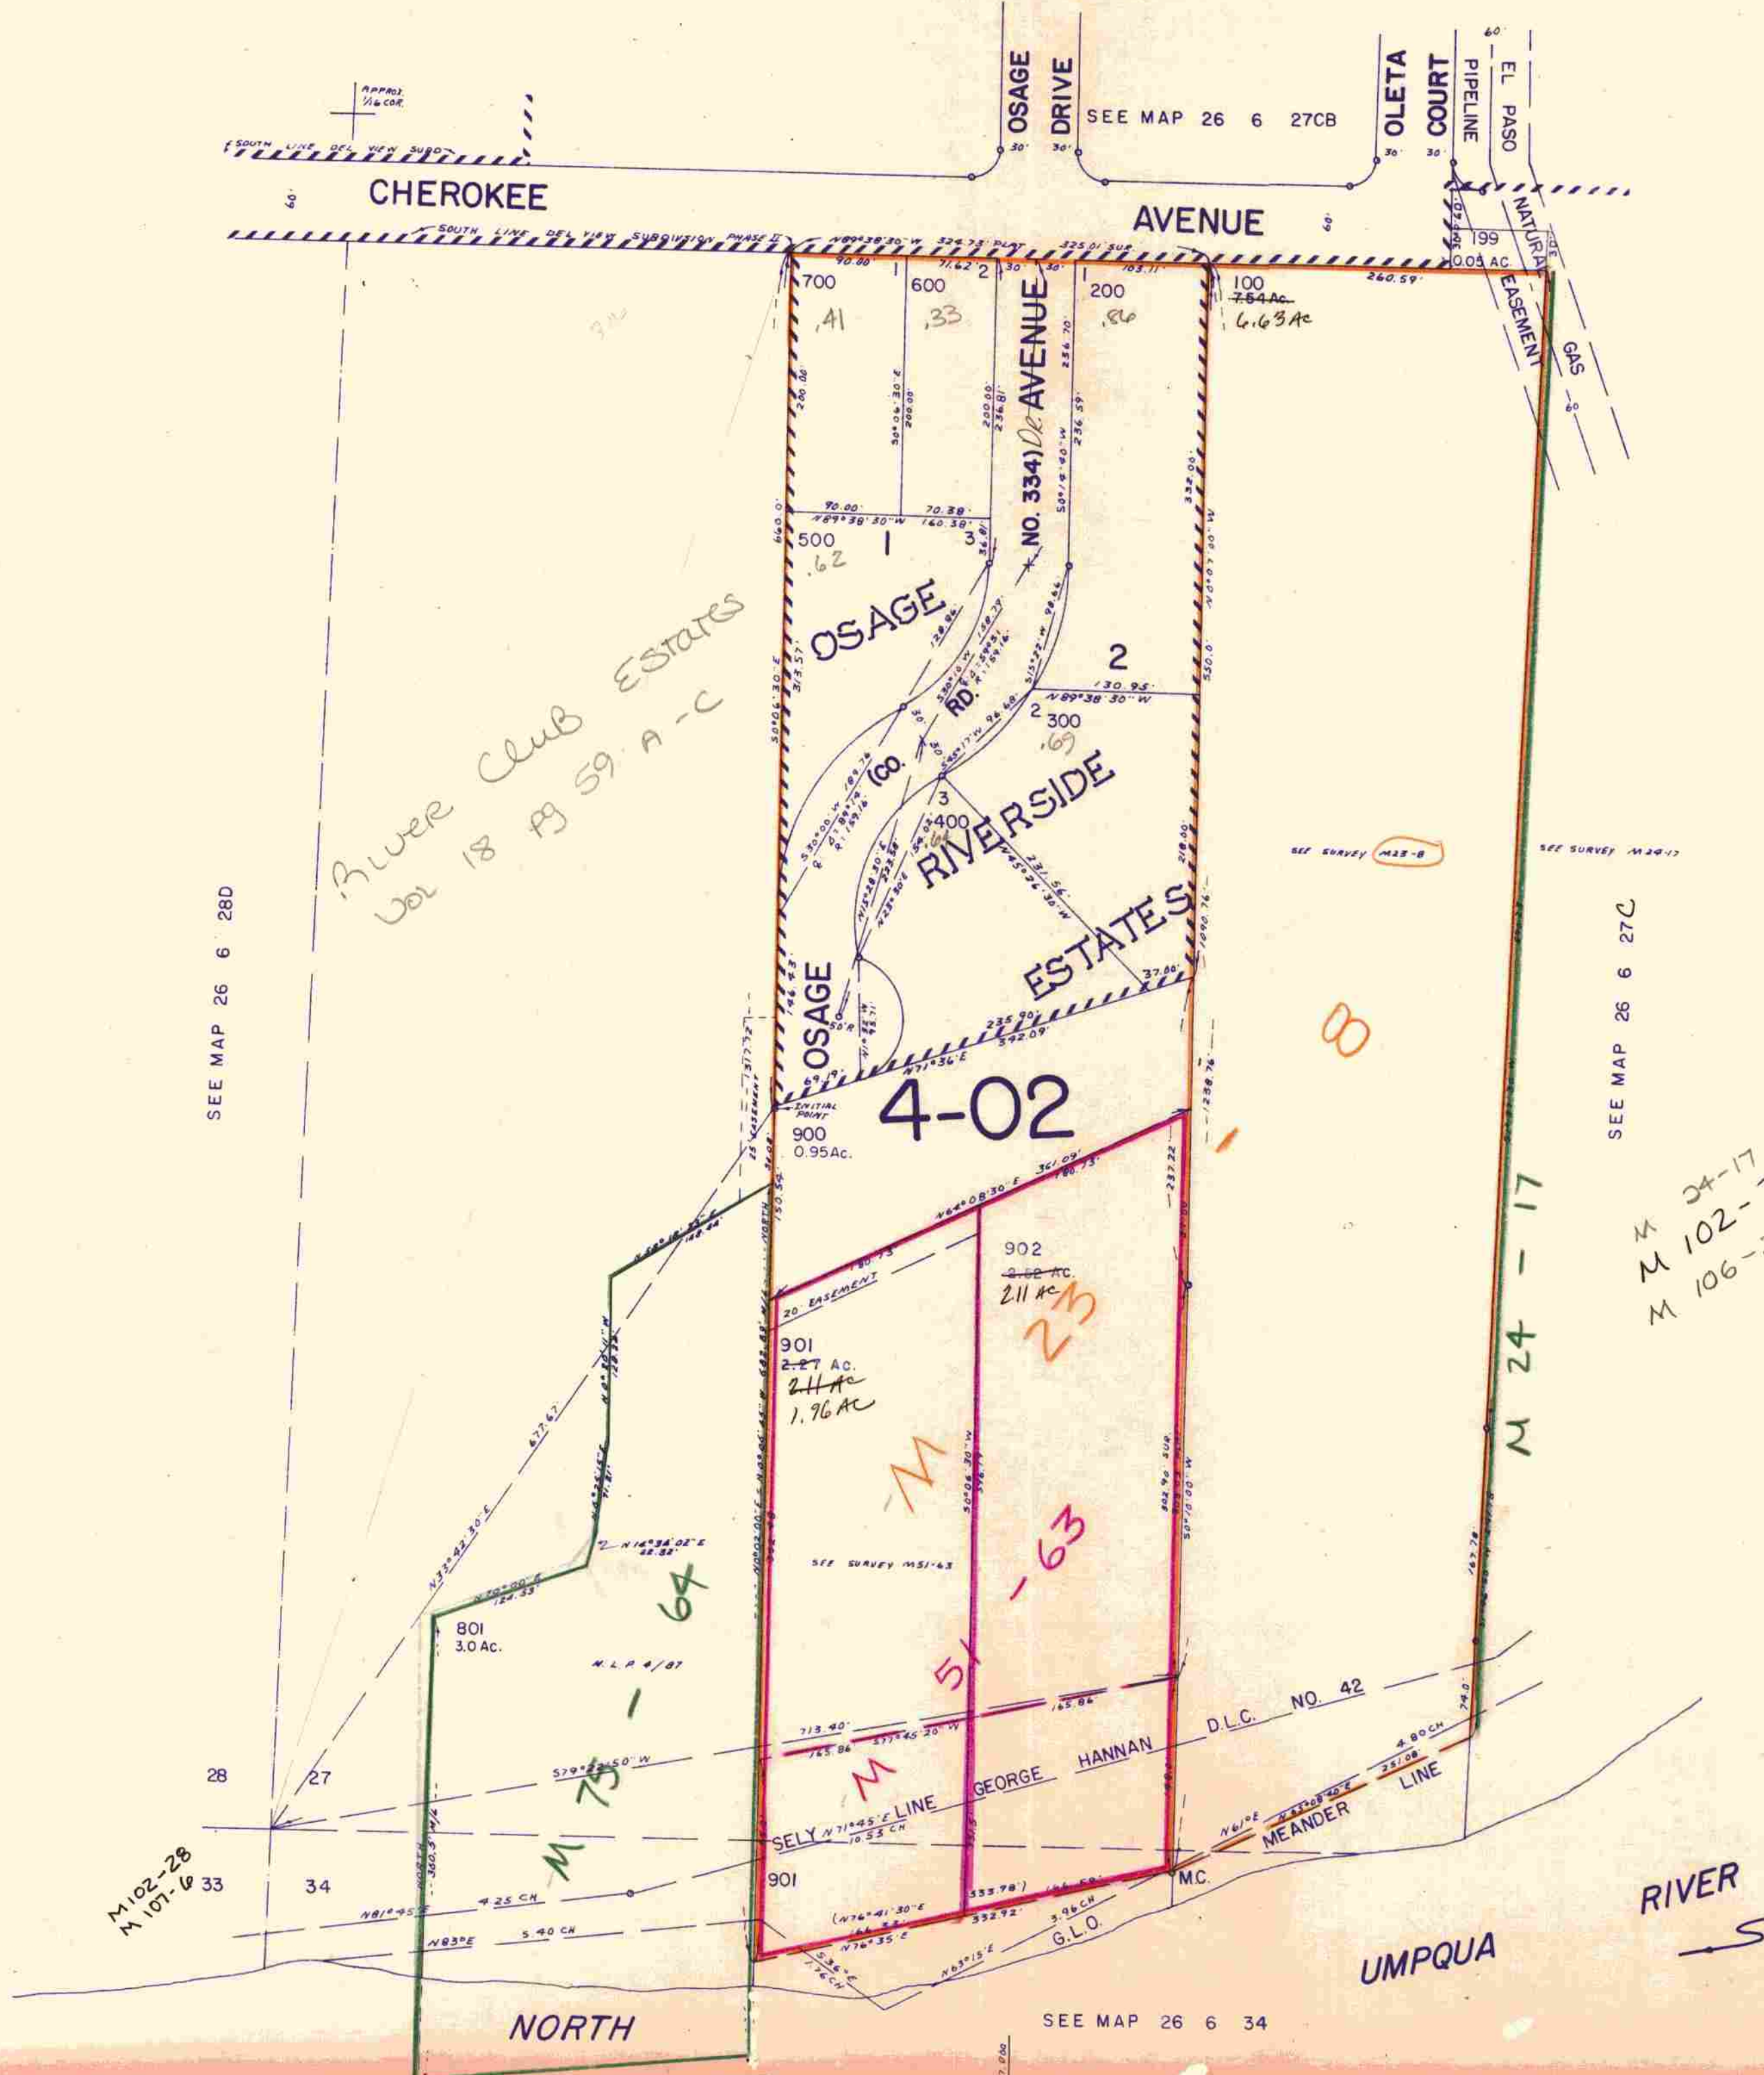

CHEROKEE AVENUE

OSAGE DRIVE

OLETA COURT

PIPELINE

EL PASO

AVENUE

700 600 200 100
41 33 86
6.63 Ac

OSAGE RIVERSIDE ESTATES

4-02

902 2.11 Ac

901 2.27 Ac
2.11 Ac
1.96 Ac

River Club Estates
Vol 18 Pg 59 A-C

M 24-17
M 102-28 A#B
M 106-2

SEE MAP 26 6 28D

SEE MAP 26 6 27C

SEE MAP 26 6 34

26 6 27CC

TF 83
A-14