


NE 1/4 NE 1/4 SEC. 29 T. 26S. R. 6W. WM.  
DOUGLAS COUNTY

26 6 29AA


1"=100'

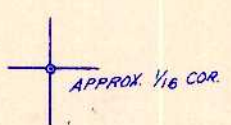

RM 1-67

1994 - 0095  
SEE MAP 26 6 M200 4-55


21 M33-78  
M96-74  
M42-29

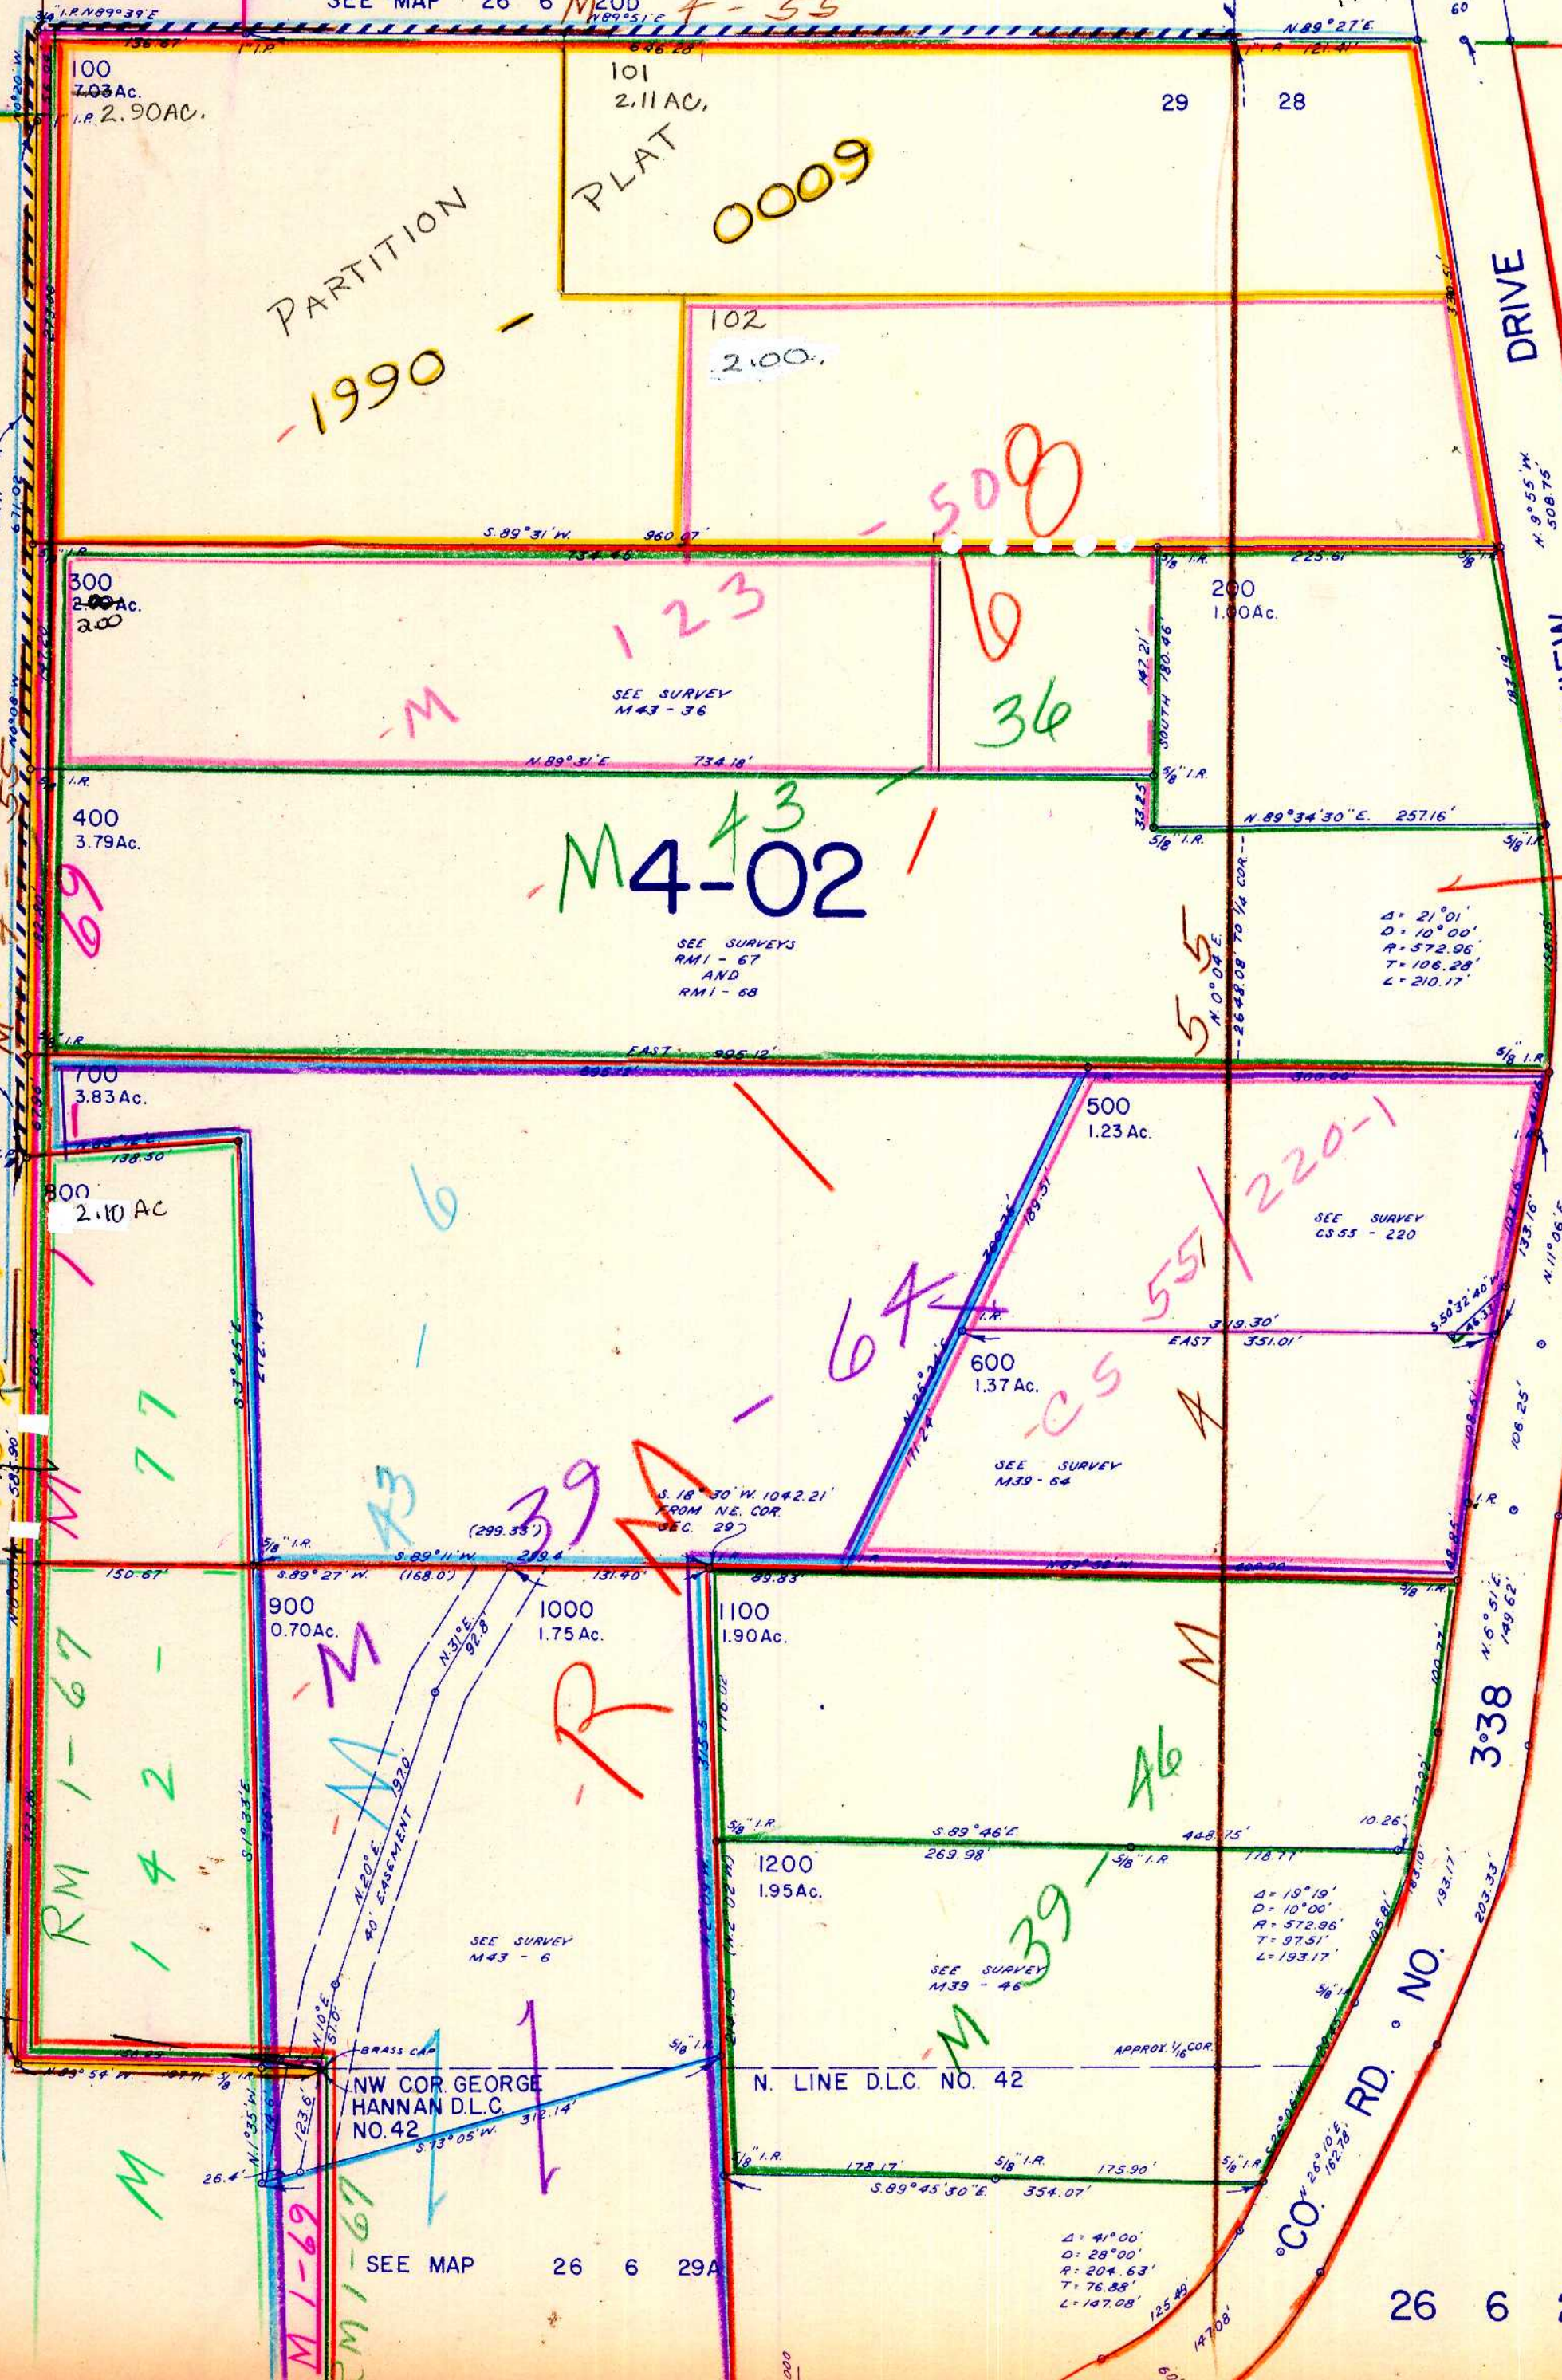

SEE MAP 26 6 29A

SEE MAP 26 6 28BB

M108-65

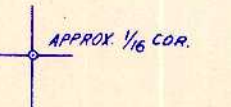

SEE MAP 26 6 29A

26 6 29AA

10/18/87