THIS MAP WAS PREPARED FOR ASSESSMENT PURPOSE ONLY.

NW1/4 SEC.31 T.26S. R.6W. W.M.
DOUGLAS COUNTY

1" = 200'

REVISED ON 1-24-19

26 6 31B

CANCELLED NO'S

2017 - 0002 A&B

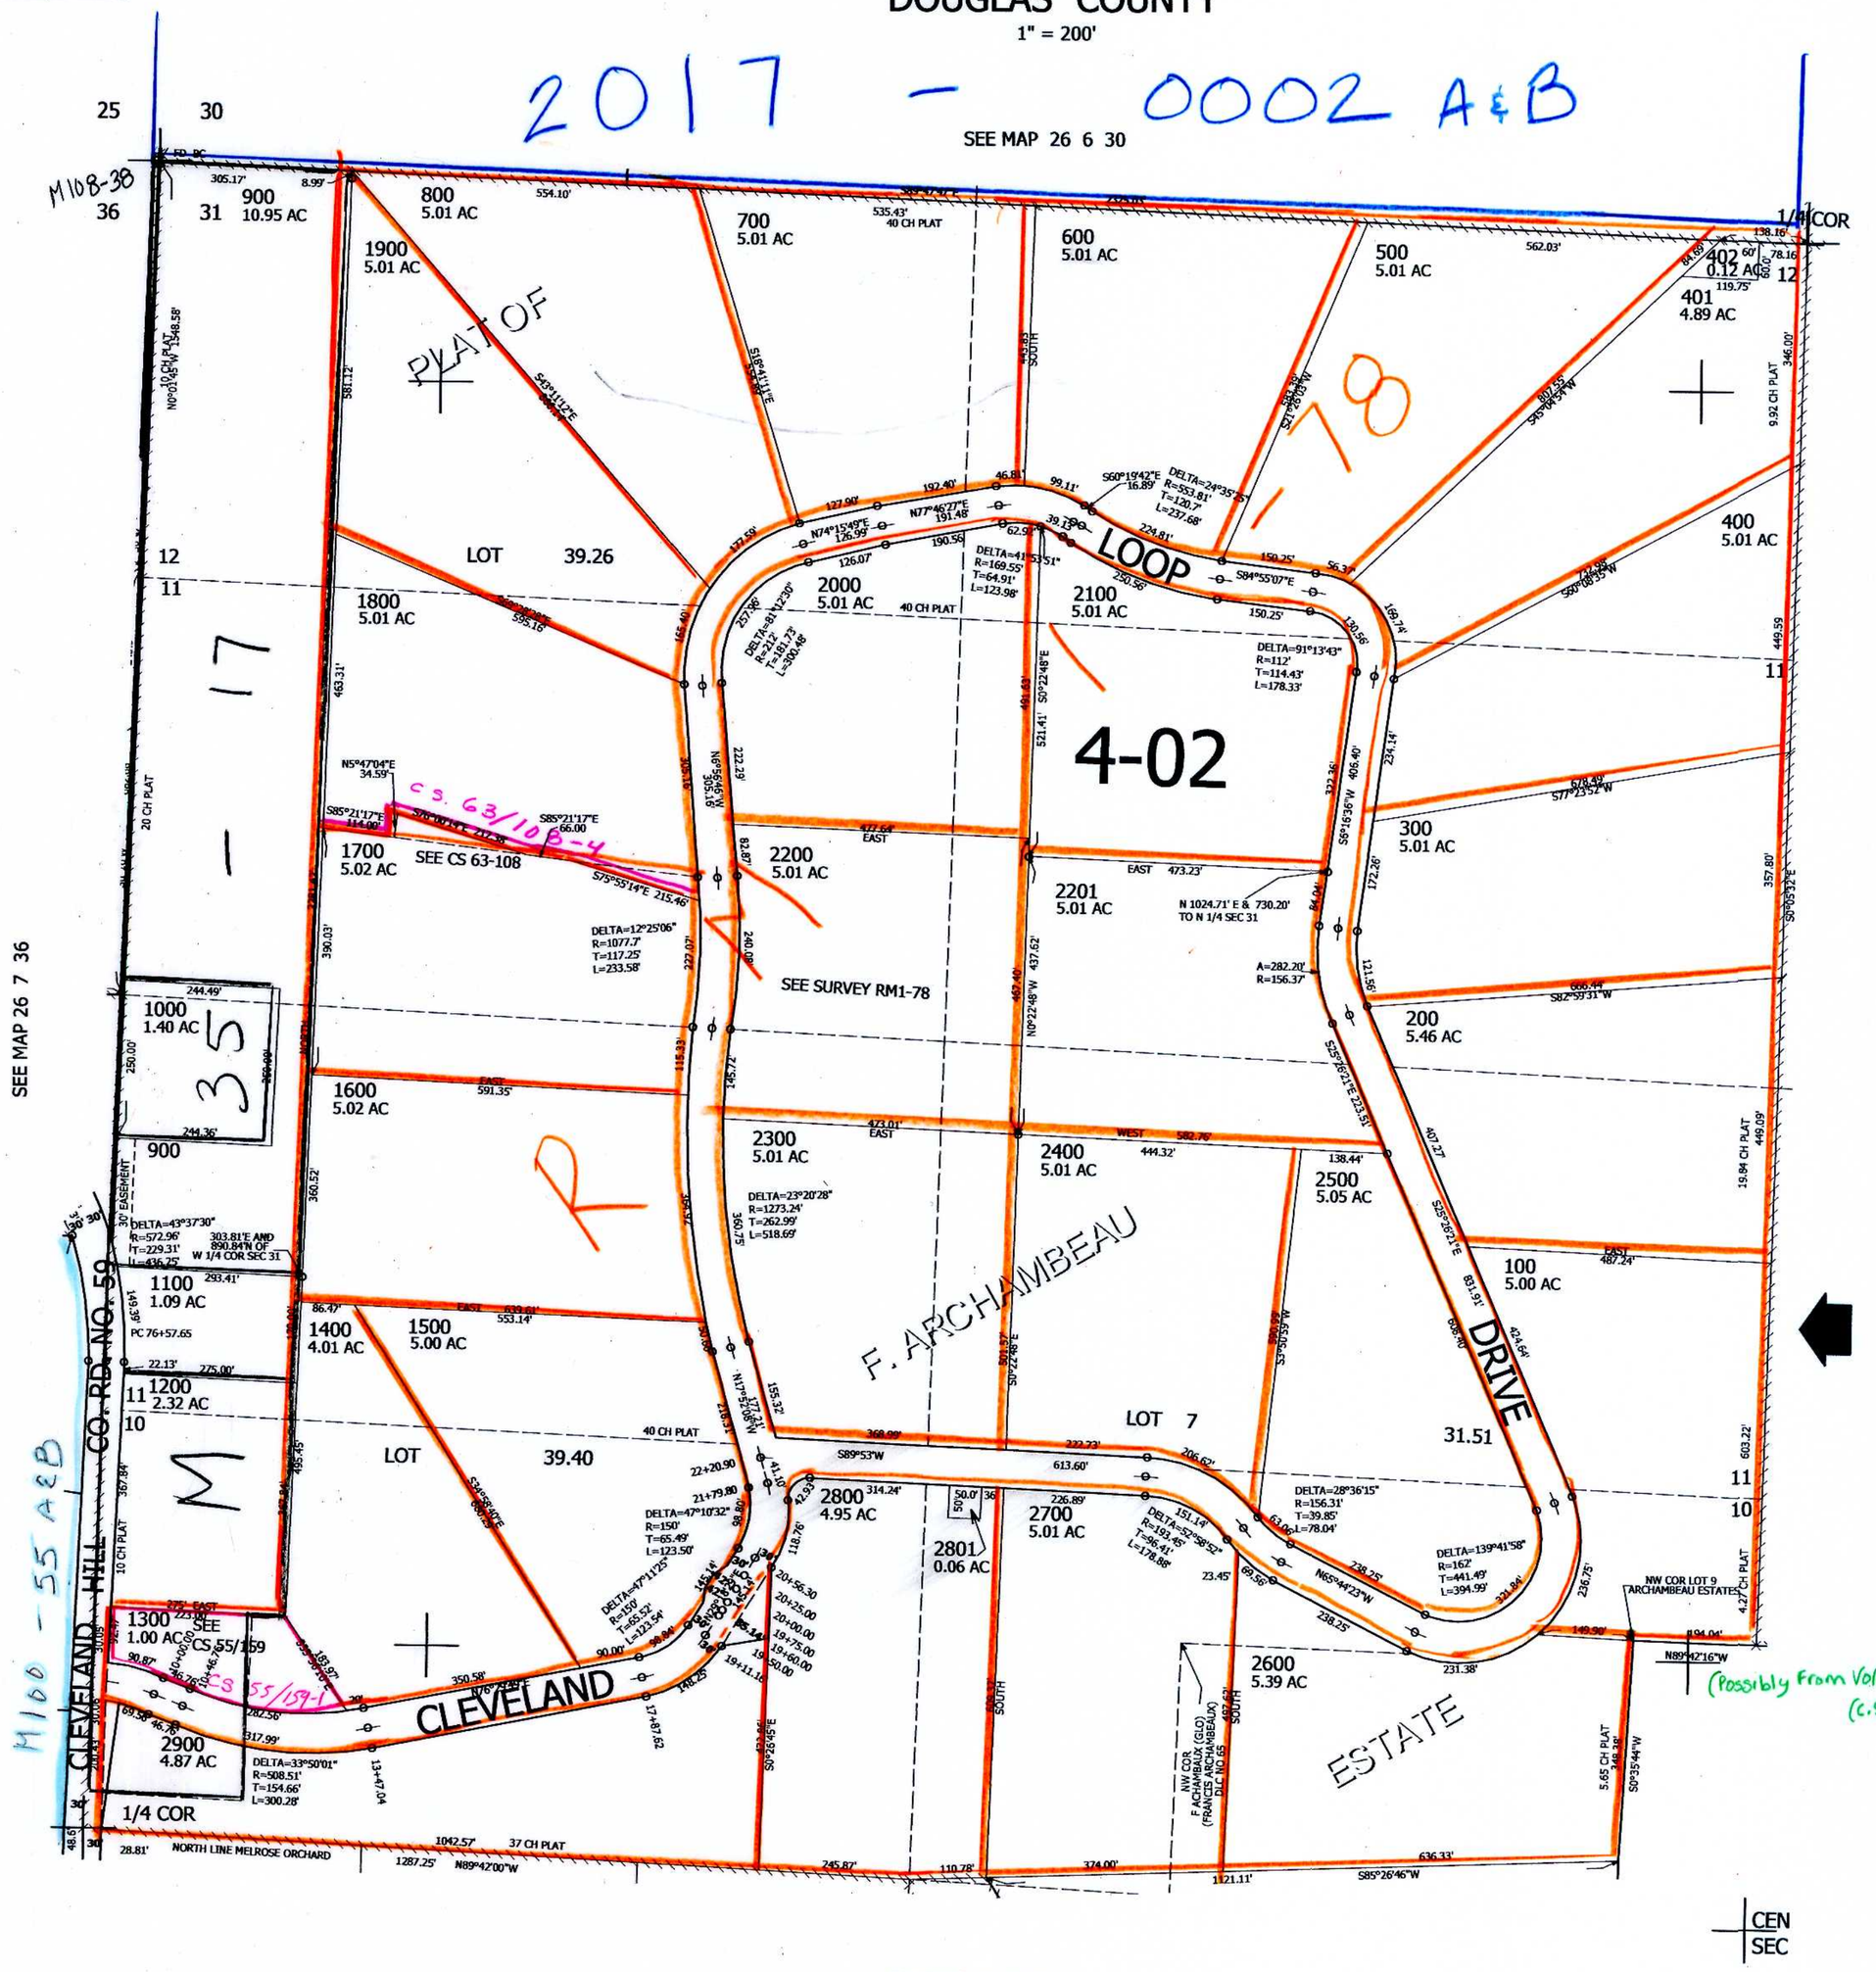

26 6 31B