


SECTION 11 T.26S. R.7W. W.M.
DOUGLAS COUNTY

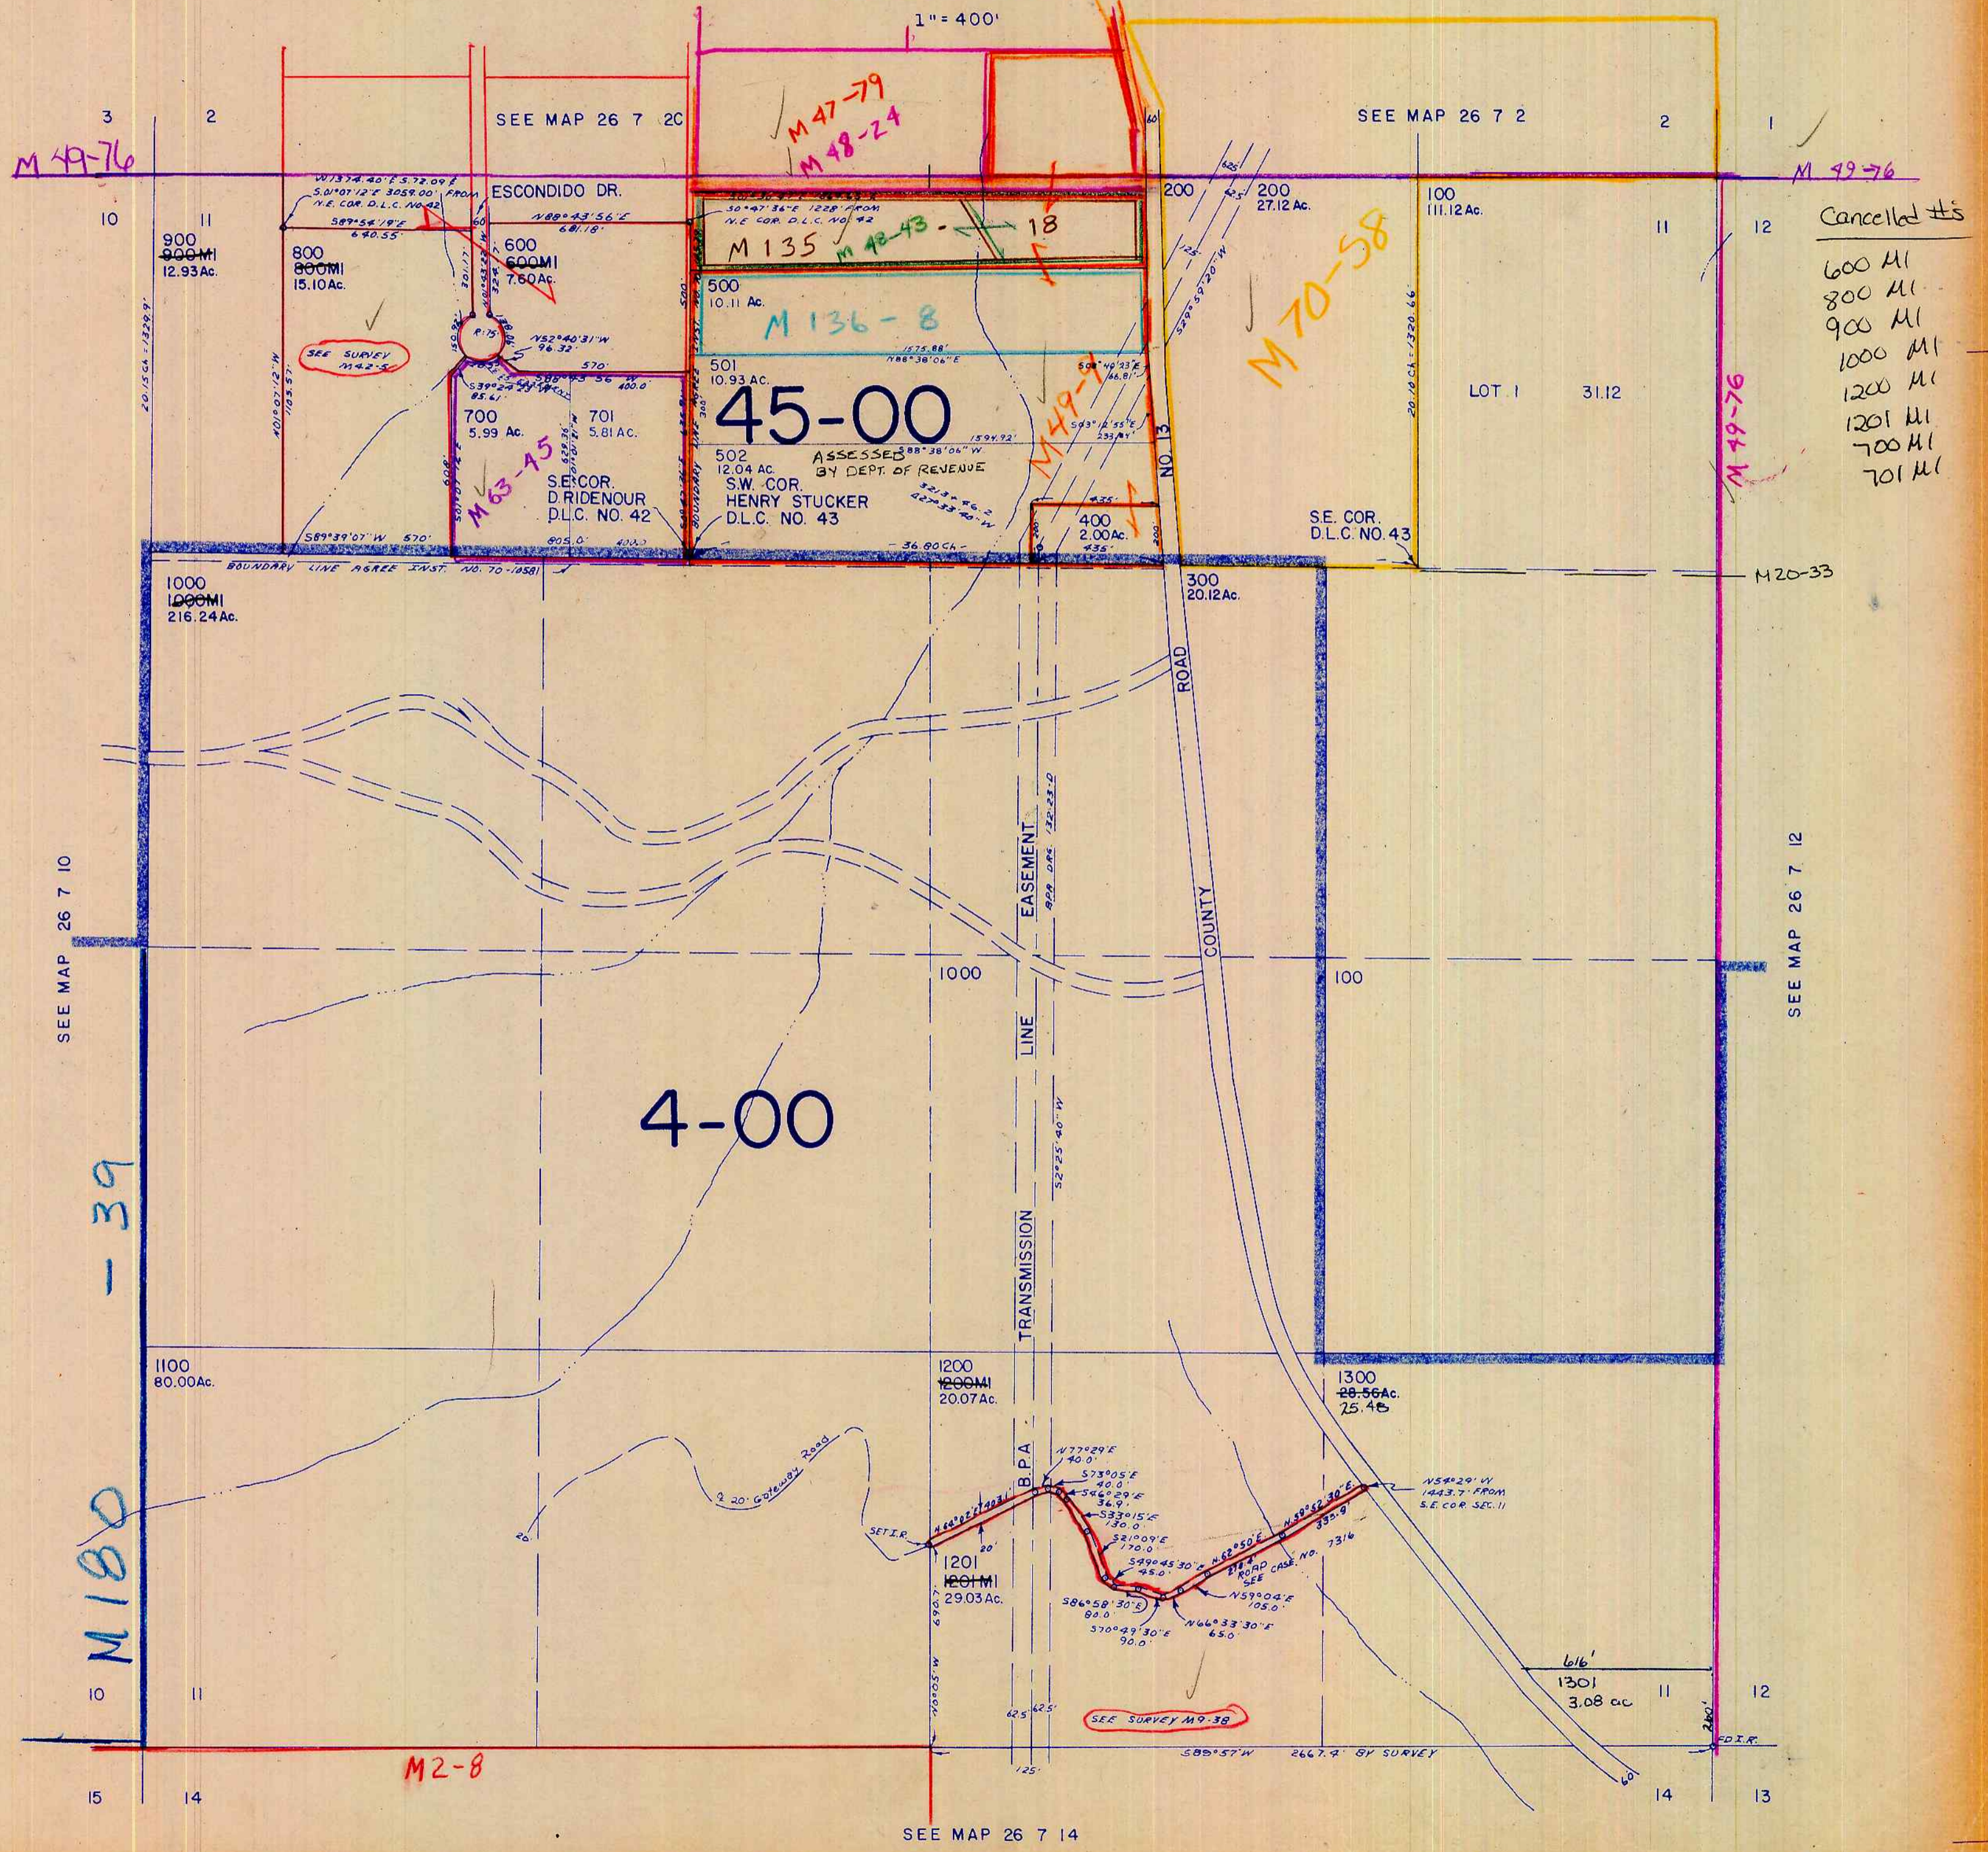

Cancelled #'s
 600 MI
 800 MI
 900 MI
 1000 MI
 1200 MI
 1201 MI
 700 MI
 701 MI

M 49-76

M 47-79
M 48-24

M 135
M 42-43

M 136-8

45-00

M 63-45

M 70-58

M 49-76

M 20-33

SEE MAP 26 7 10

SEE MAP 26 7 12

4-00

- 39

M 180

M 2-8

SEE MAP 26 7 14

CONTROL II 12/75 LAYOUT BC 8/74 CHECKED BY