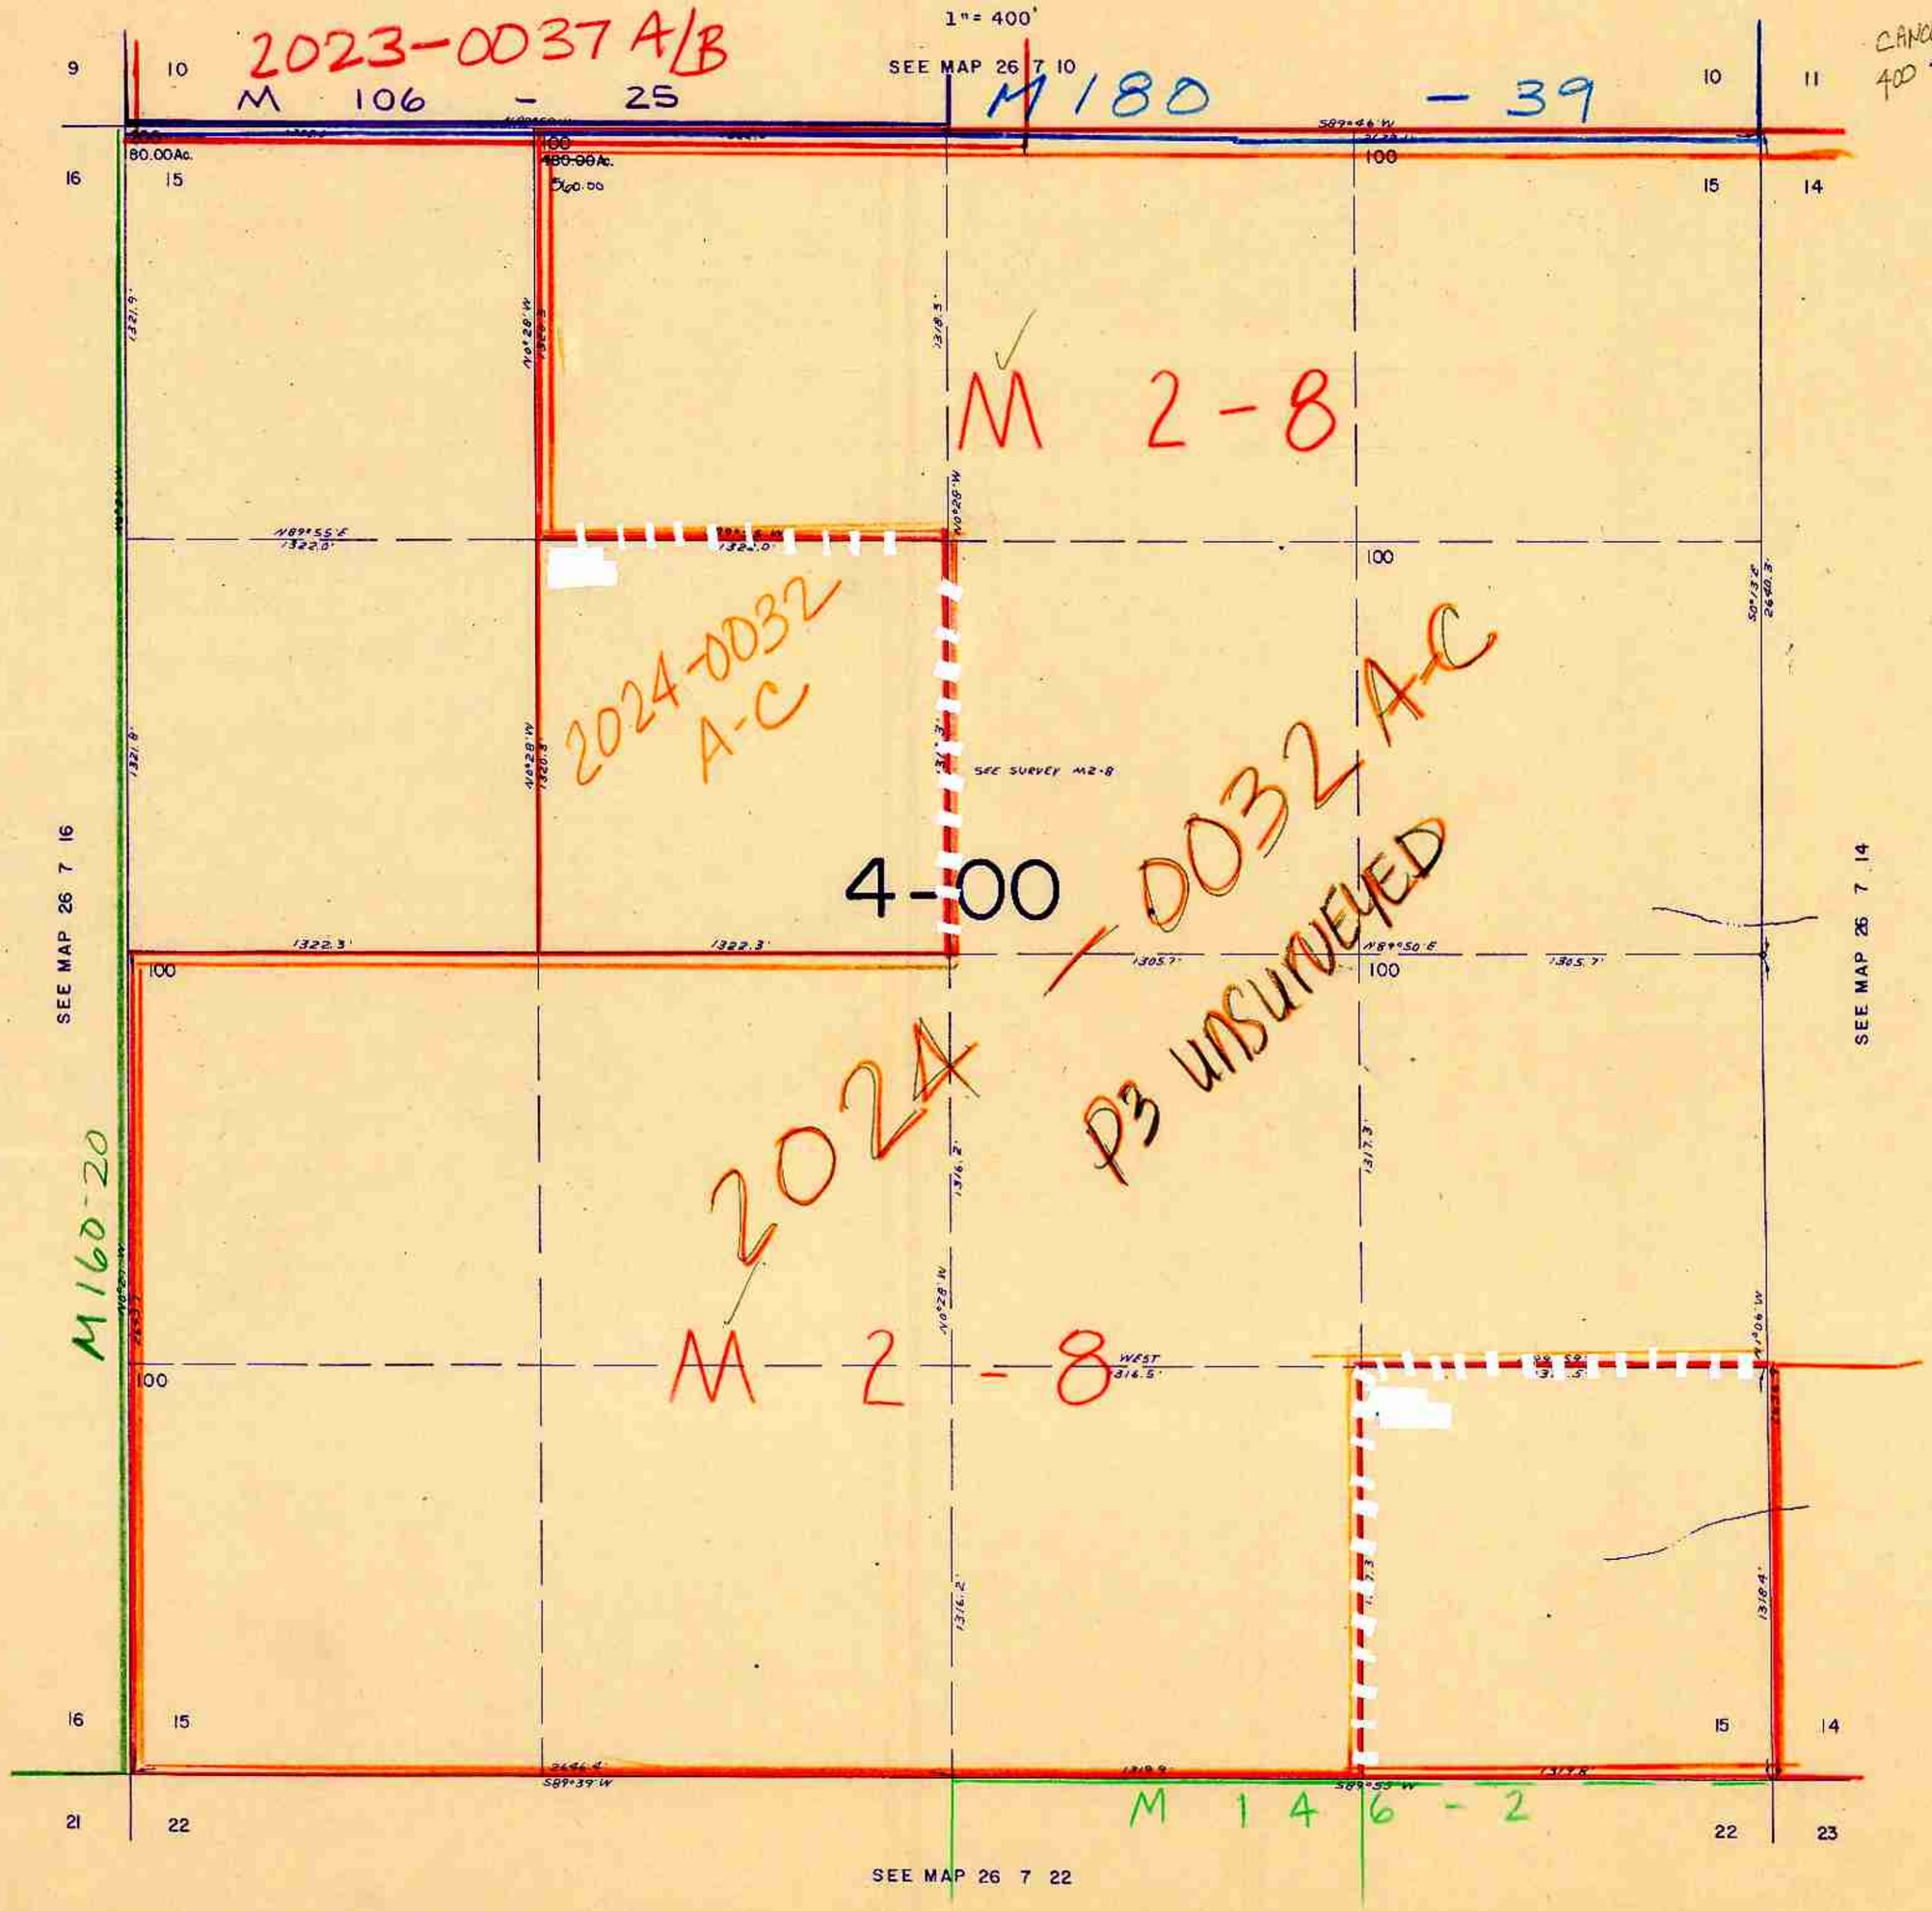SECTION 15 T.26S. R.7W. W.M.
DOUGLAS COUNTY
1" = 400'