NW1/4 SEC. 24 T.26S. R.7W. W.M.
DOUGLAS COUNTY
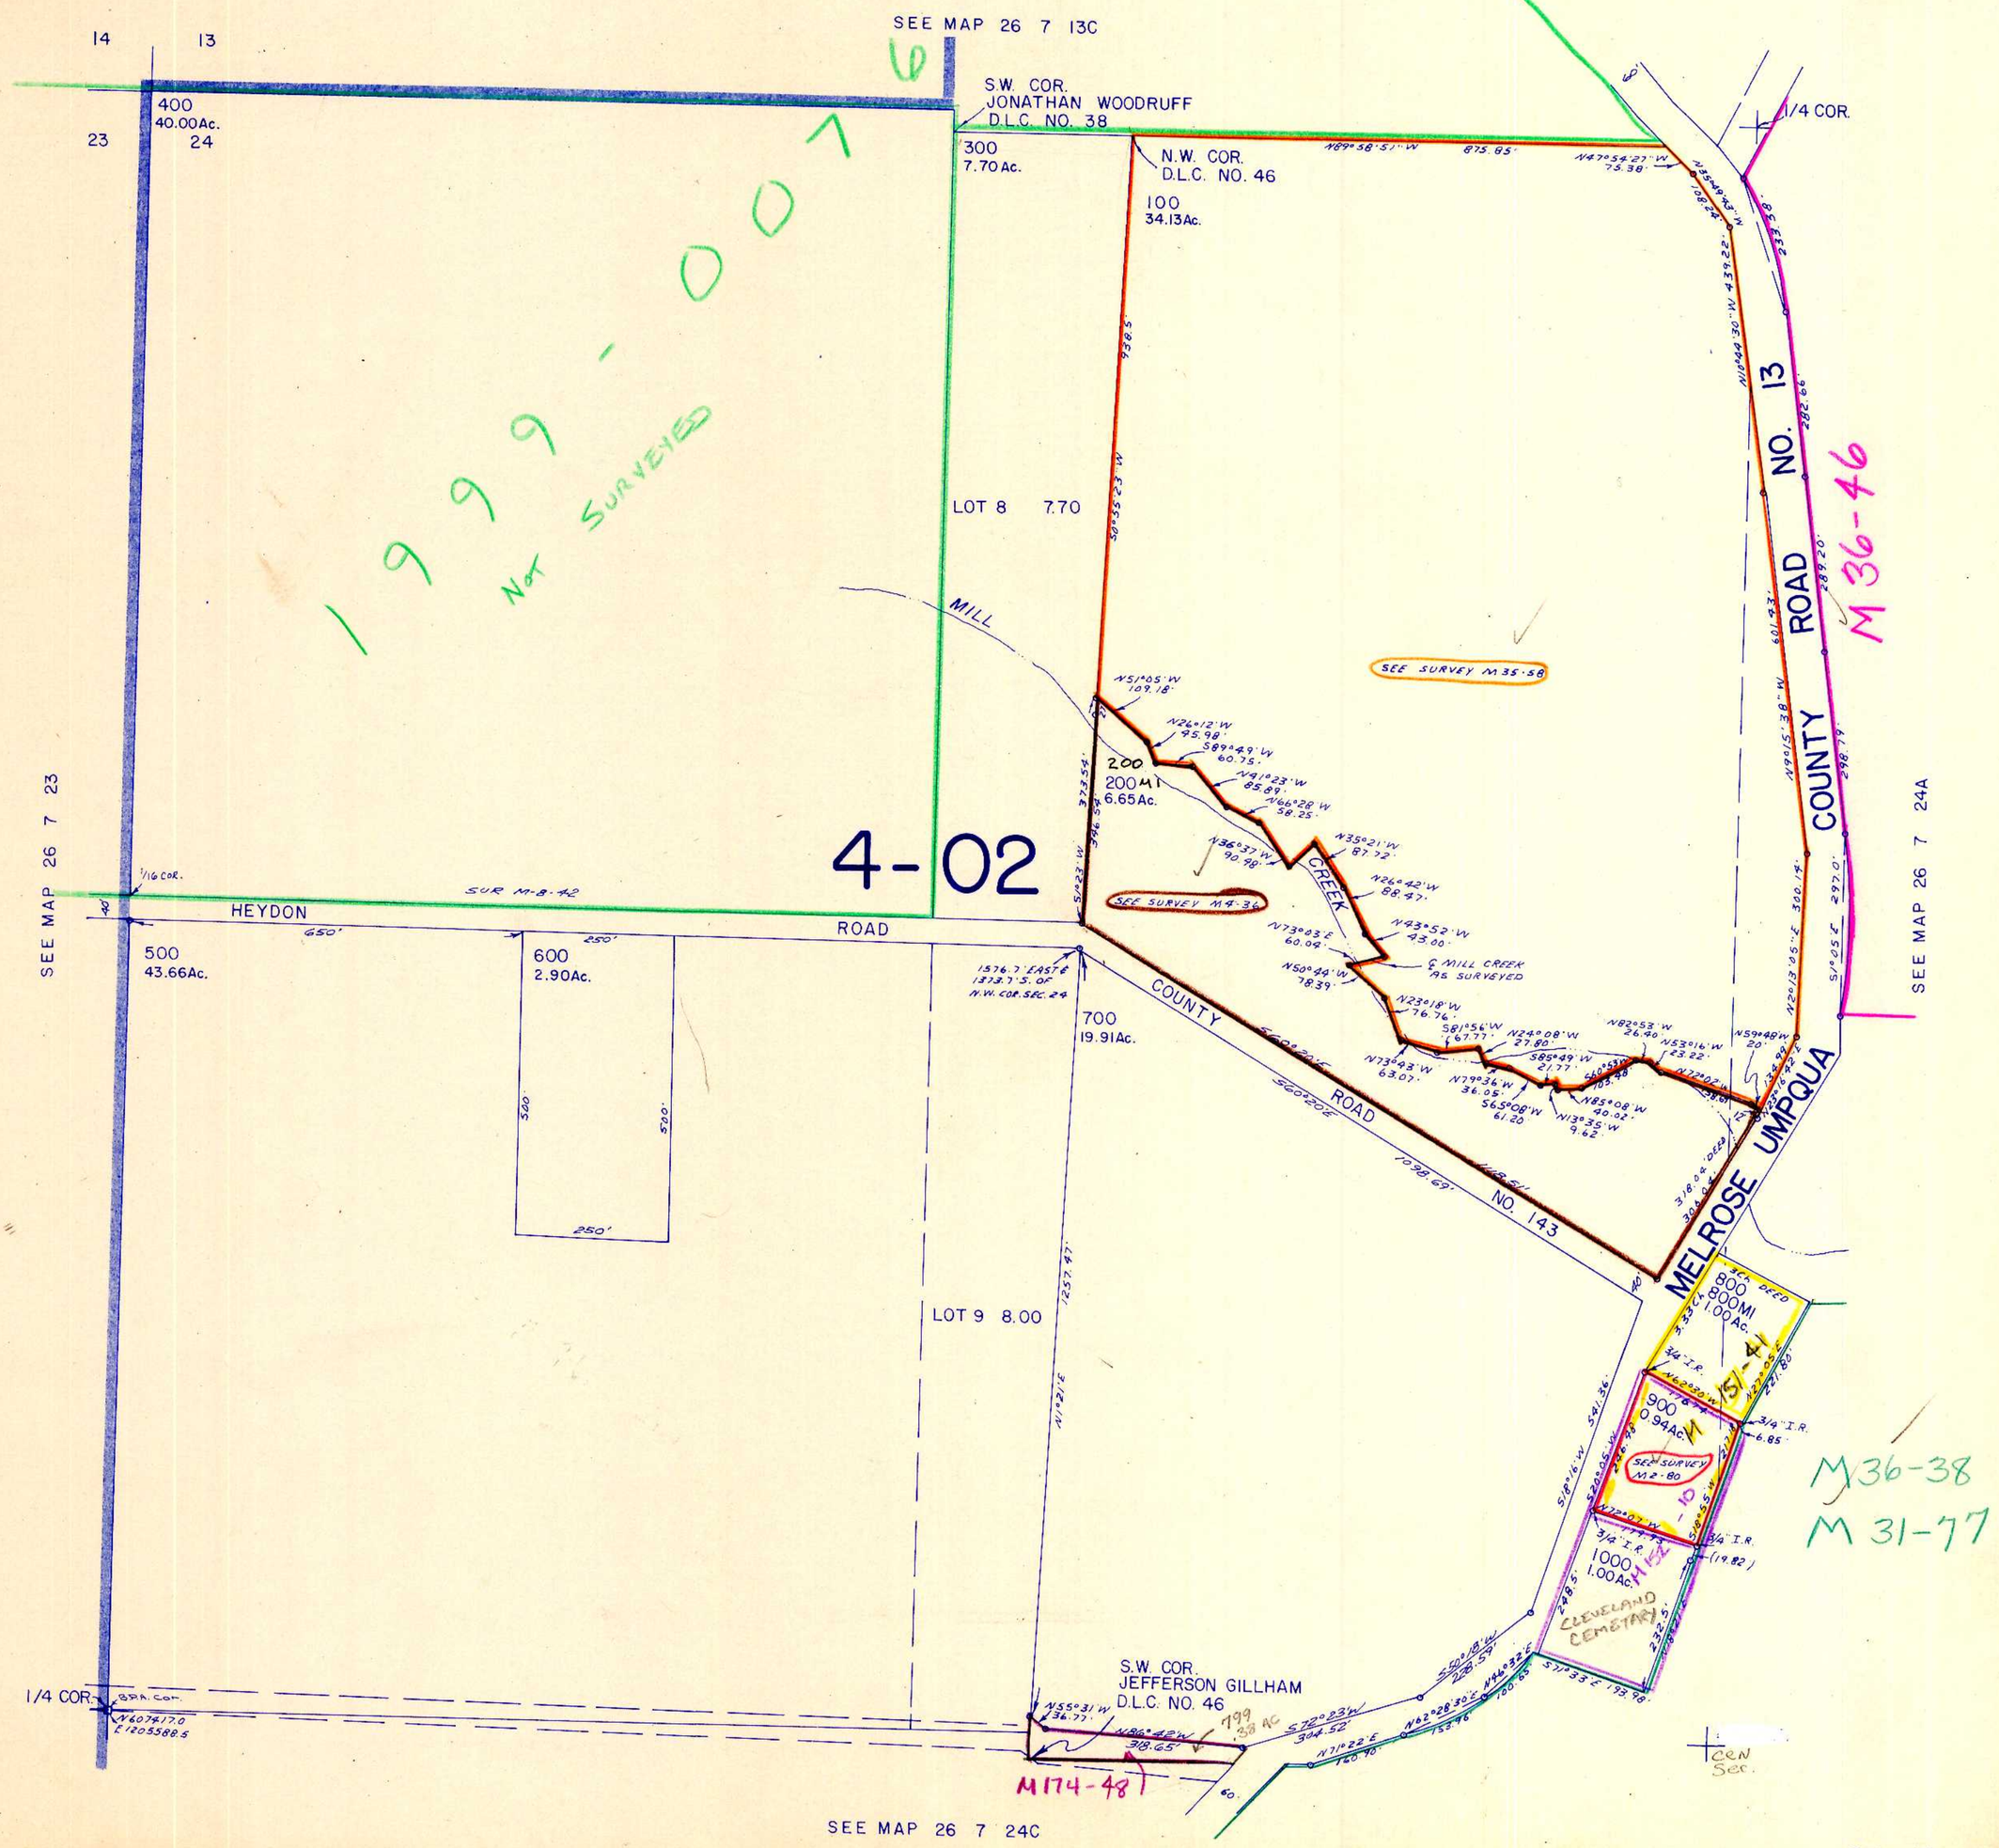
1" = 200'