SECTION 27 T.26S. R.7W. W.M.
DOUGLAS COUNTY
1" = 400'

REVISED ON 11-18-92
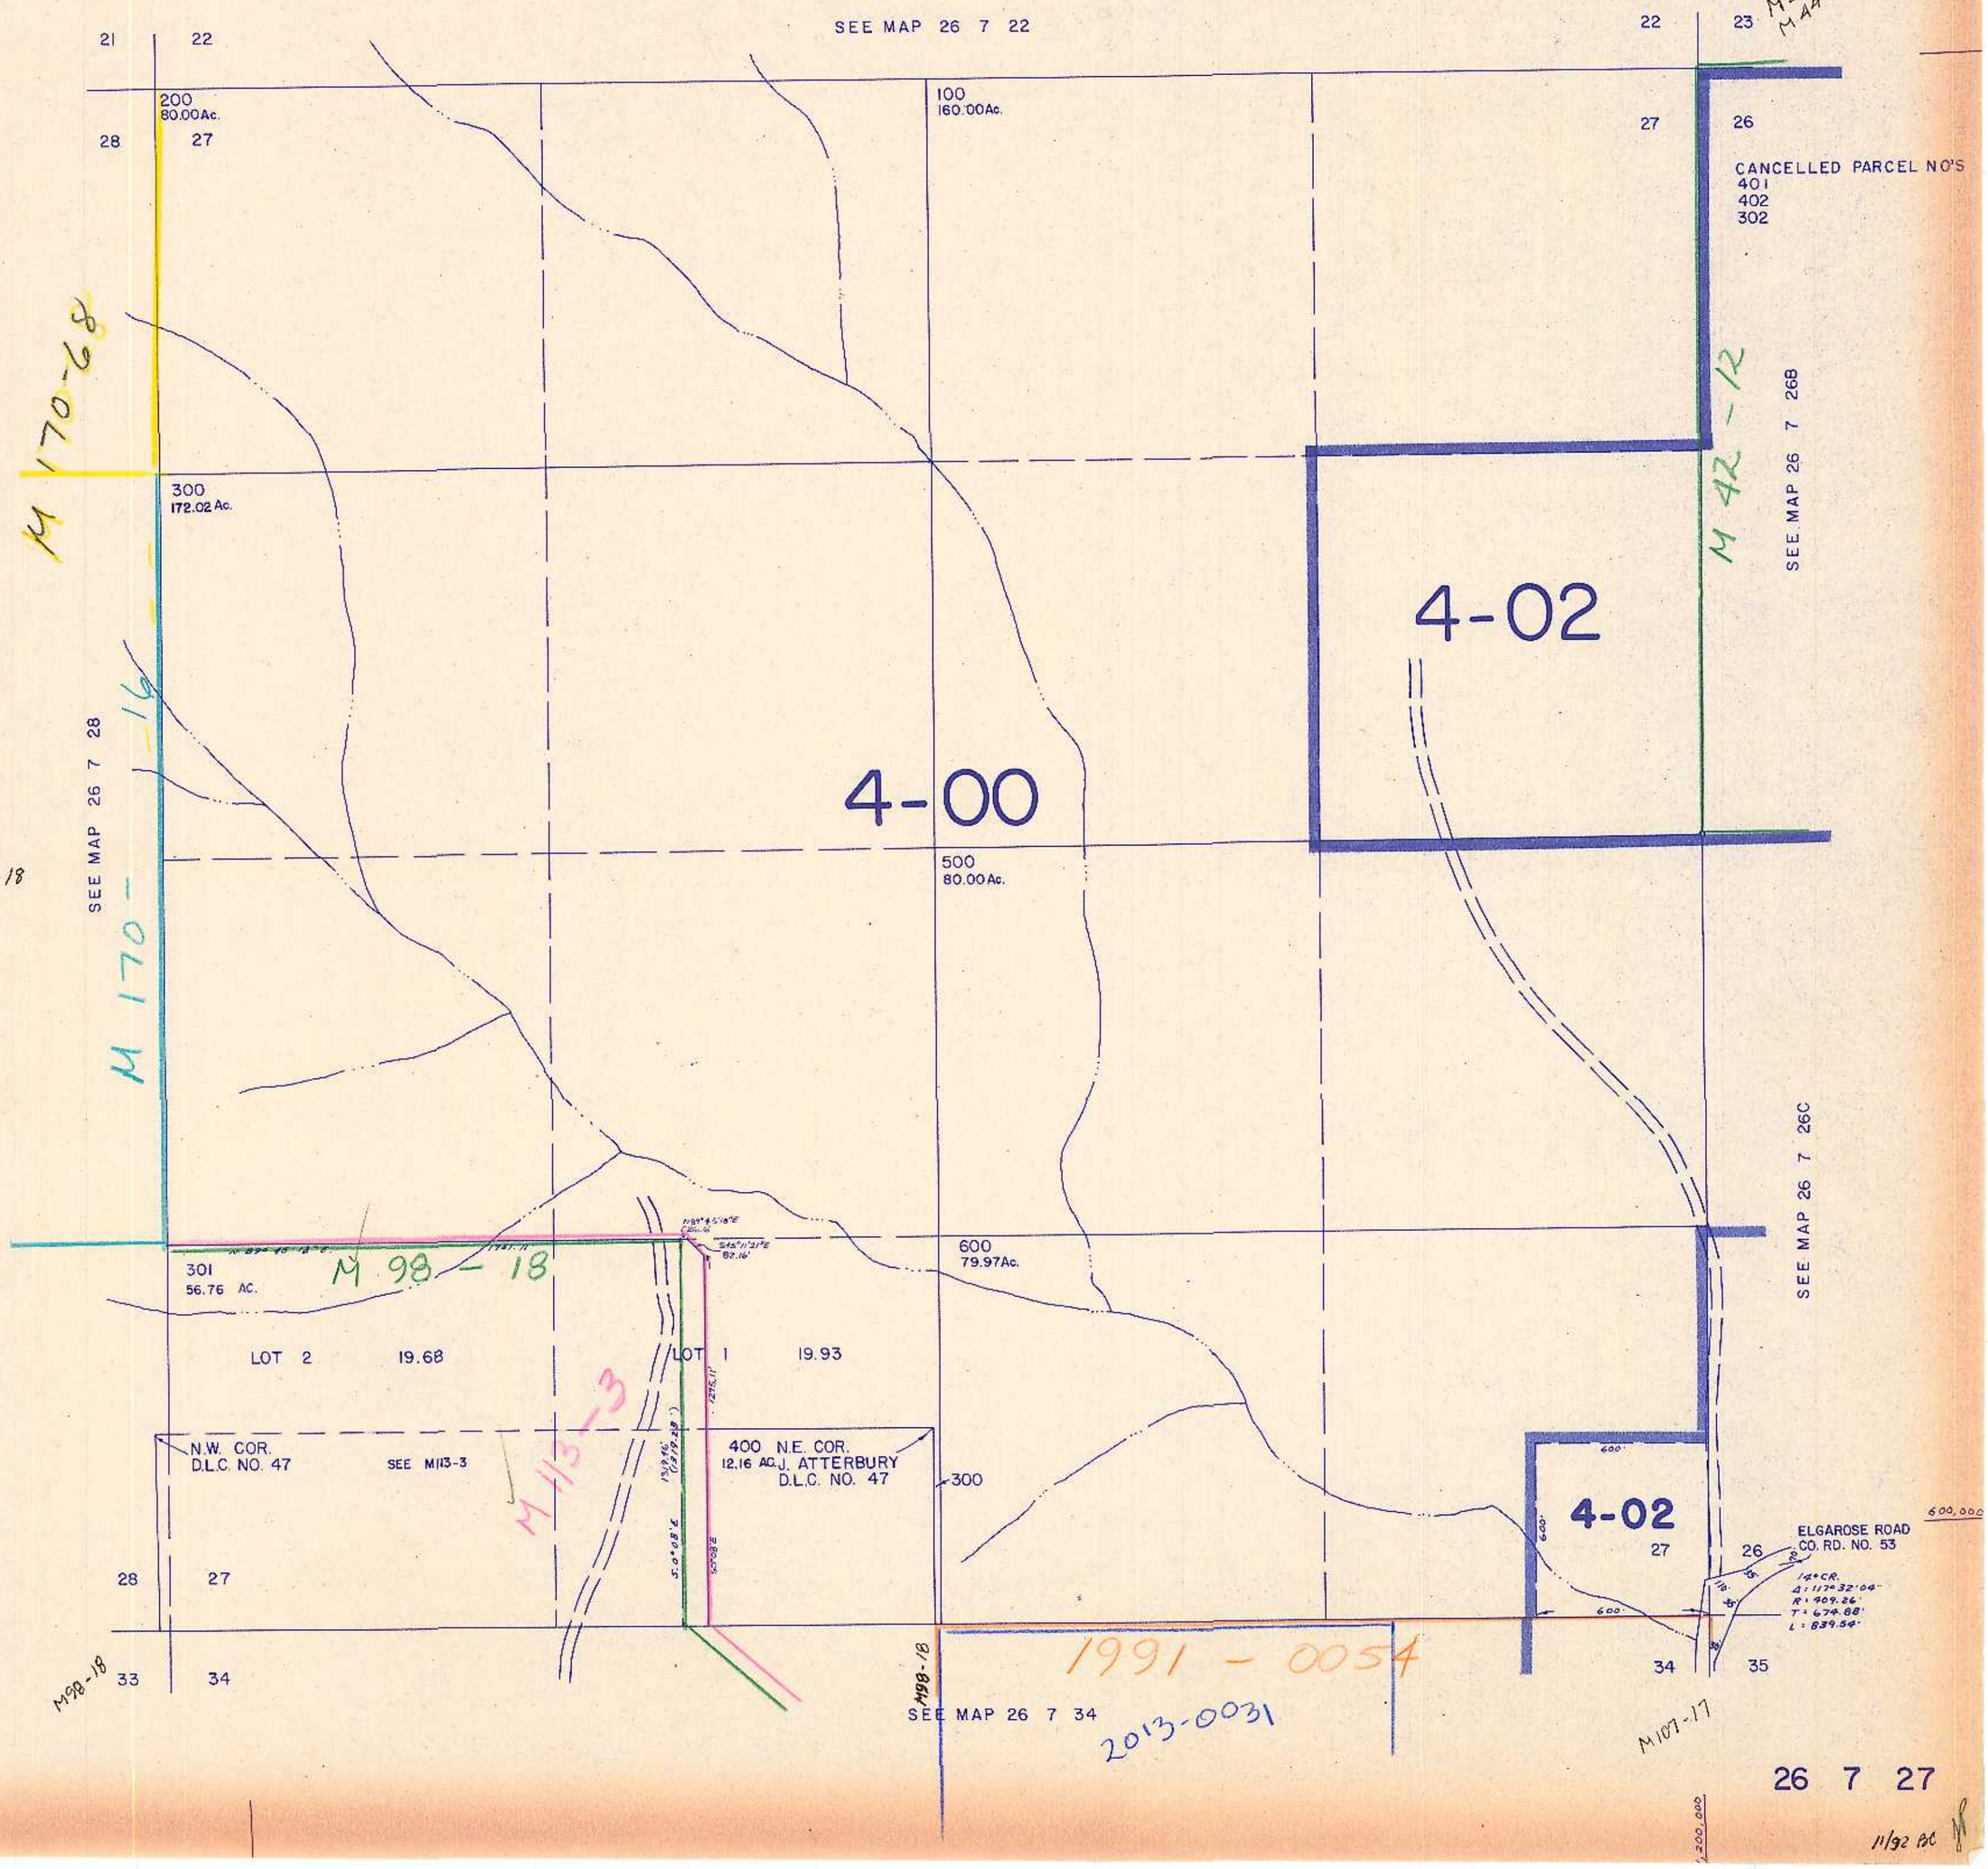
THIS MAP WAS PREPARED FOR ASSESSMENT PURPOSE ONLY.