THIS MAP WAS PREPARED FOR ASSESSMENT PURPOSE ONLY.

NW1/4 SEC.35 T.26S. R.7W. W.M.
DOUGLAS COUNTY

1" = 200'

REVISED ON 3-12-13

26 7 35B

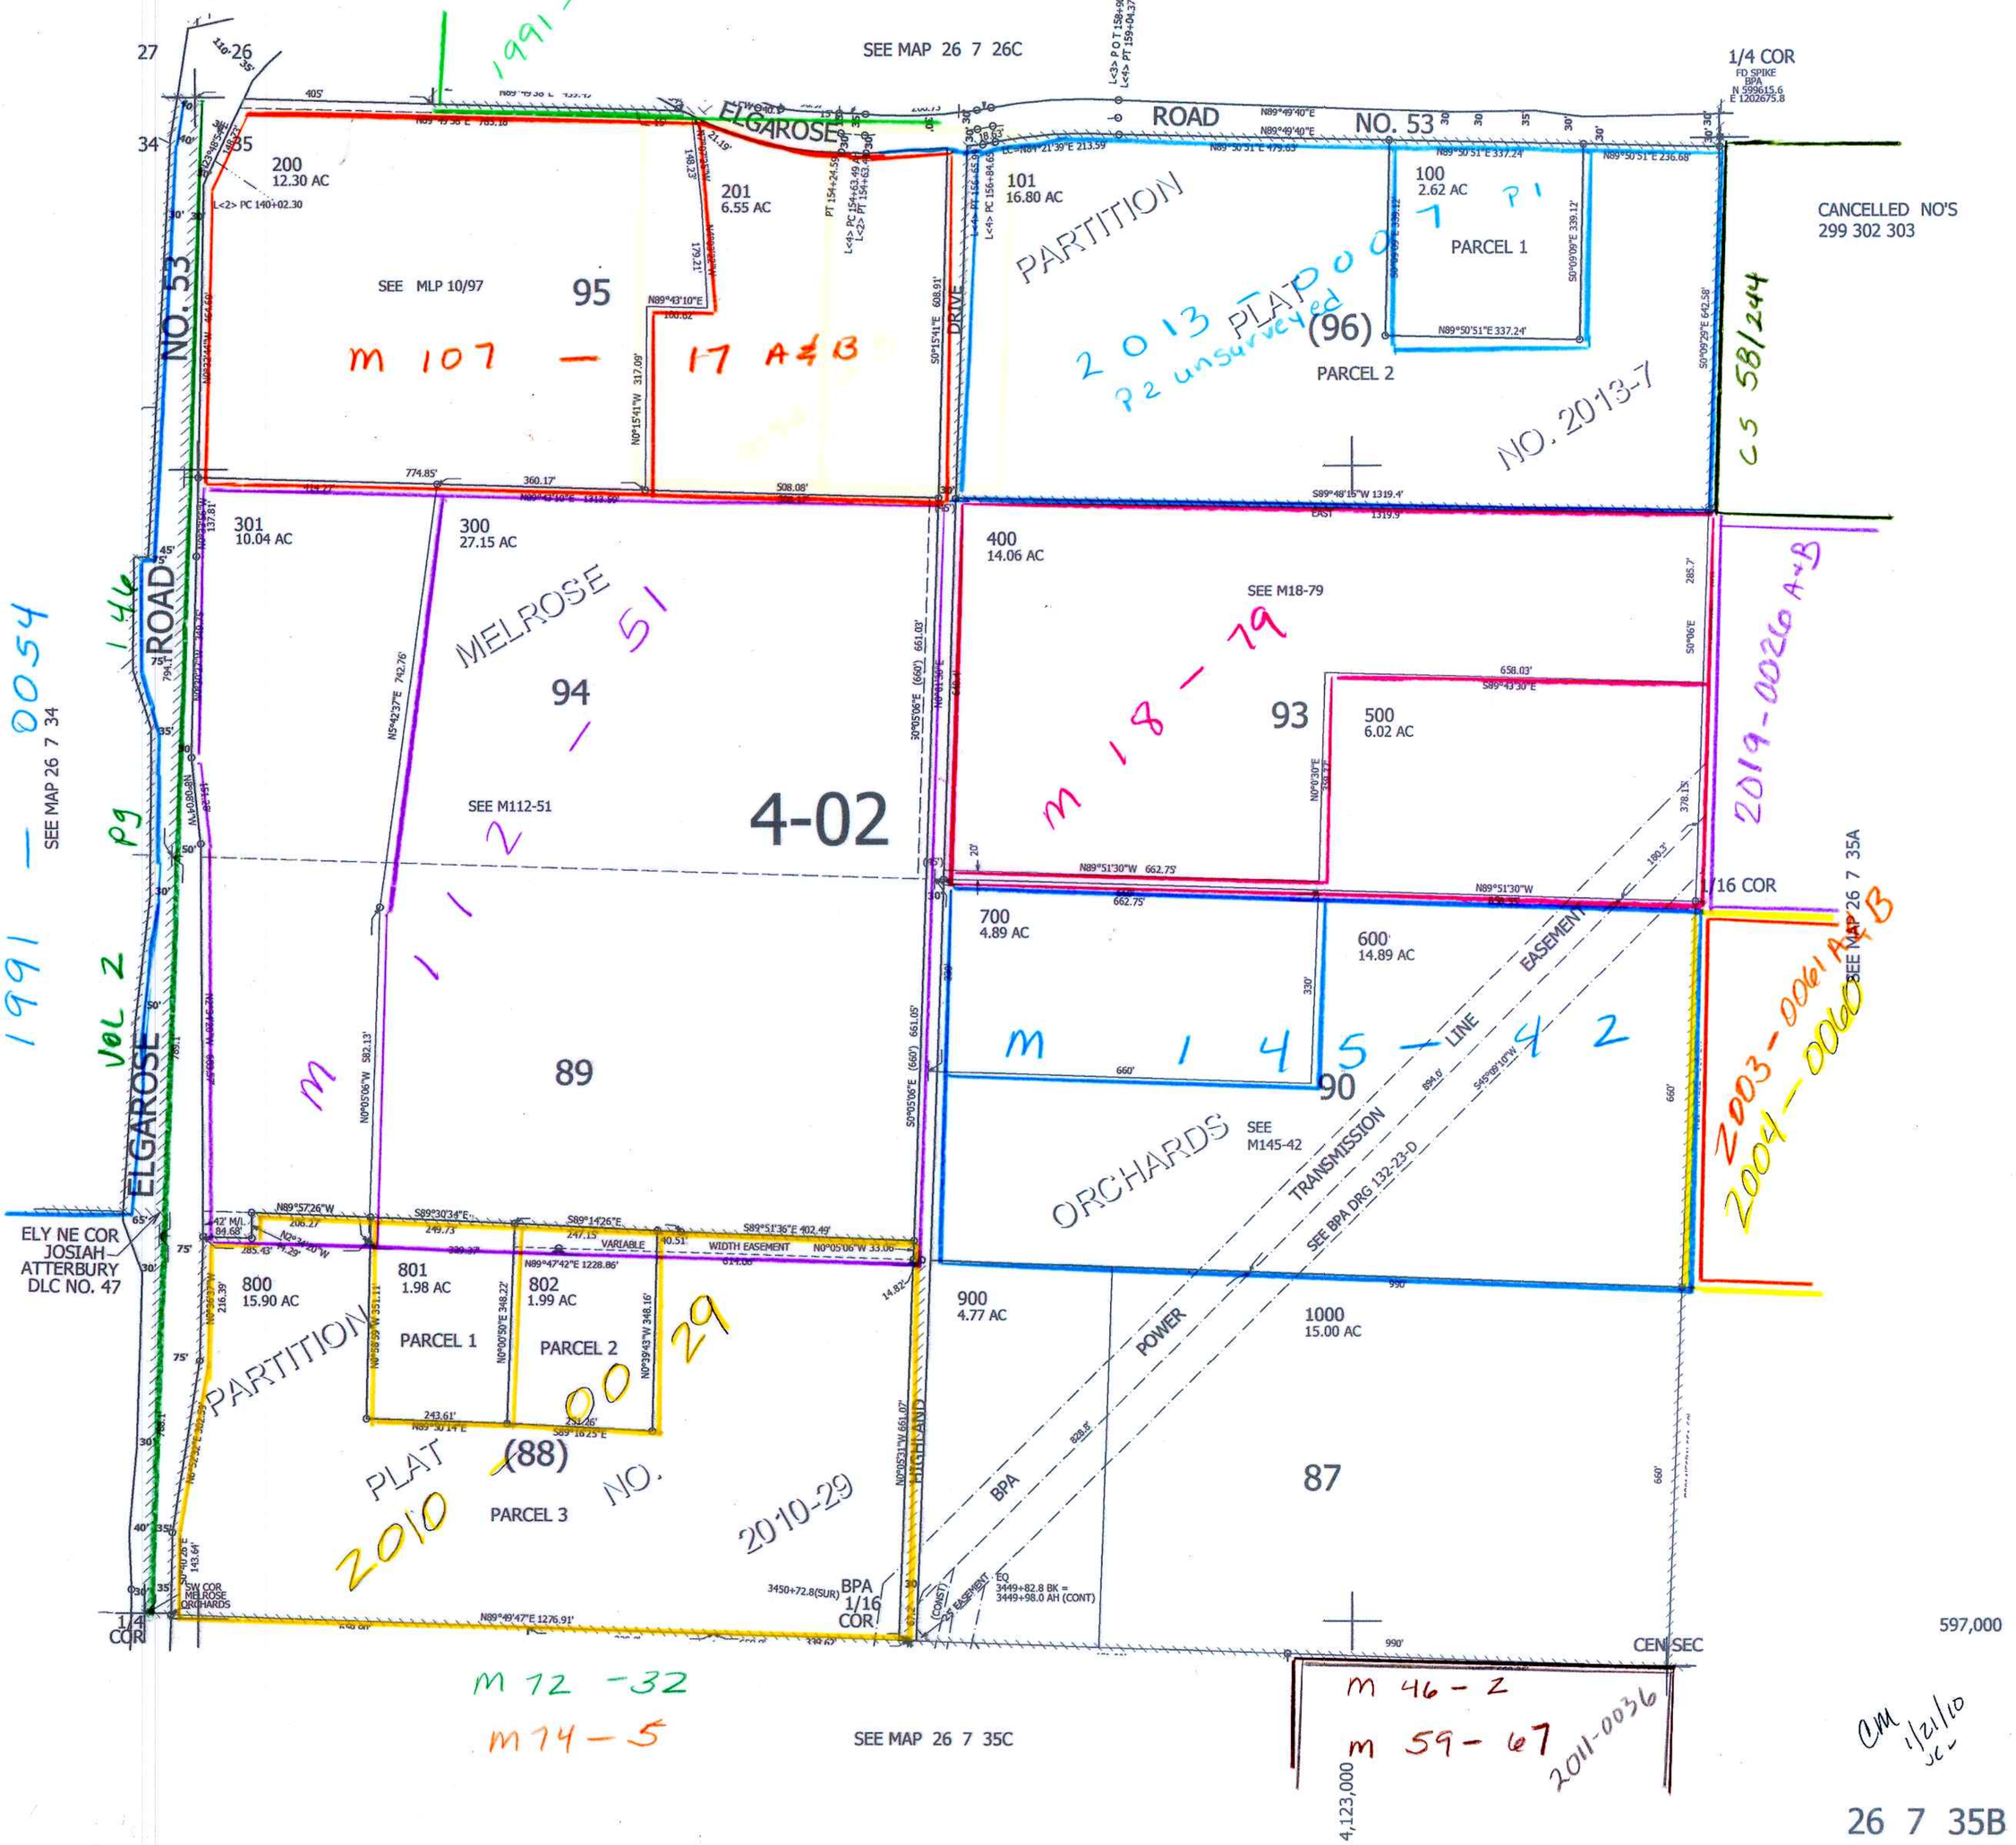

26 7 35B