


THIS MAP WAS PREPARED FOR
ASSESSMENT PURPOSE ONLY.

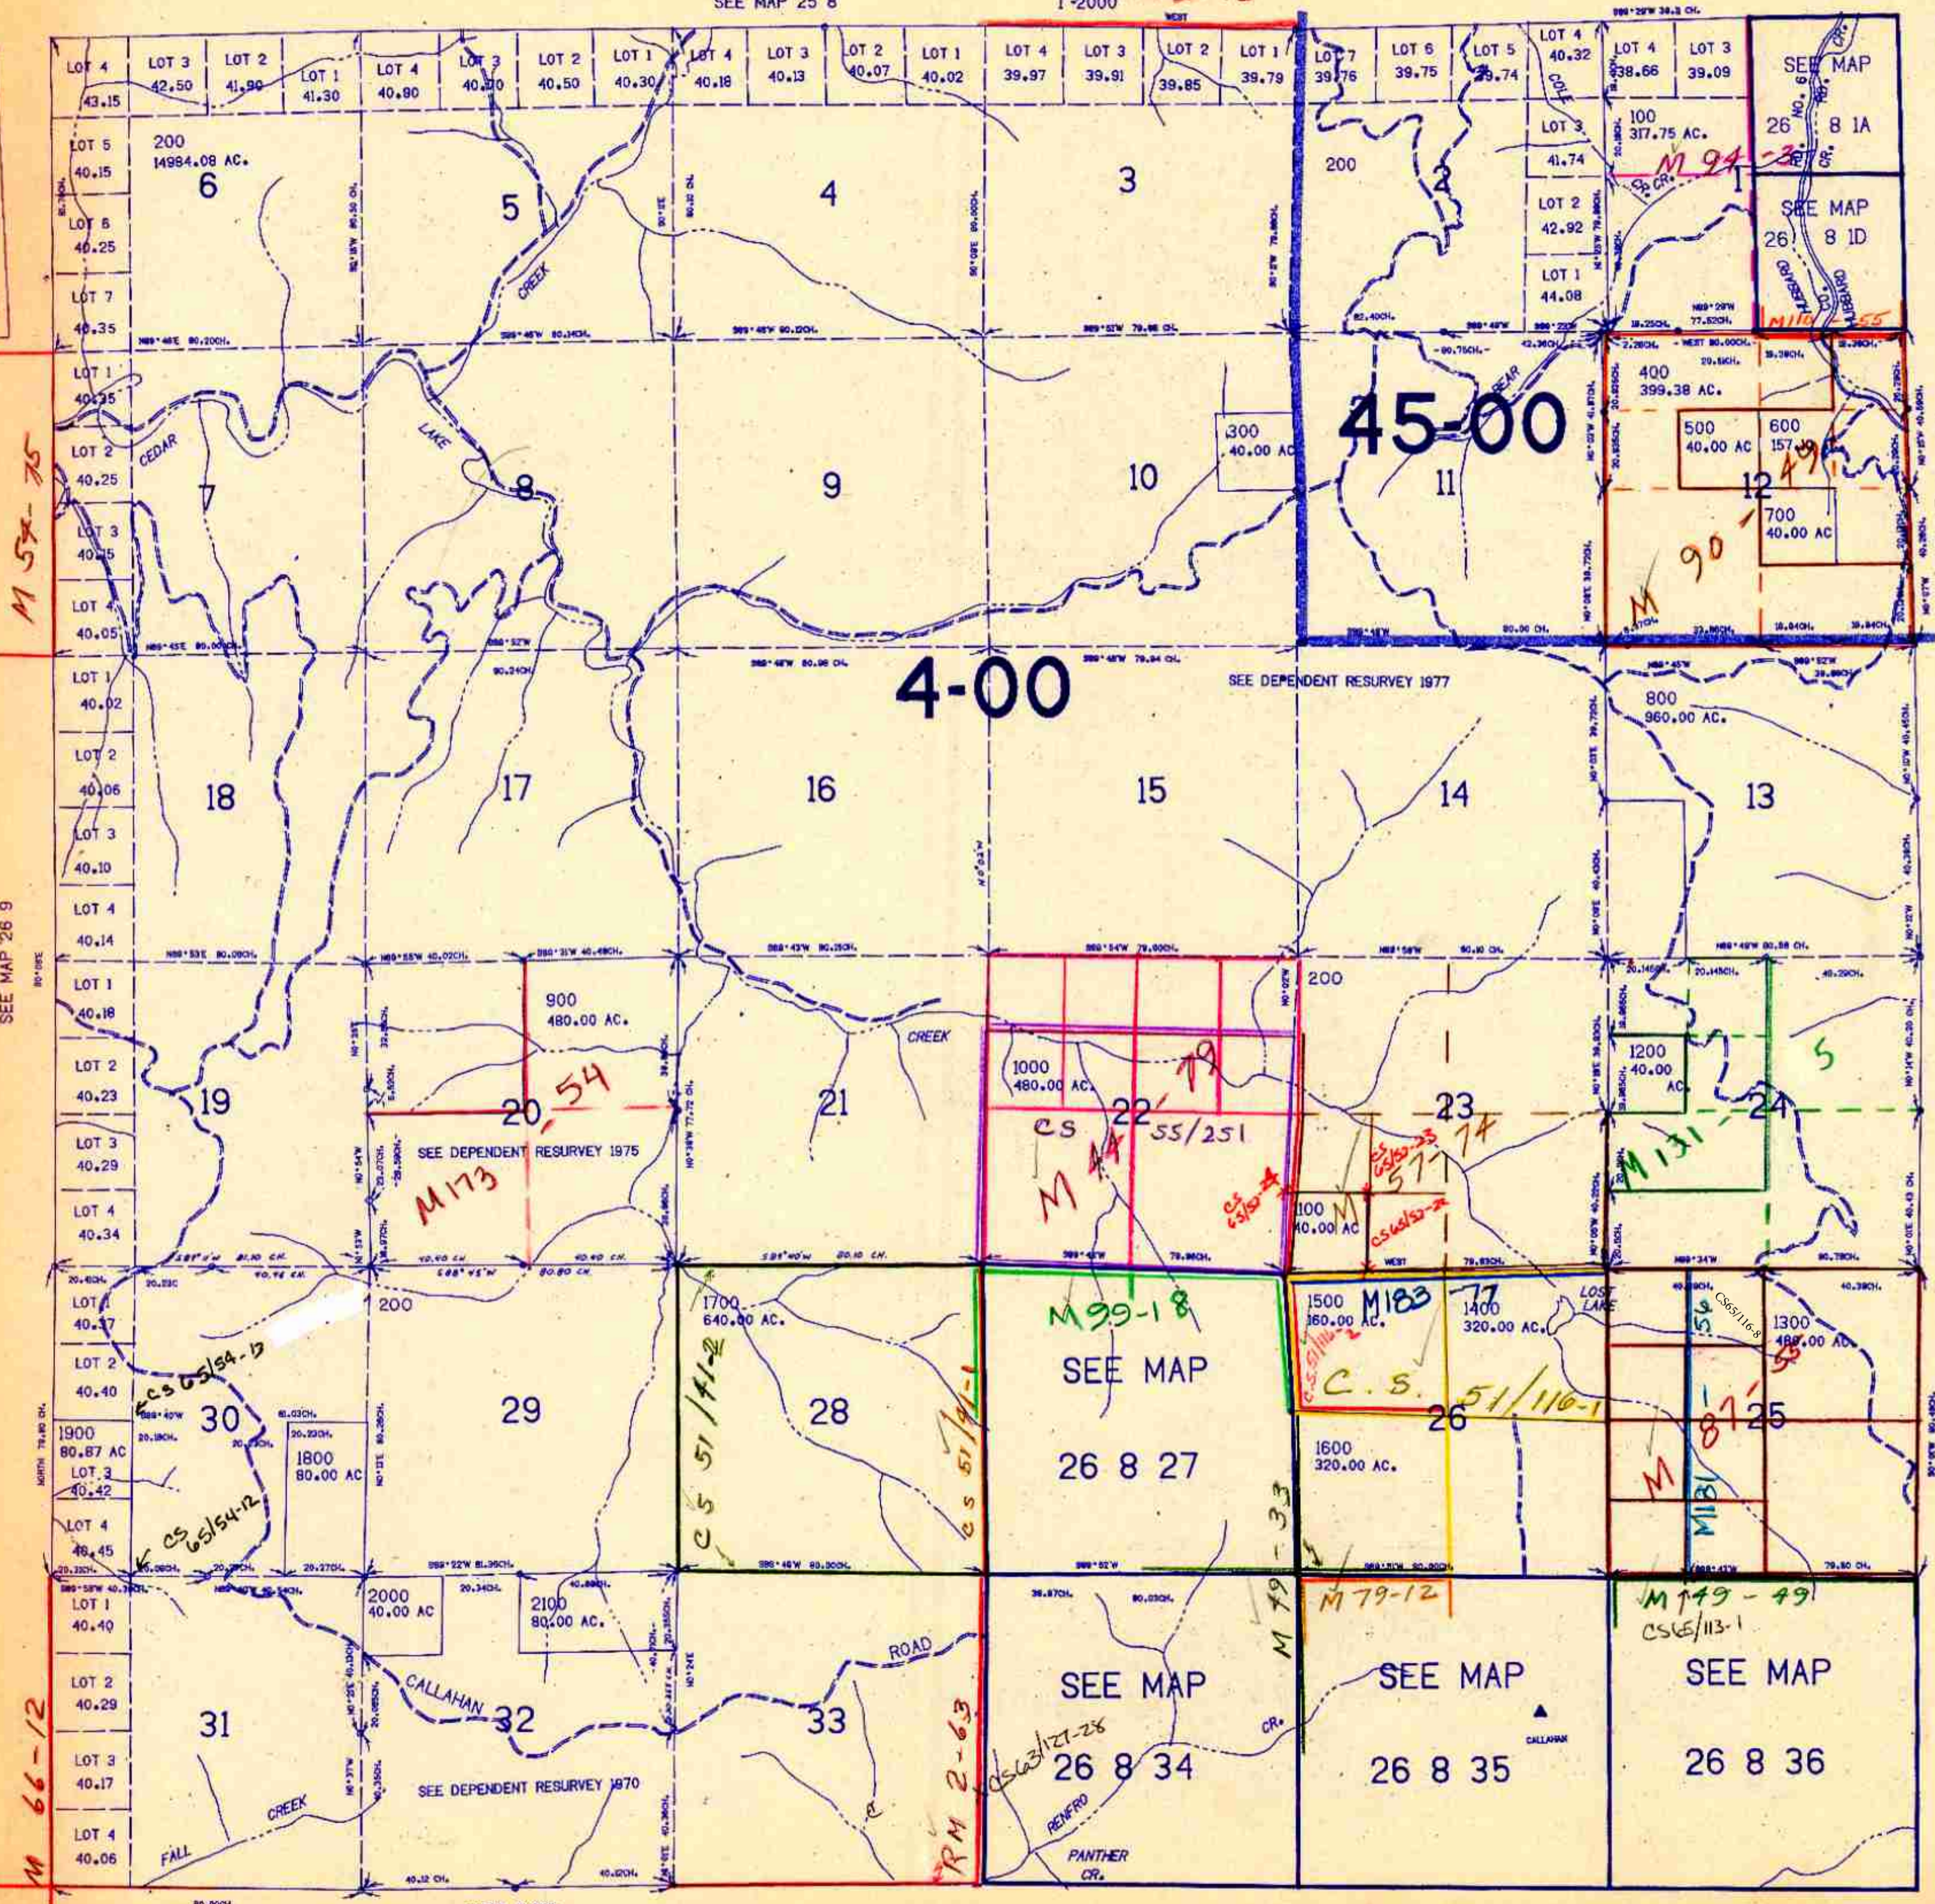

4/85