THIS MAP WAS PREPARED FOR ASSESSMENT PURPOSE ONLY

SEC. T.27S. R.1 W W.M.
DOUGLAS COUNTY

REVISED ON 27 1 00

1" = 2000'

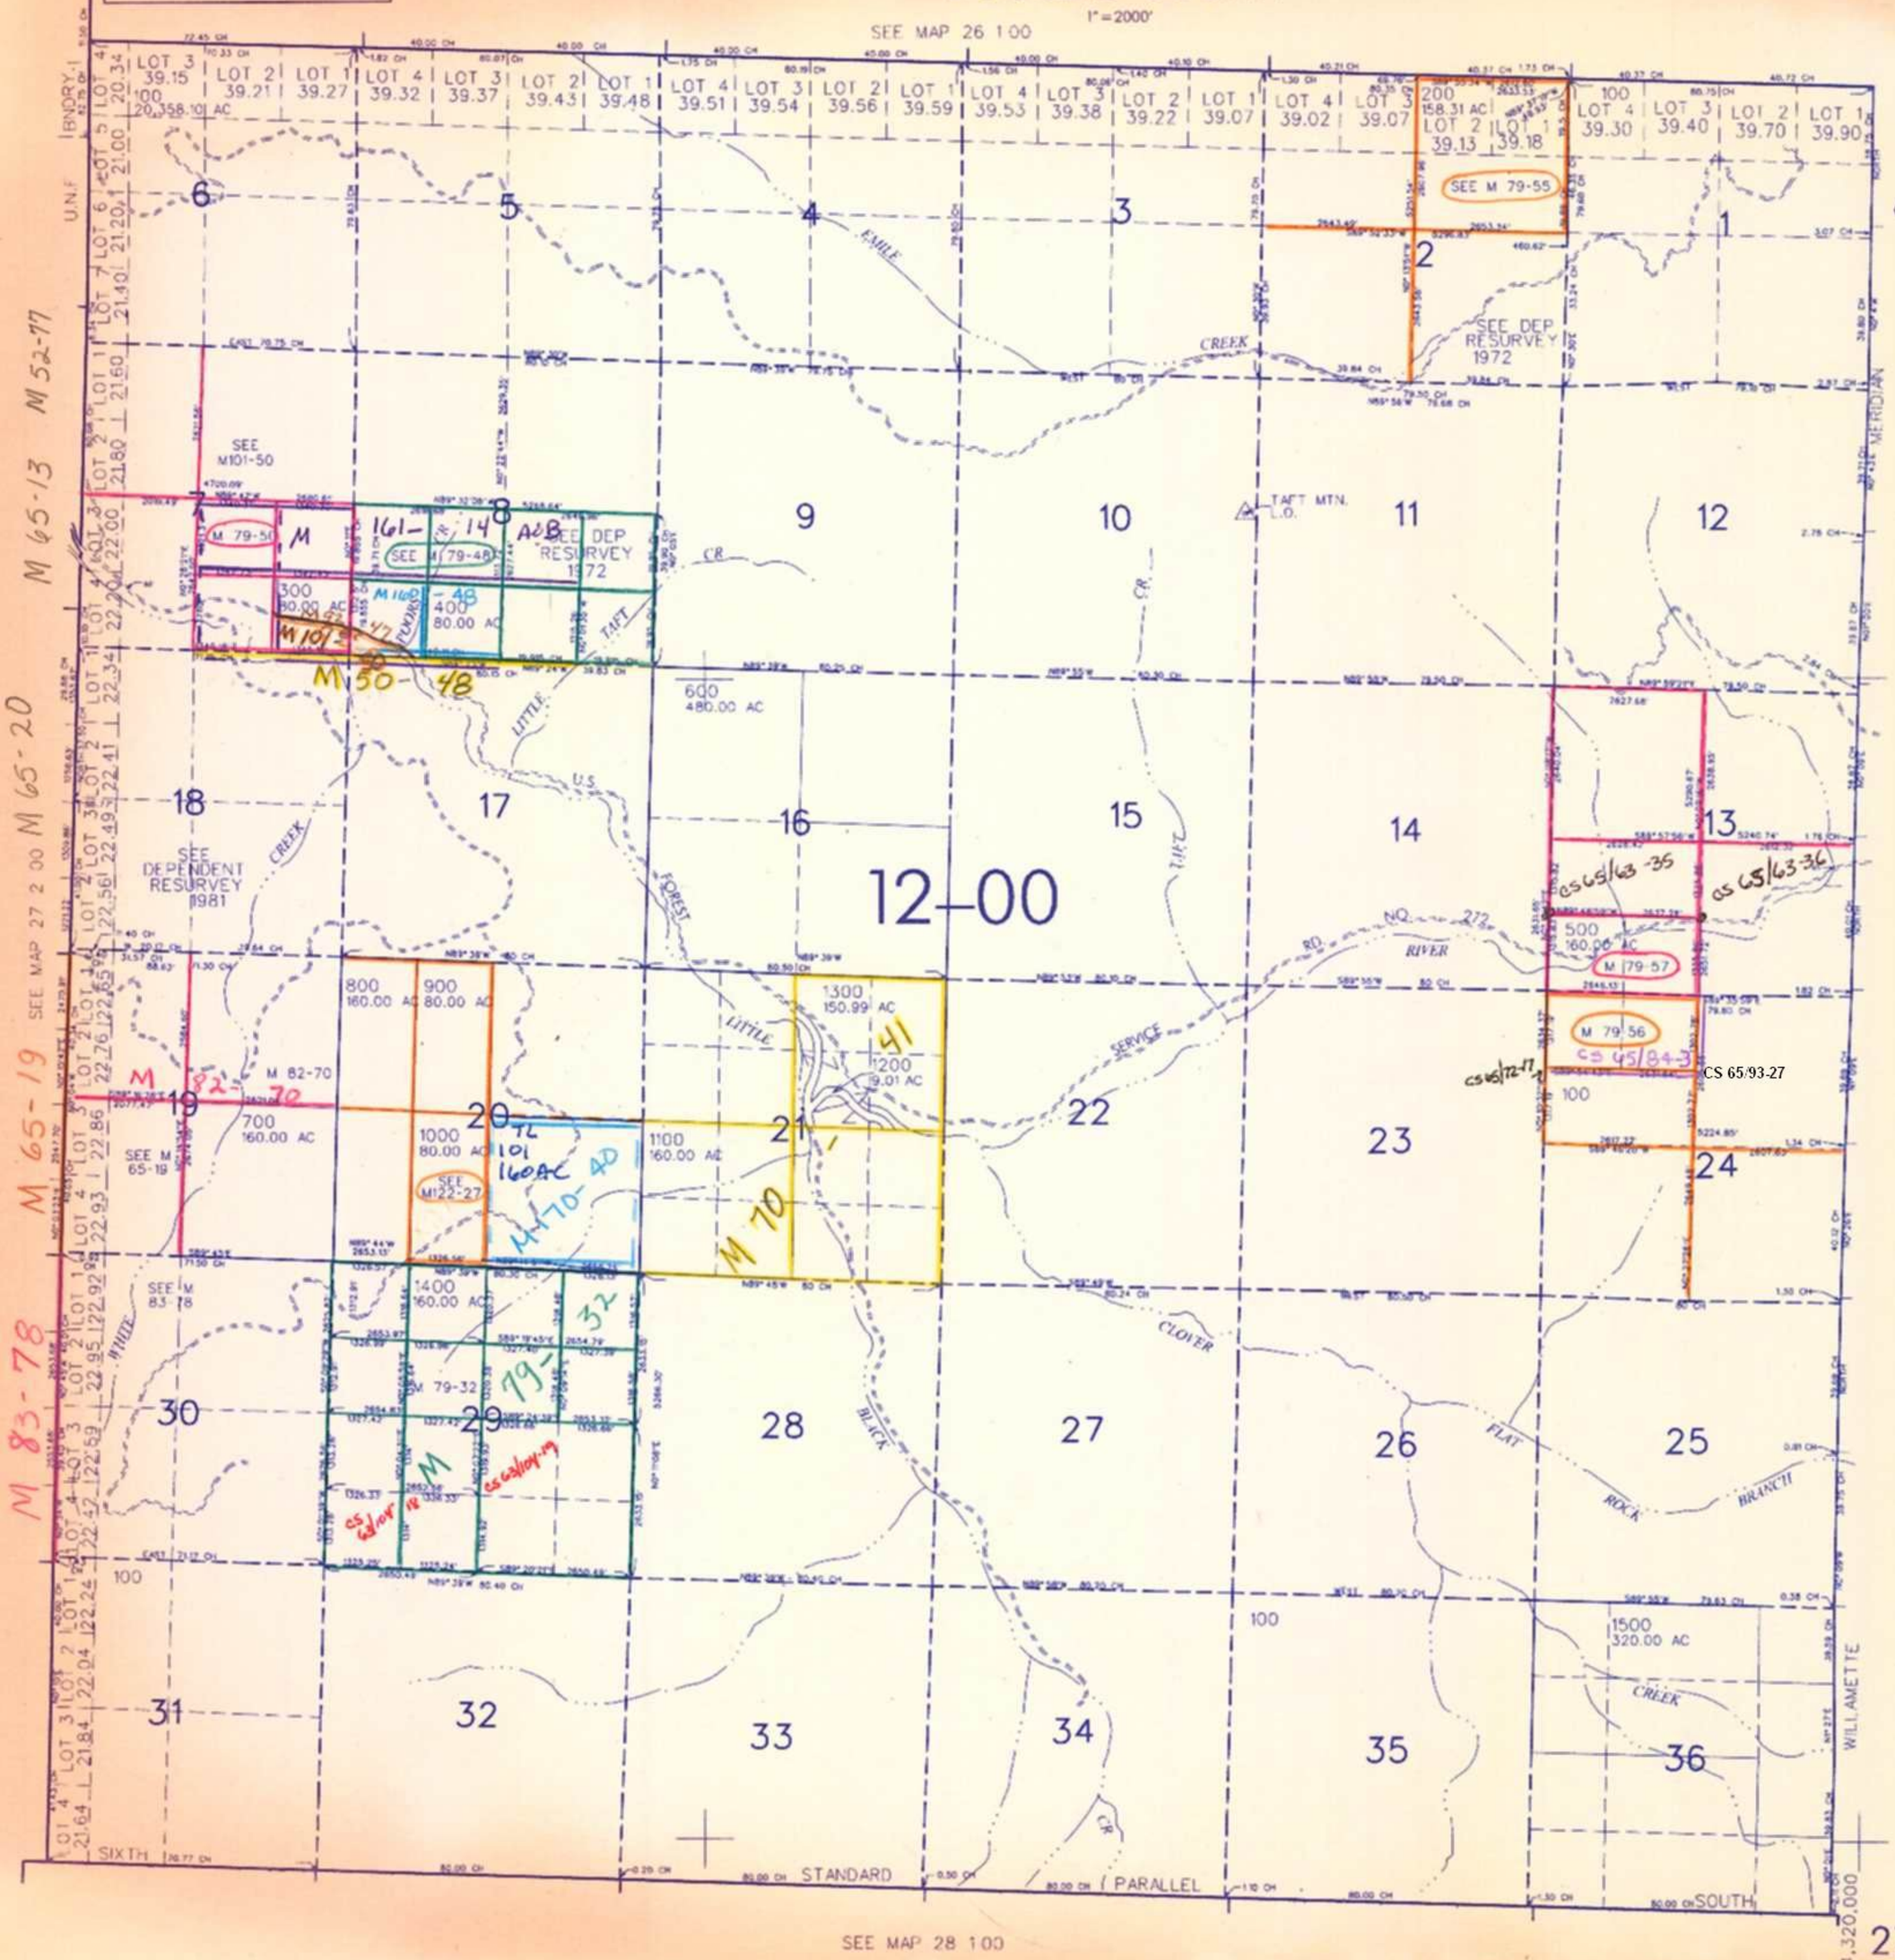

27 1 00

2/02 CM