


THIS MAP WAS PREPARED FOR ASSESSMENT PURPOSE ONLY.

T.27S. R.3E. W.M.  
DOUGLAS COUNTY SEE MAP 26 3E

27 3E

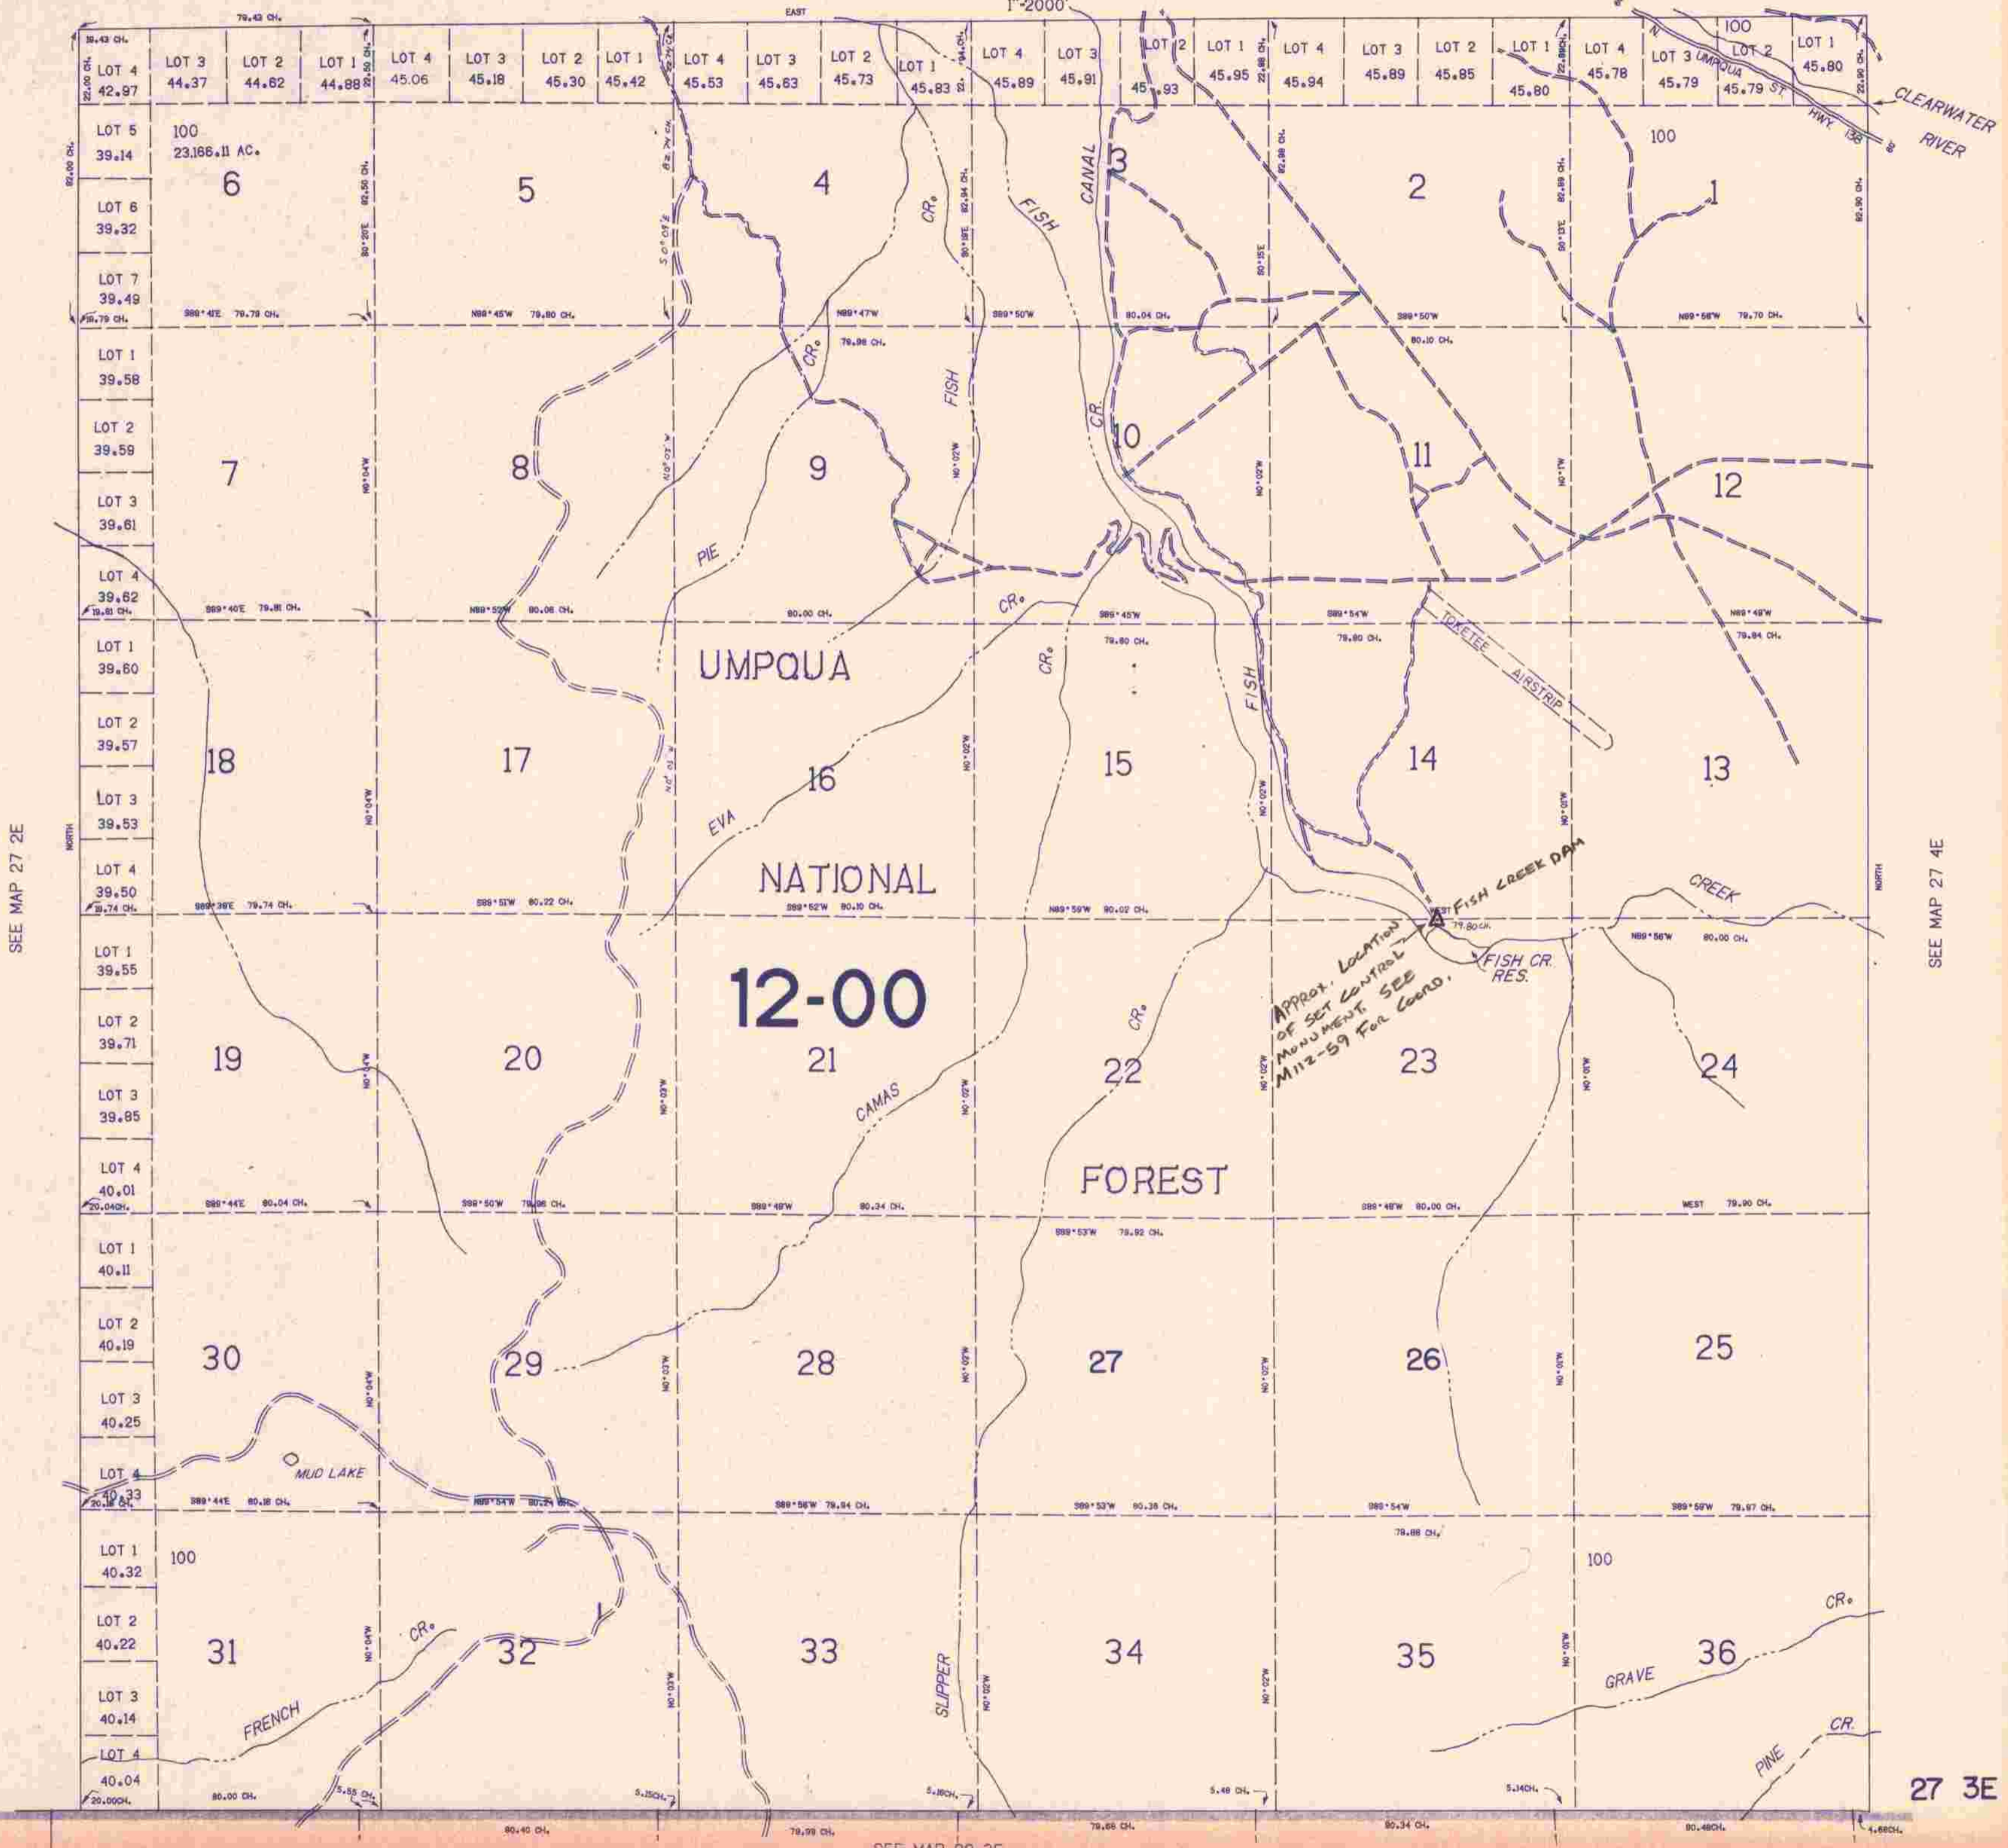

SEE MAP 27 2E

SEE MAP 27 4E

SEE MAP 28 3E

27 3E