THIS MAP WAS PREPARED FOR ASSESSMENT PURPOSE ONLY.

Upper Left:
123°29'W 43°13'48"N
4245575E 579982N ft

SEC.14 T.27S. R.03W. W.M.
DOUGLAS COUNTY
1" =400'

Date Exported 2024-12-18

270314

CANCELLED NOS:
700 701 100M1
1201 101 202
2001

WOLF CREEK ESTATES SUB
1. LC=S0°57'01"W 150.40'
R=459.26' A=151.08'
2. LC=S1°28'26"E 134.25'
R=459.26' A=134.73'
3. S79°57'18"W 10.00'
4. LC=S17°02'27"E 114.43'
R=469.26' A=114.71'
5. N65°49'29"E 10.00'
6. LC=S49°50'13"E 402.97'
R=459.26' A=417.17'
7. S76°26'34"E 95.74'
8. LC=S69°22'44"E 20.95'
R=93.26' A=20.94'
9. LC=S30°34'46"E 99.84'
R=93.26' A=105.36'
10. S2°07'37"W 62.82'
11. LC=S18°46'17"E 207.63'
R=288.73' A=212.39'

PP 1999-12
1. N89°35'32"W 162.56'
2. N42°36'03"W 78.54'
3. N42°36'03"W 79.15'
4. N27°08'49"E 158.07'
5. N15°28'58"E 319.25'
6. N22°30'59"E 91.1'
7. N43°25'17"W 60.71'
8. N48°22'36"W 110.74'
9. N6°02'43"E 156.22'
10. N55°03'28"E 149.9'
11. N20°39'39"W 172.19

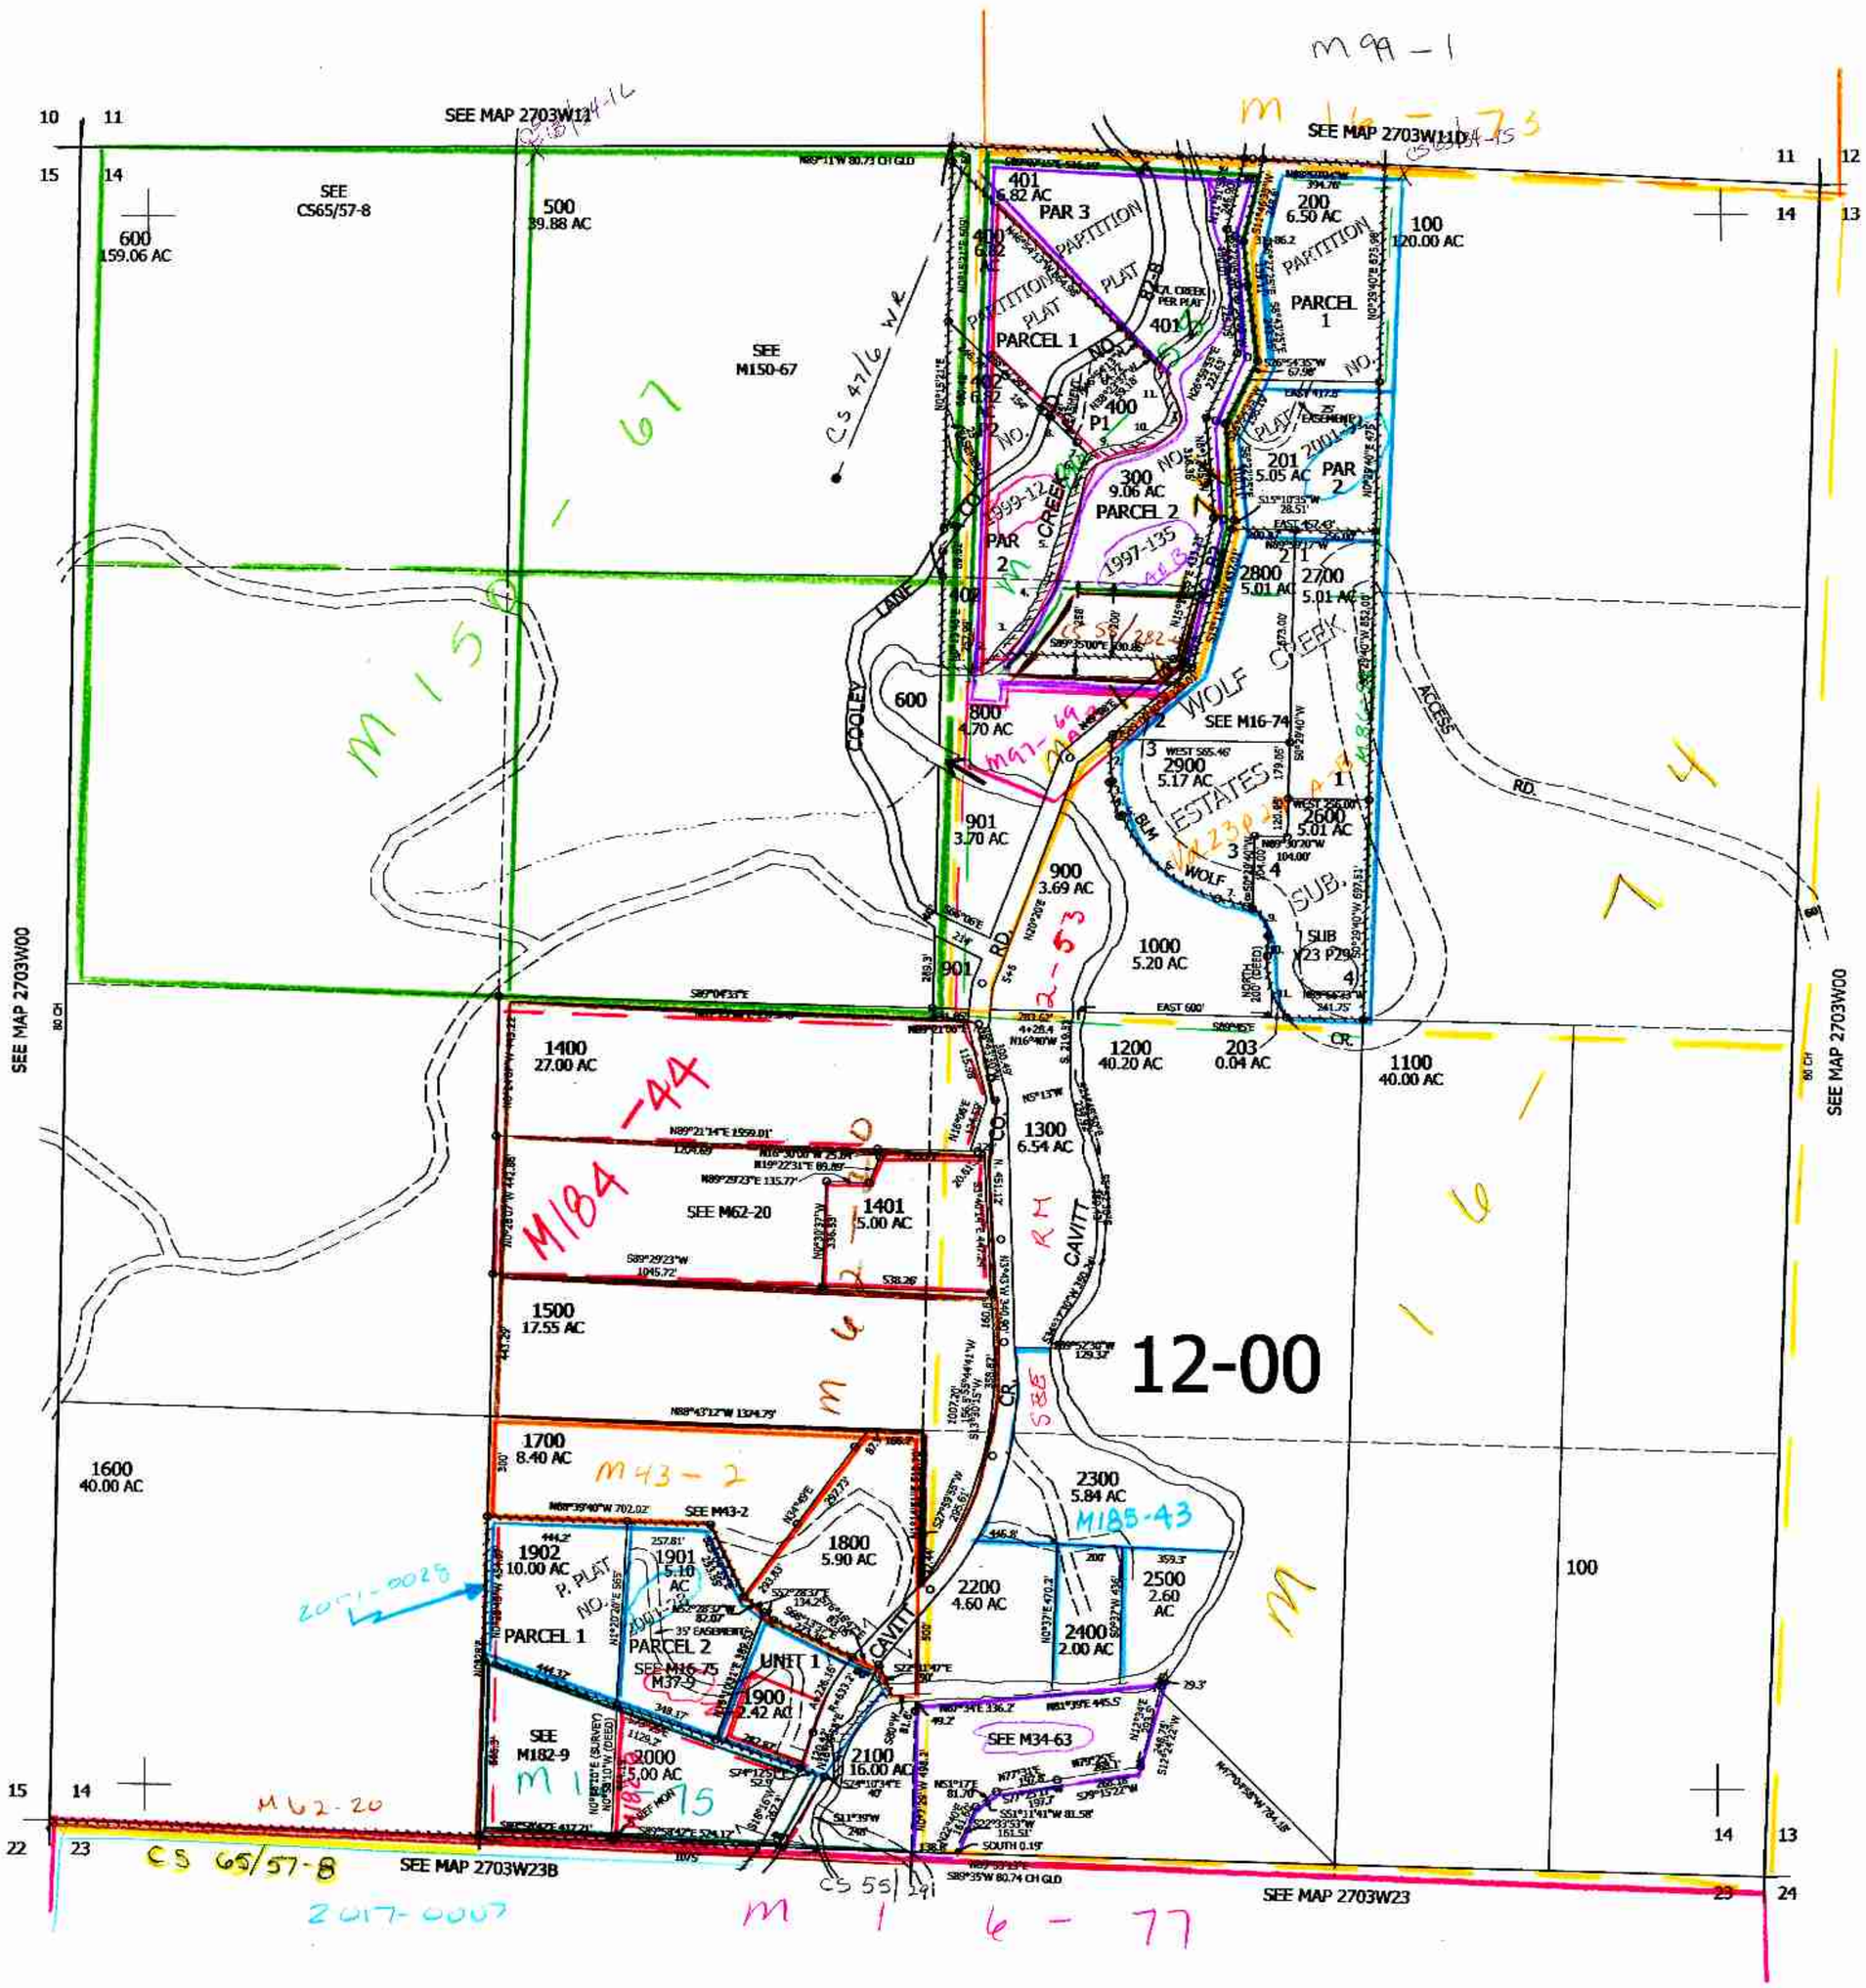

Lower Right:
123°0'20"W 43°12'42"N
4253424E 573027N ft

270314