THIS MAP WAS PREPARED FOR ASSESSMENT PURPOSE ONLY.

SECTION 23 T.27S. R.3W. W.M.
DOUGLAS COUNTY

1"=400'

27 3 23 & INDEX

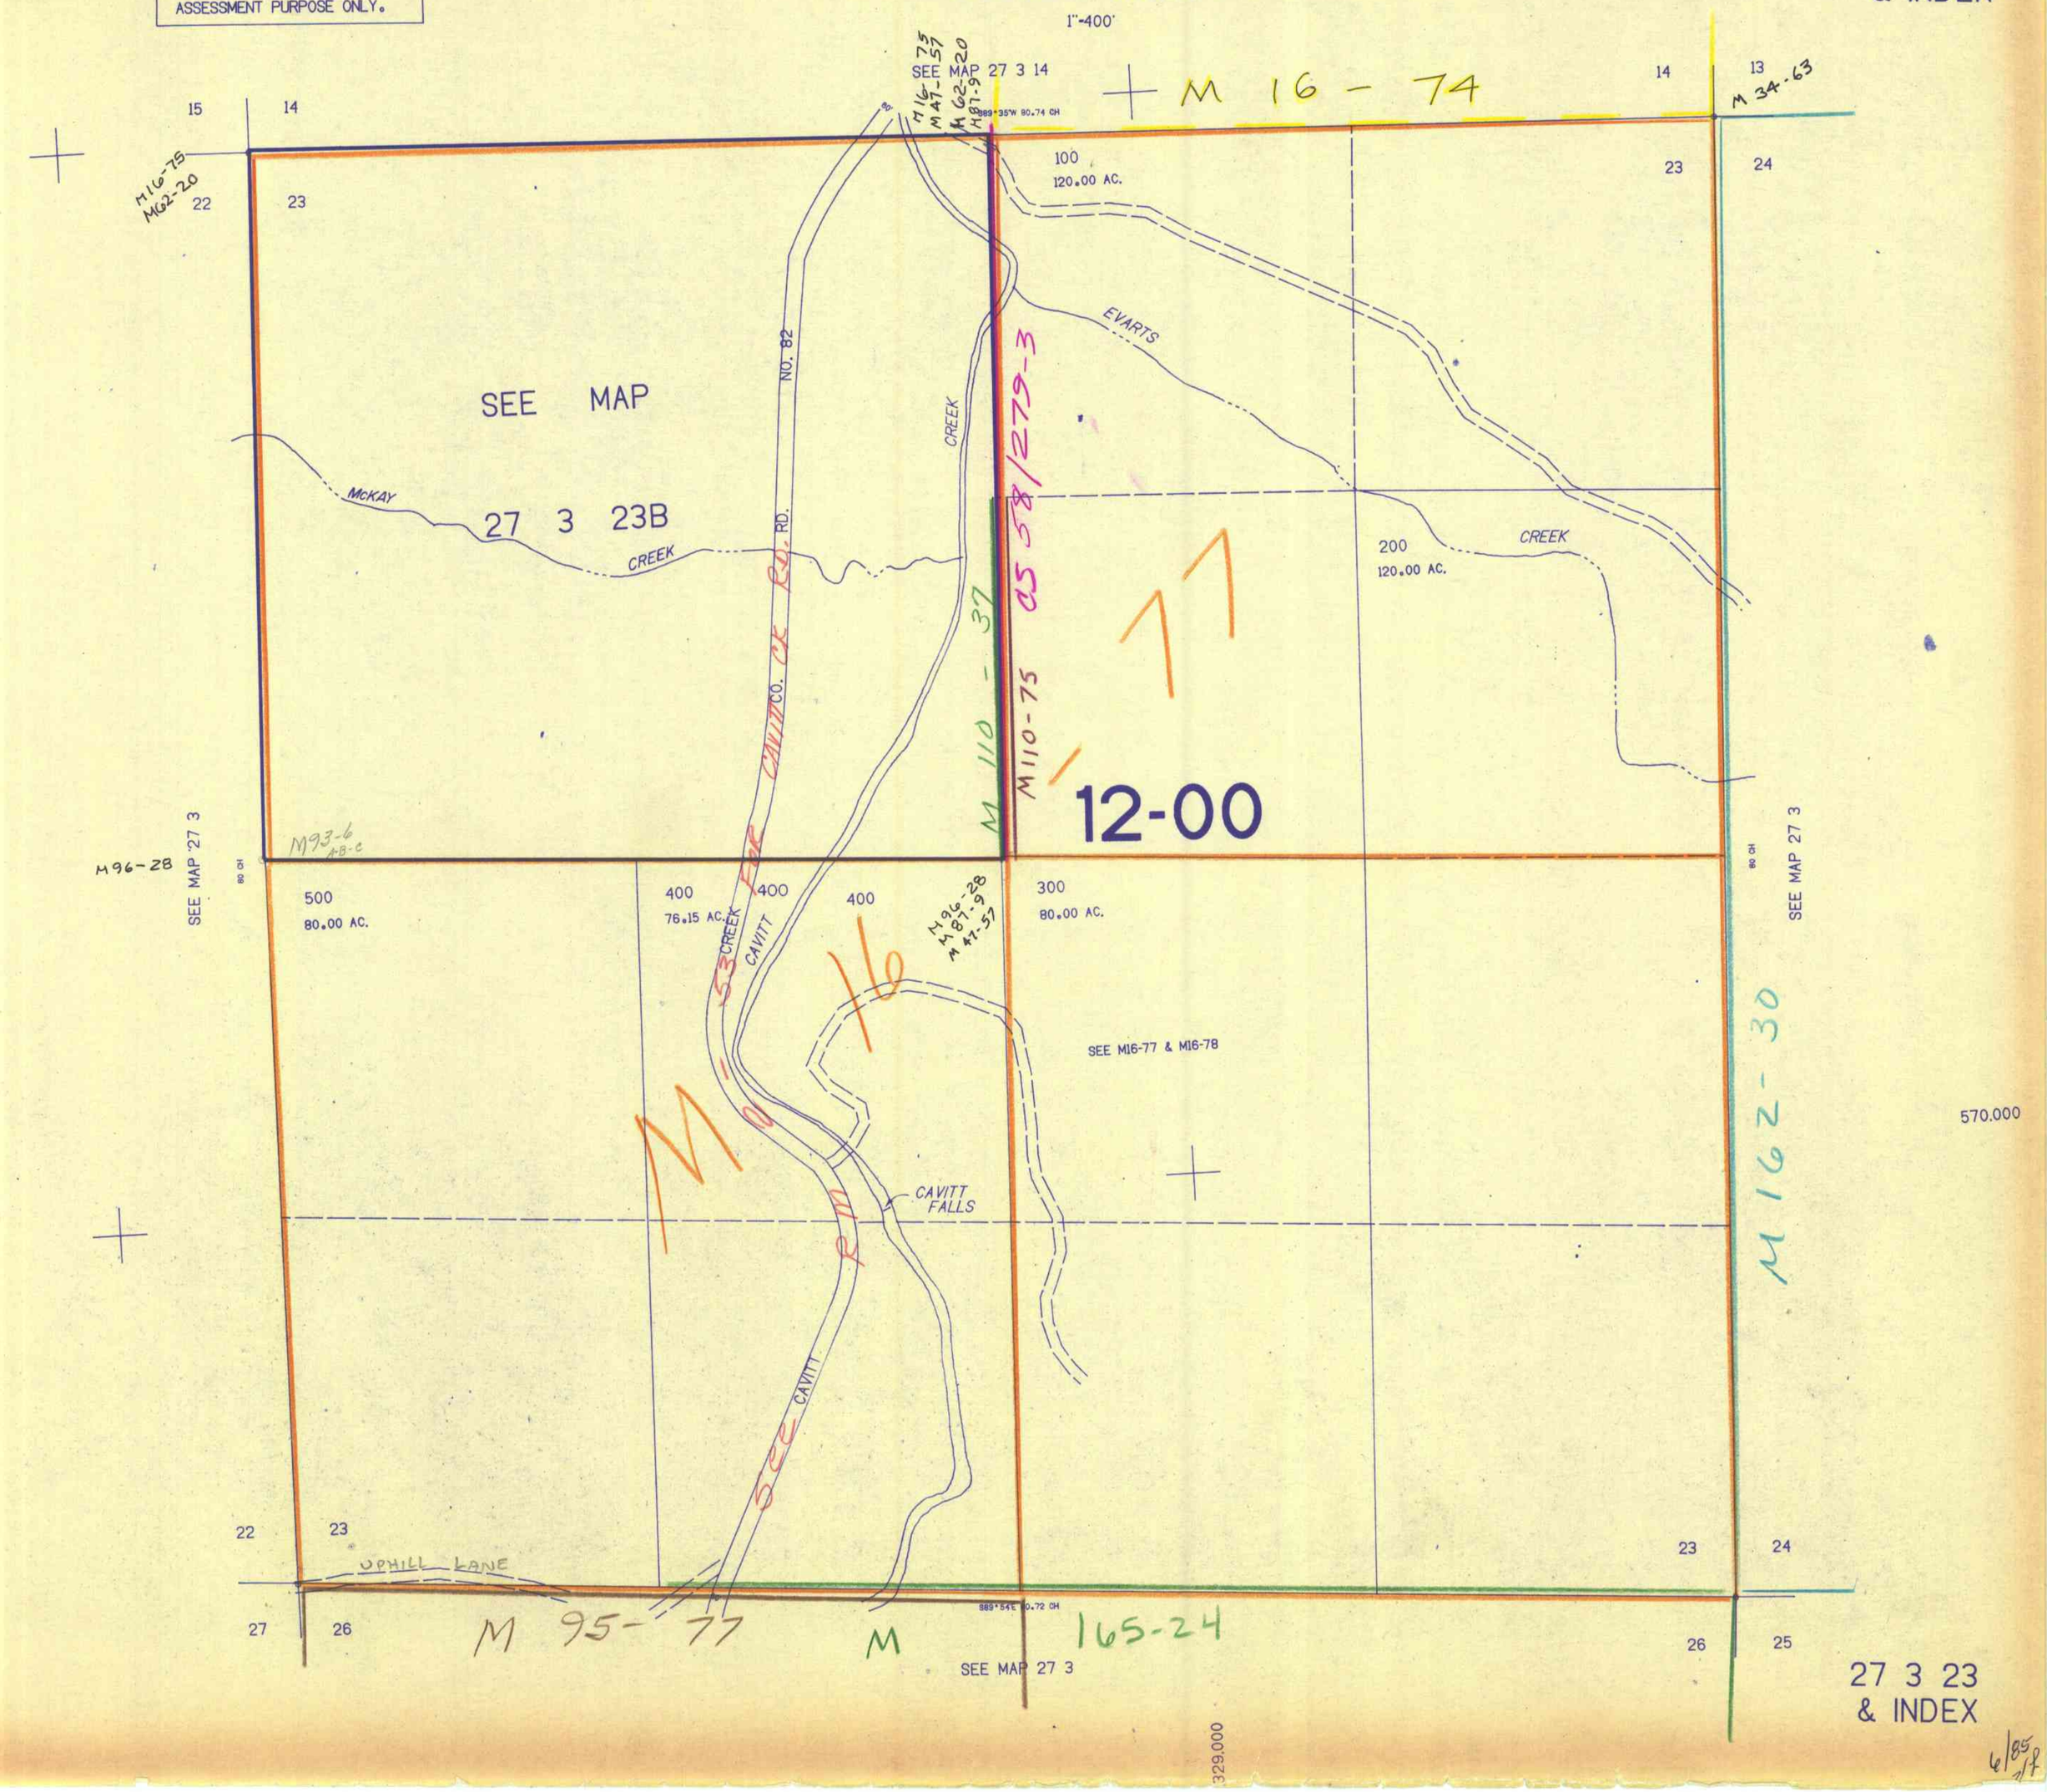

27 3 23 & INDEX

6/85