

T.27S. R.4 W. W.M.  
DOUGLAS COUNTY

REVISED ON  
5-15-91

27 4  
& INDEX


THIS MAP WAS PREPARED FOR  
ASSESSMENT PURPOSE ONLY.

SEE MAP 26 4

1"=2000'

SEE MAP 27 5

SEE MAP 27 3

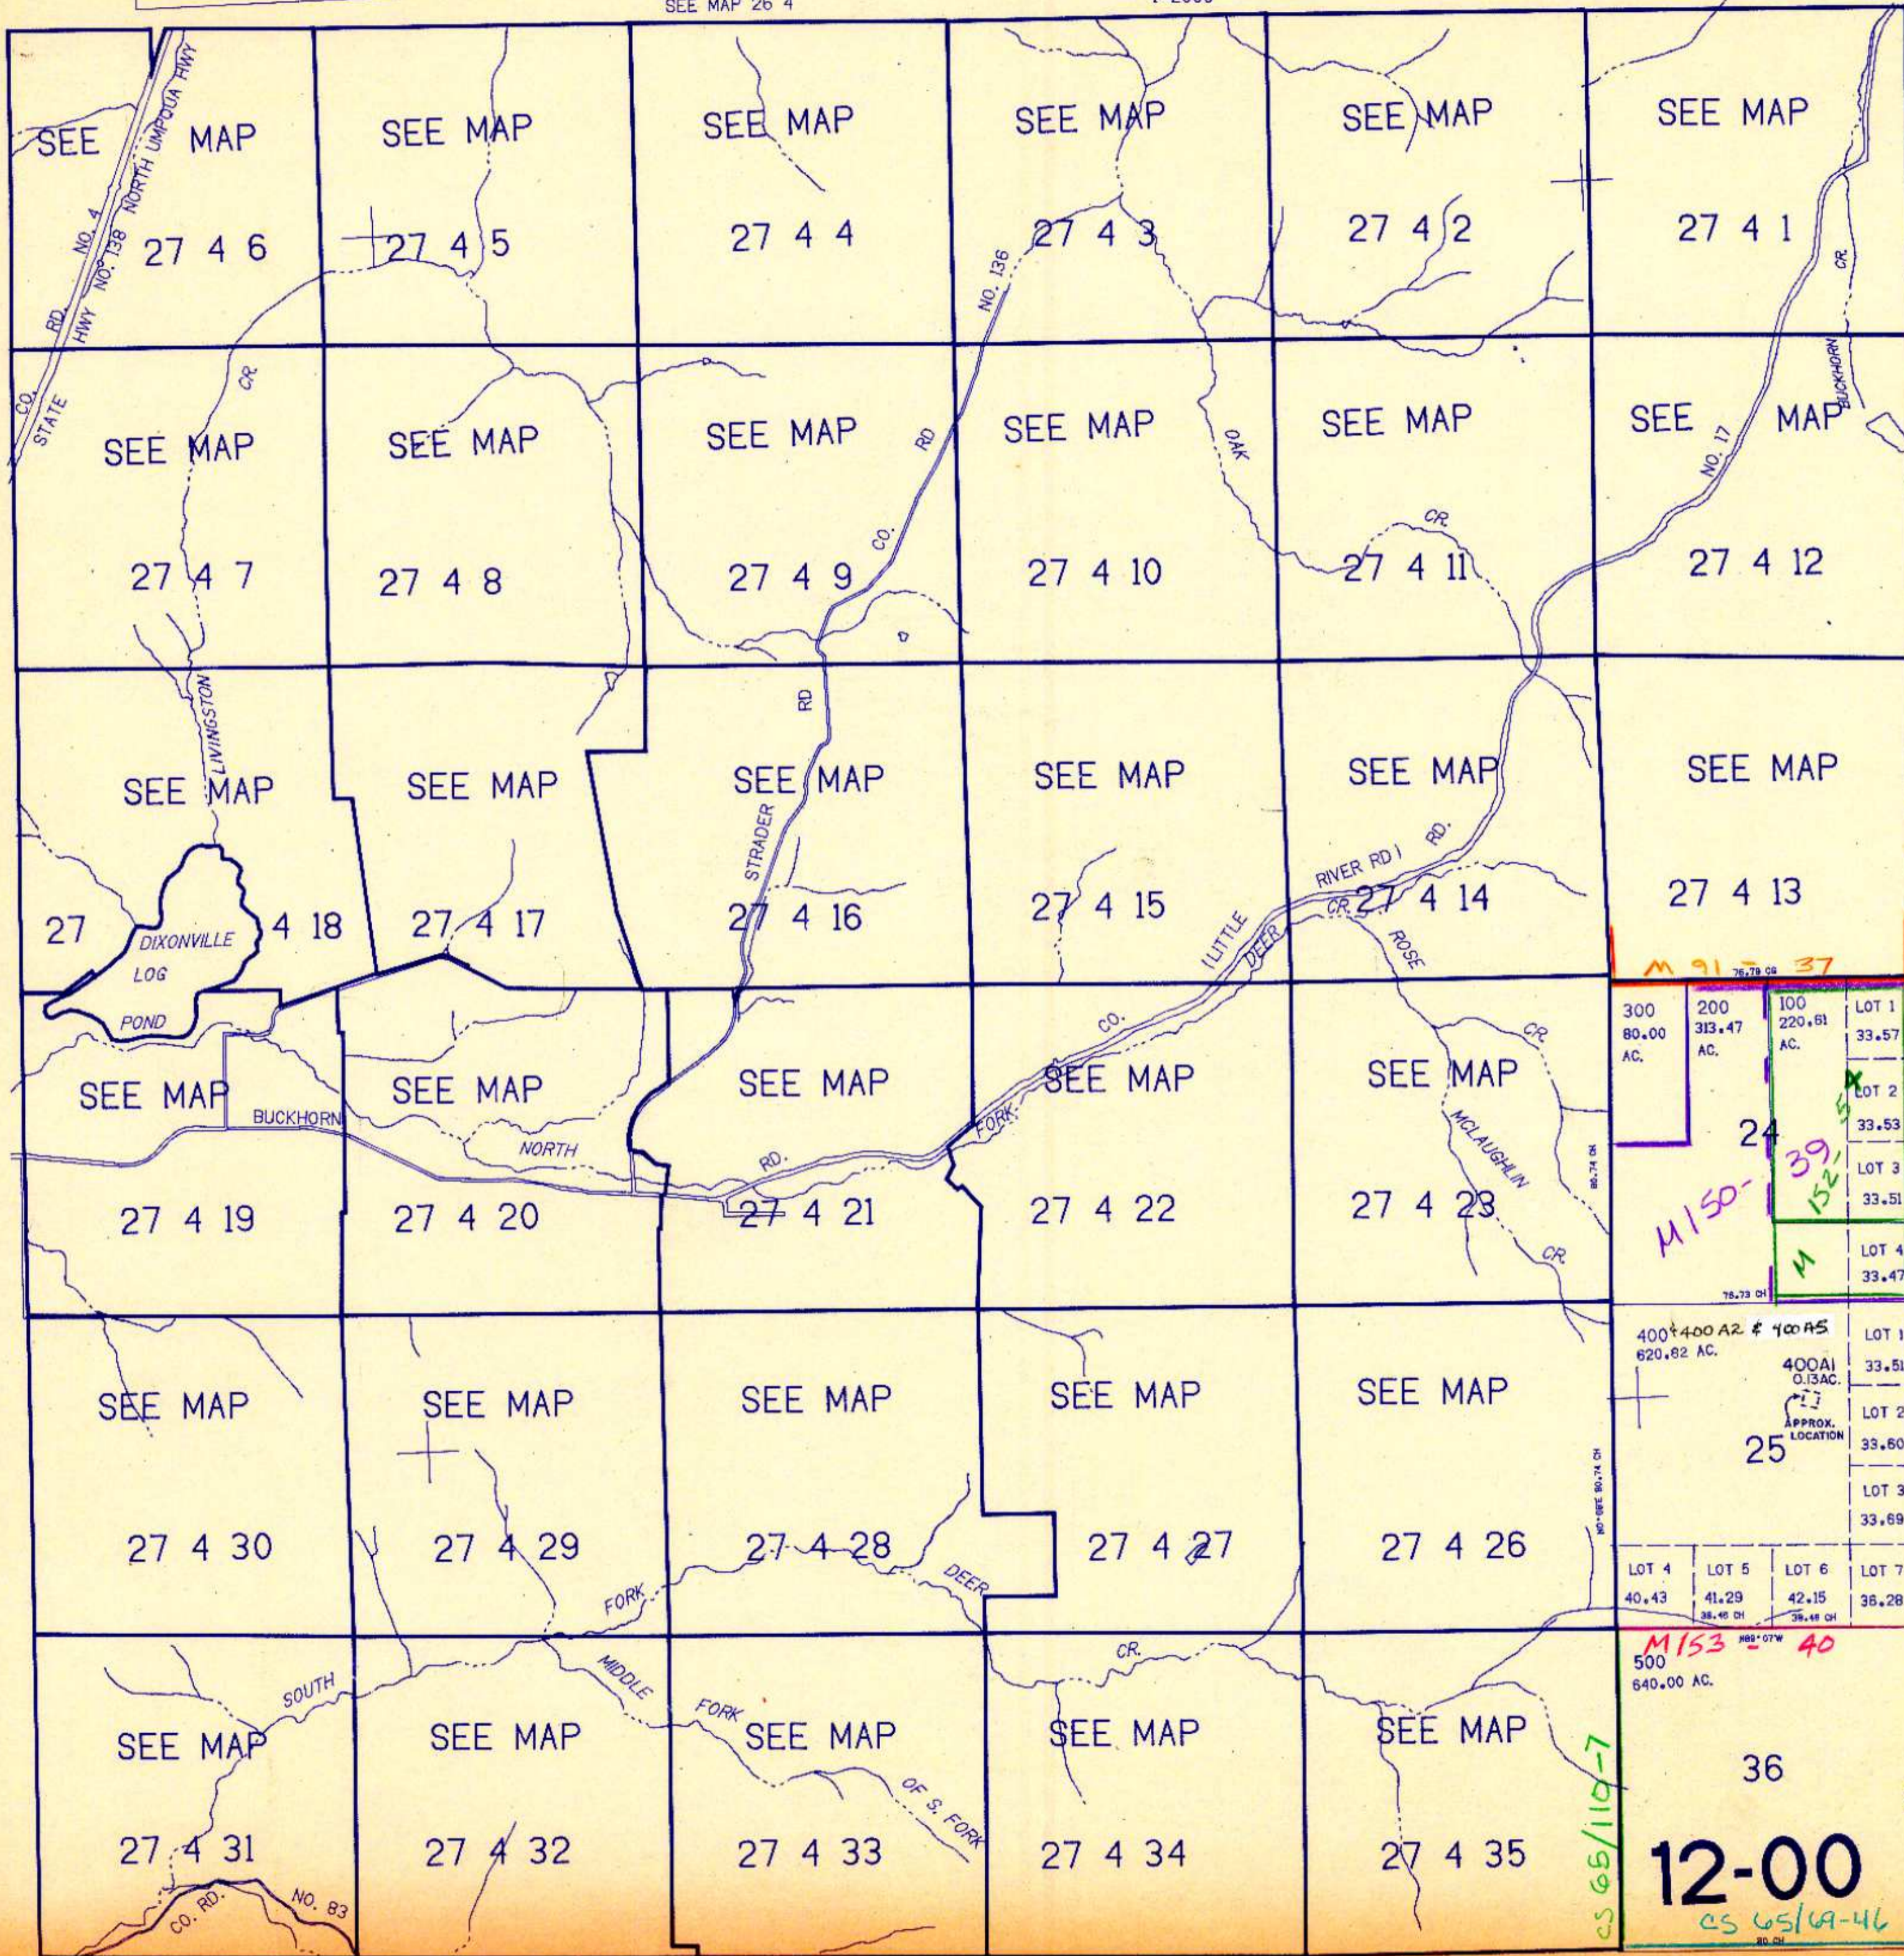

400A3  
400A4

300 80.00 AC.	200 313.47 AC.	100 220.61 AC.	LOT 1 33.57
			LOT 2 33.53
			LOT 3 33.51
			LOT 4 33.47

400+400A2 # 100A5 620.82 AC.	400A1 0.13AC.	APPROX. LOCATION	LOT 1 33.51
			LOT 2 33.60
			LOT 3 33.69
LOT 4 40.43	LOT 5 41.29	LOT 6 42.15	LOT 7 36.28

500  
640.00 AC.

36

12-00

CS 65/119-7

CS 65/119-46

568,000

27 4  
& INDEX

SEE MAP 28 4

5-91 JB