THIS MAP WAS PREPARED FOR ASSESSMENT PURPOSE ONLY.

SECTION 2 T.27S. R.4W. W.M.
DOUGLAS COUNTY

1"=400'

REVISED ON 4-25-97

27 4 2

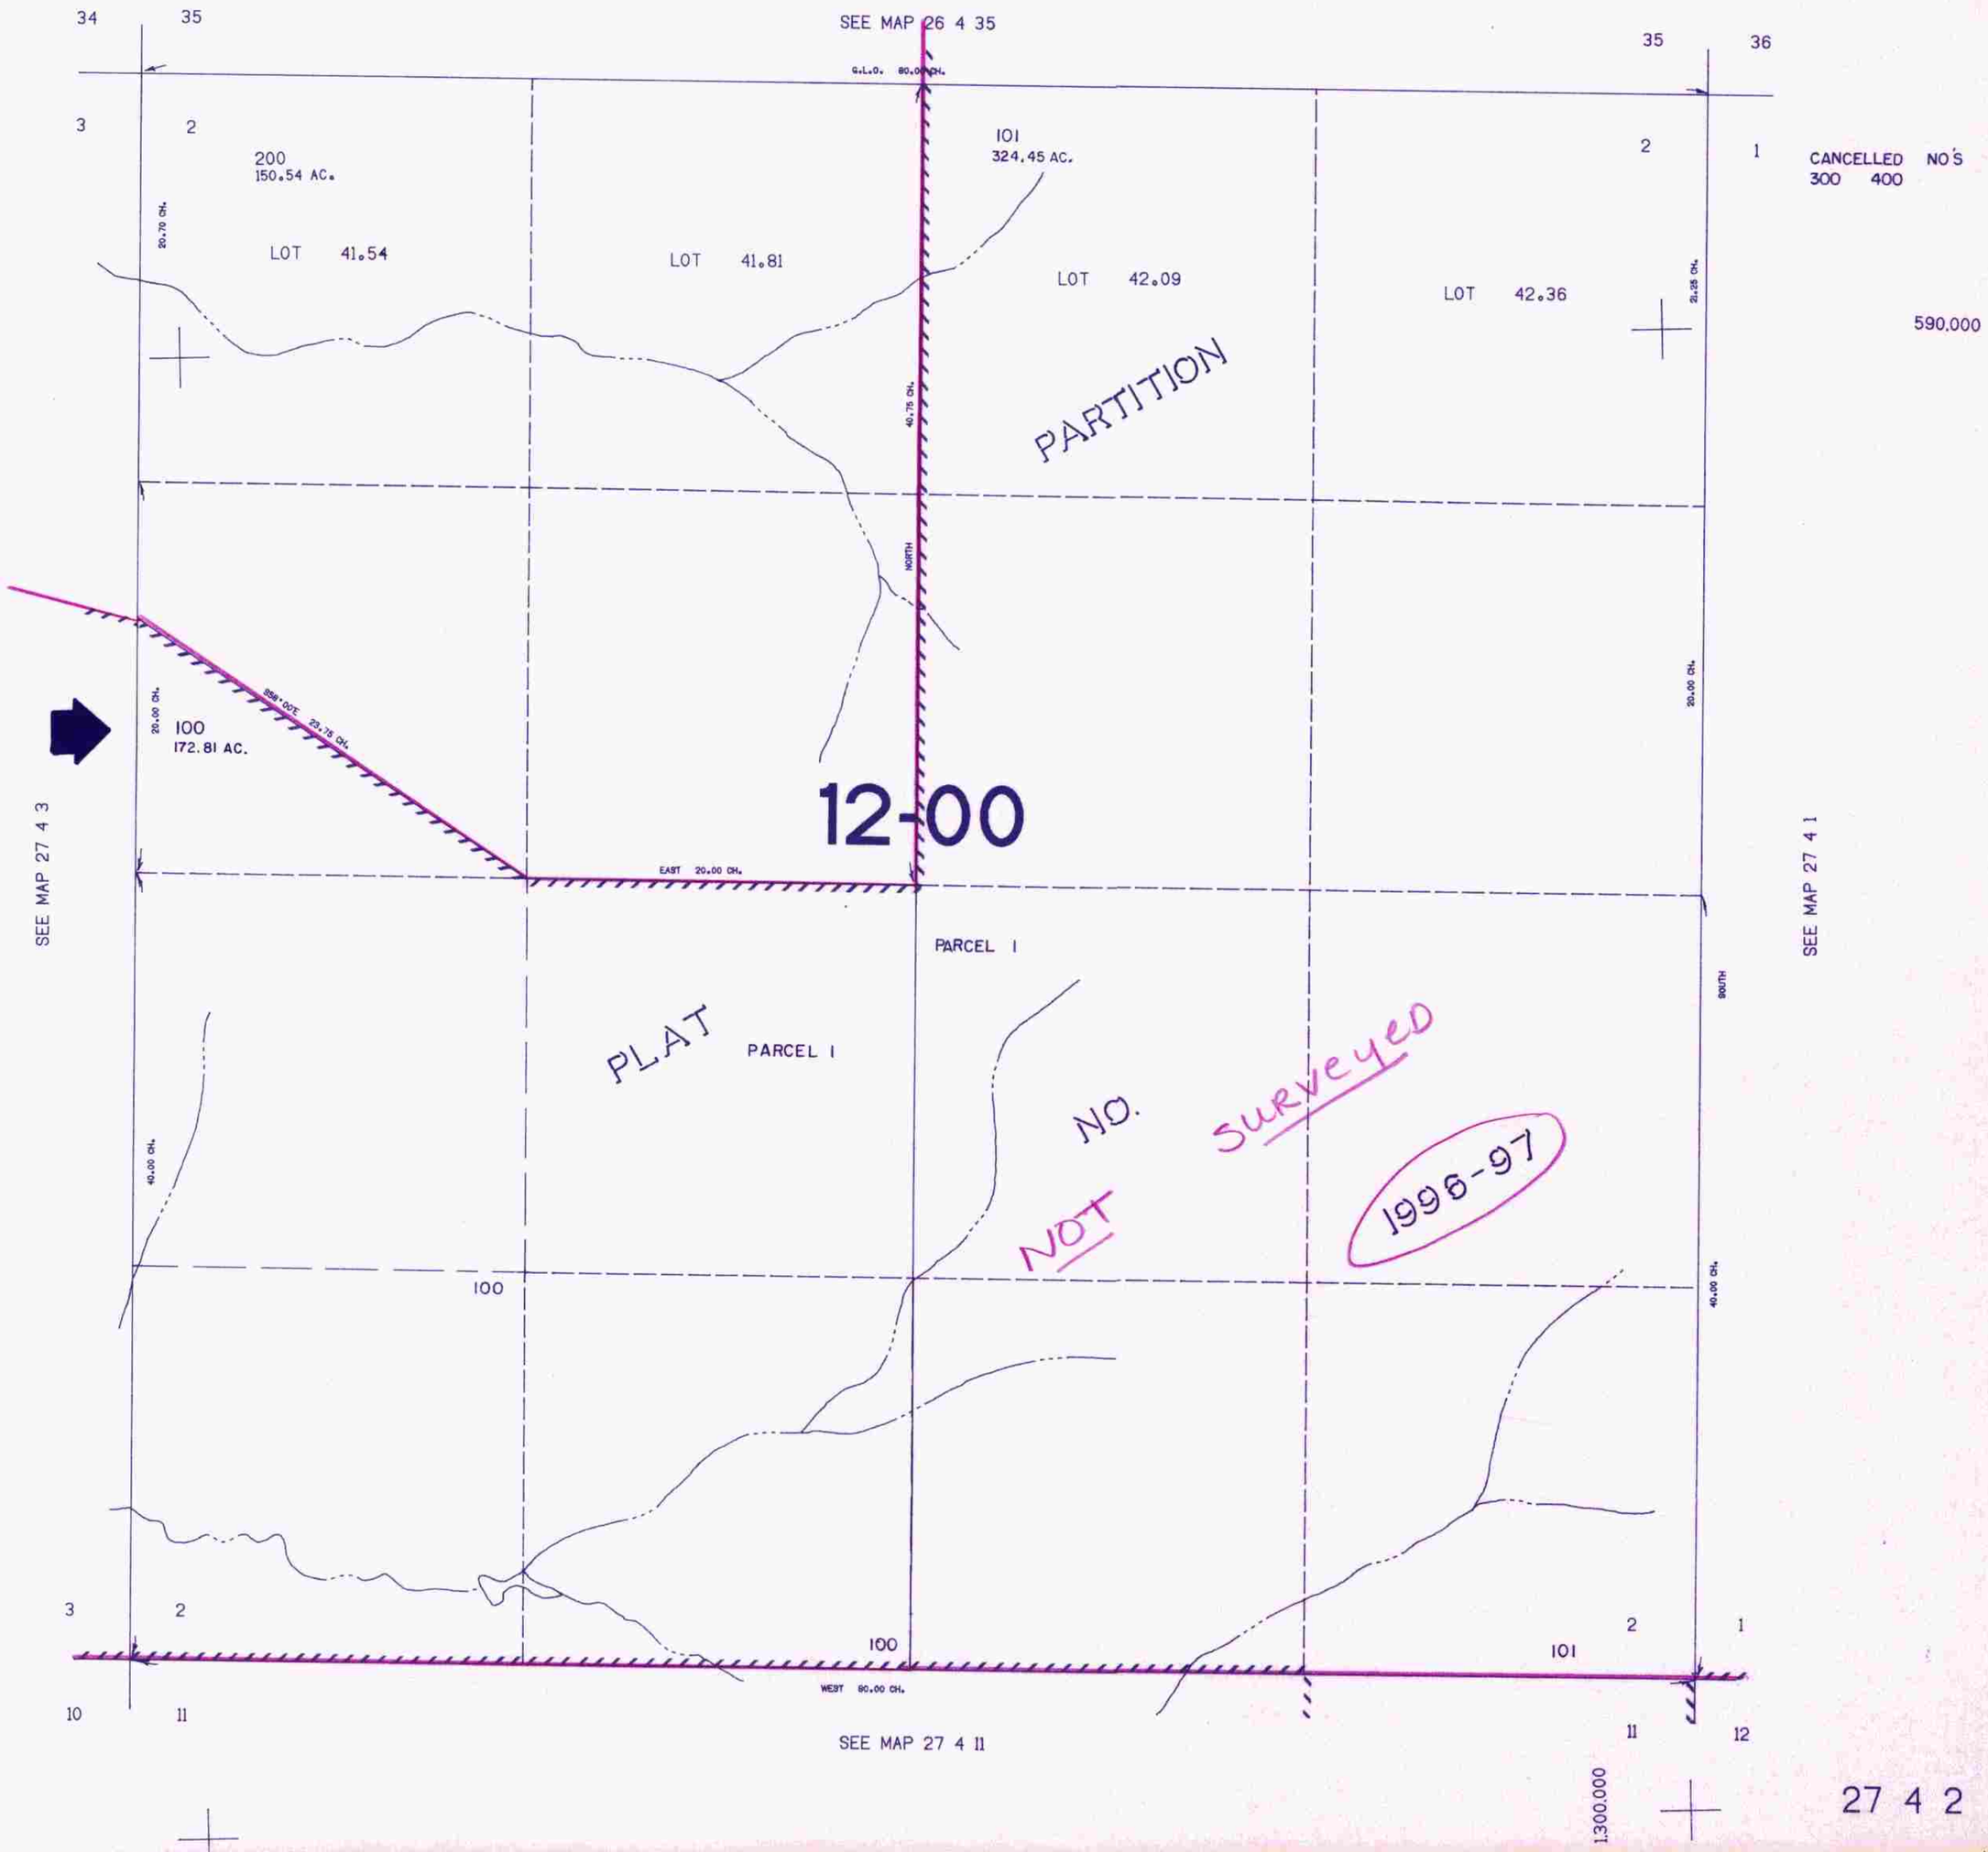

27 4 2