


THIS MAP WAS PREPARED FOR ASSESSMENT PURPOSE ONLY

SEC. 10 T.27S. R.4 W W.M. DOUGLAS COUNTY

REVISED ON 12-30-02

27 4 10

1"=400'

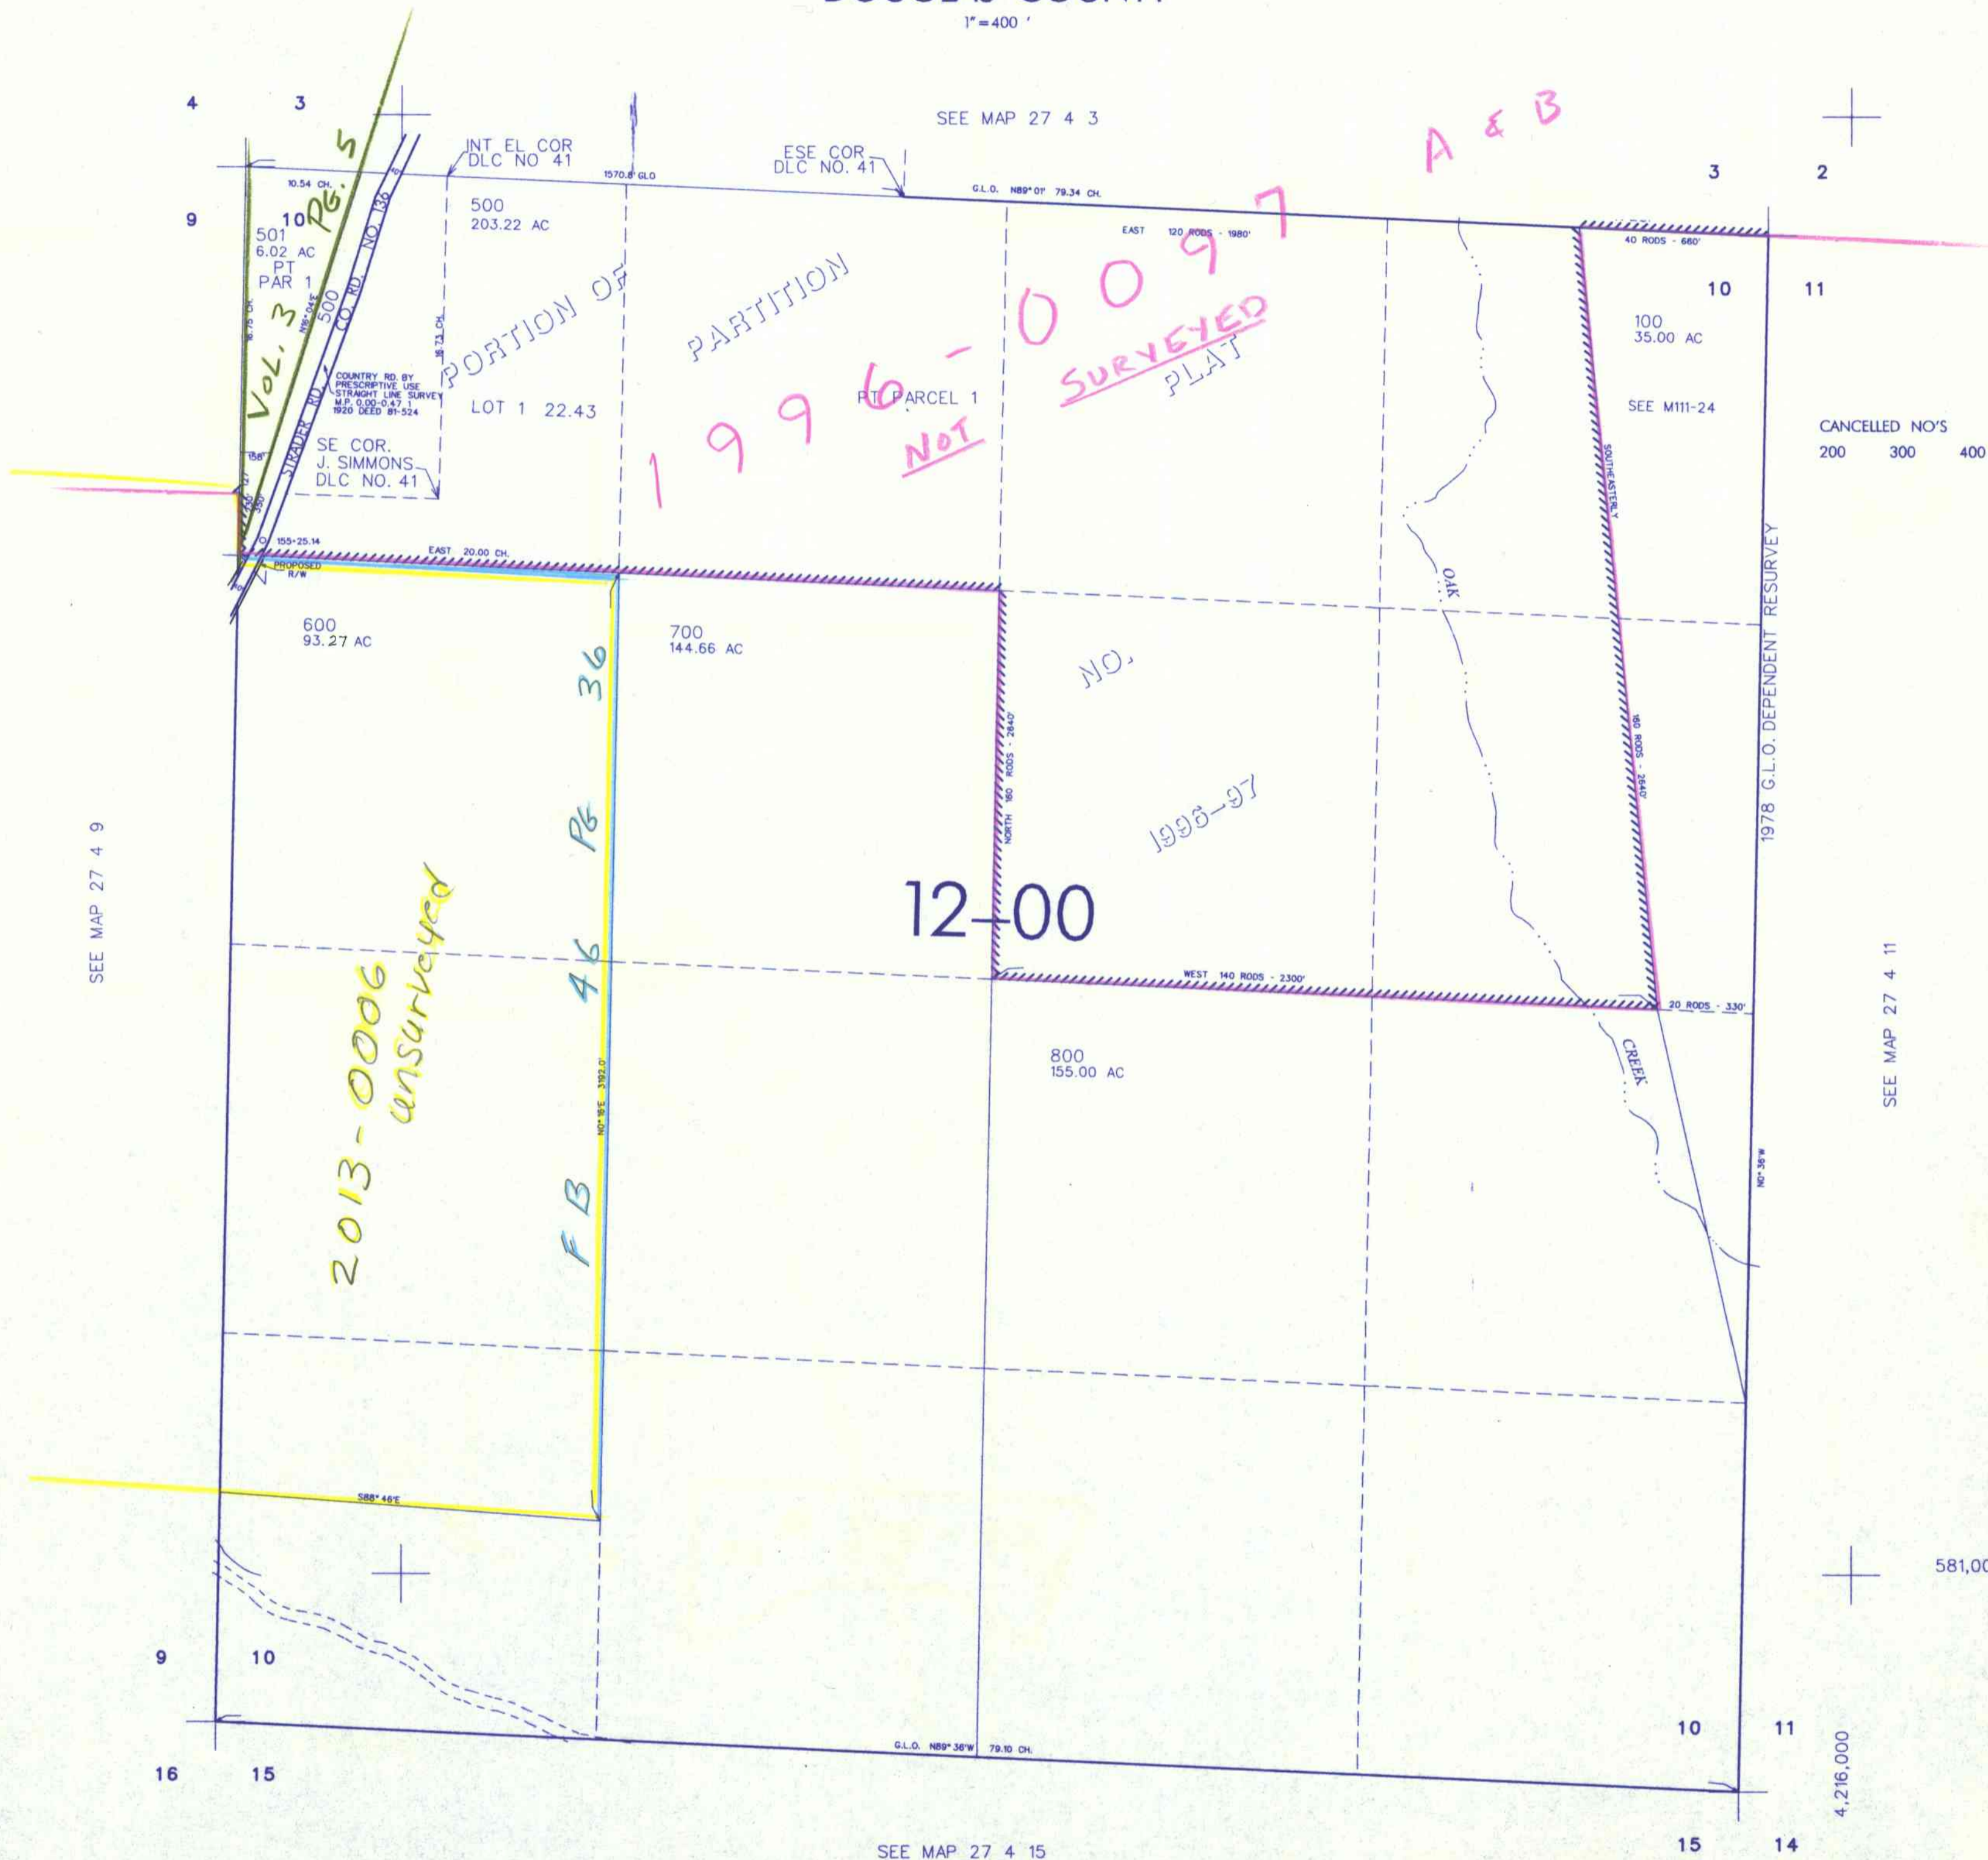

CANCELLED NO'S
200 300 400

SEE MAP 27 4 11

581,000

4,216,000

27 4 10

1/2003 JR