


SECTION 13 T.27S. R.4W. W.M.
DOUGLAS COUNTY

27 4 13

THIS MAP WAS PREPARED FOR
ASSESSMENT PURPOSE ONLY.

1"=400'

SEE MAP 27 4 12

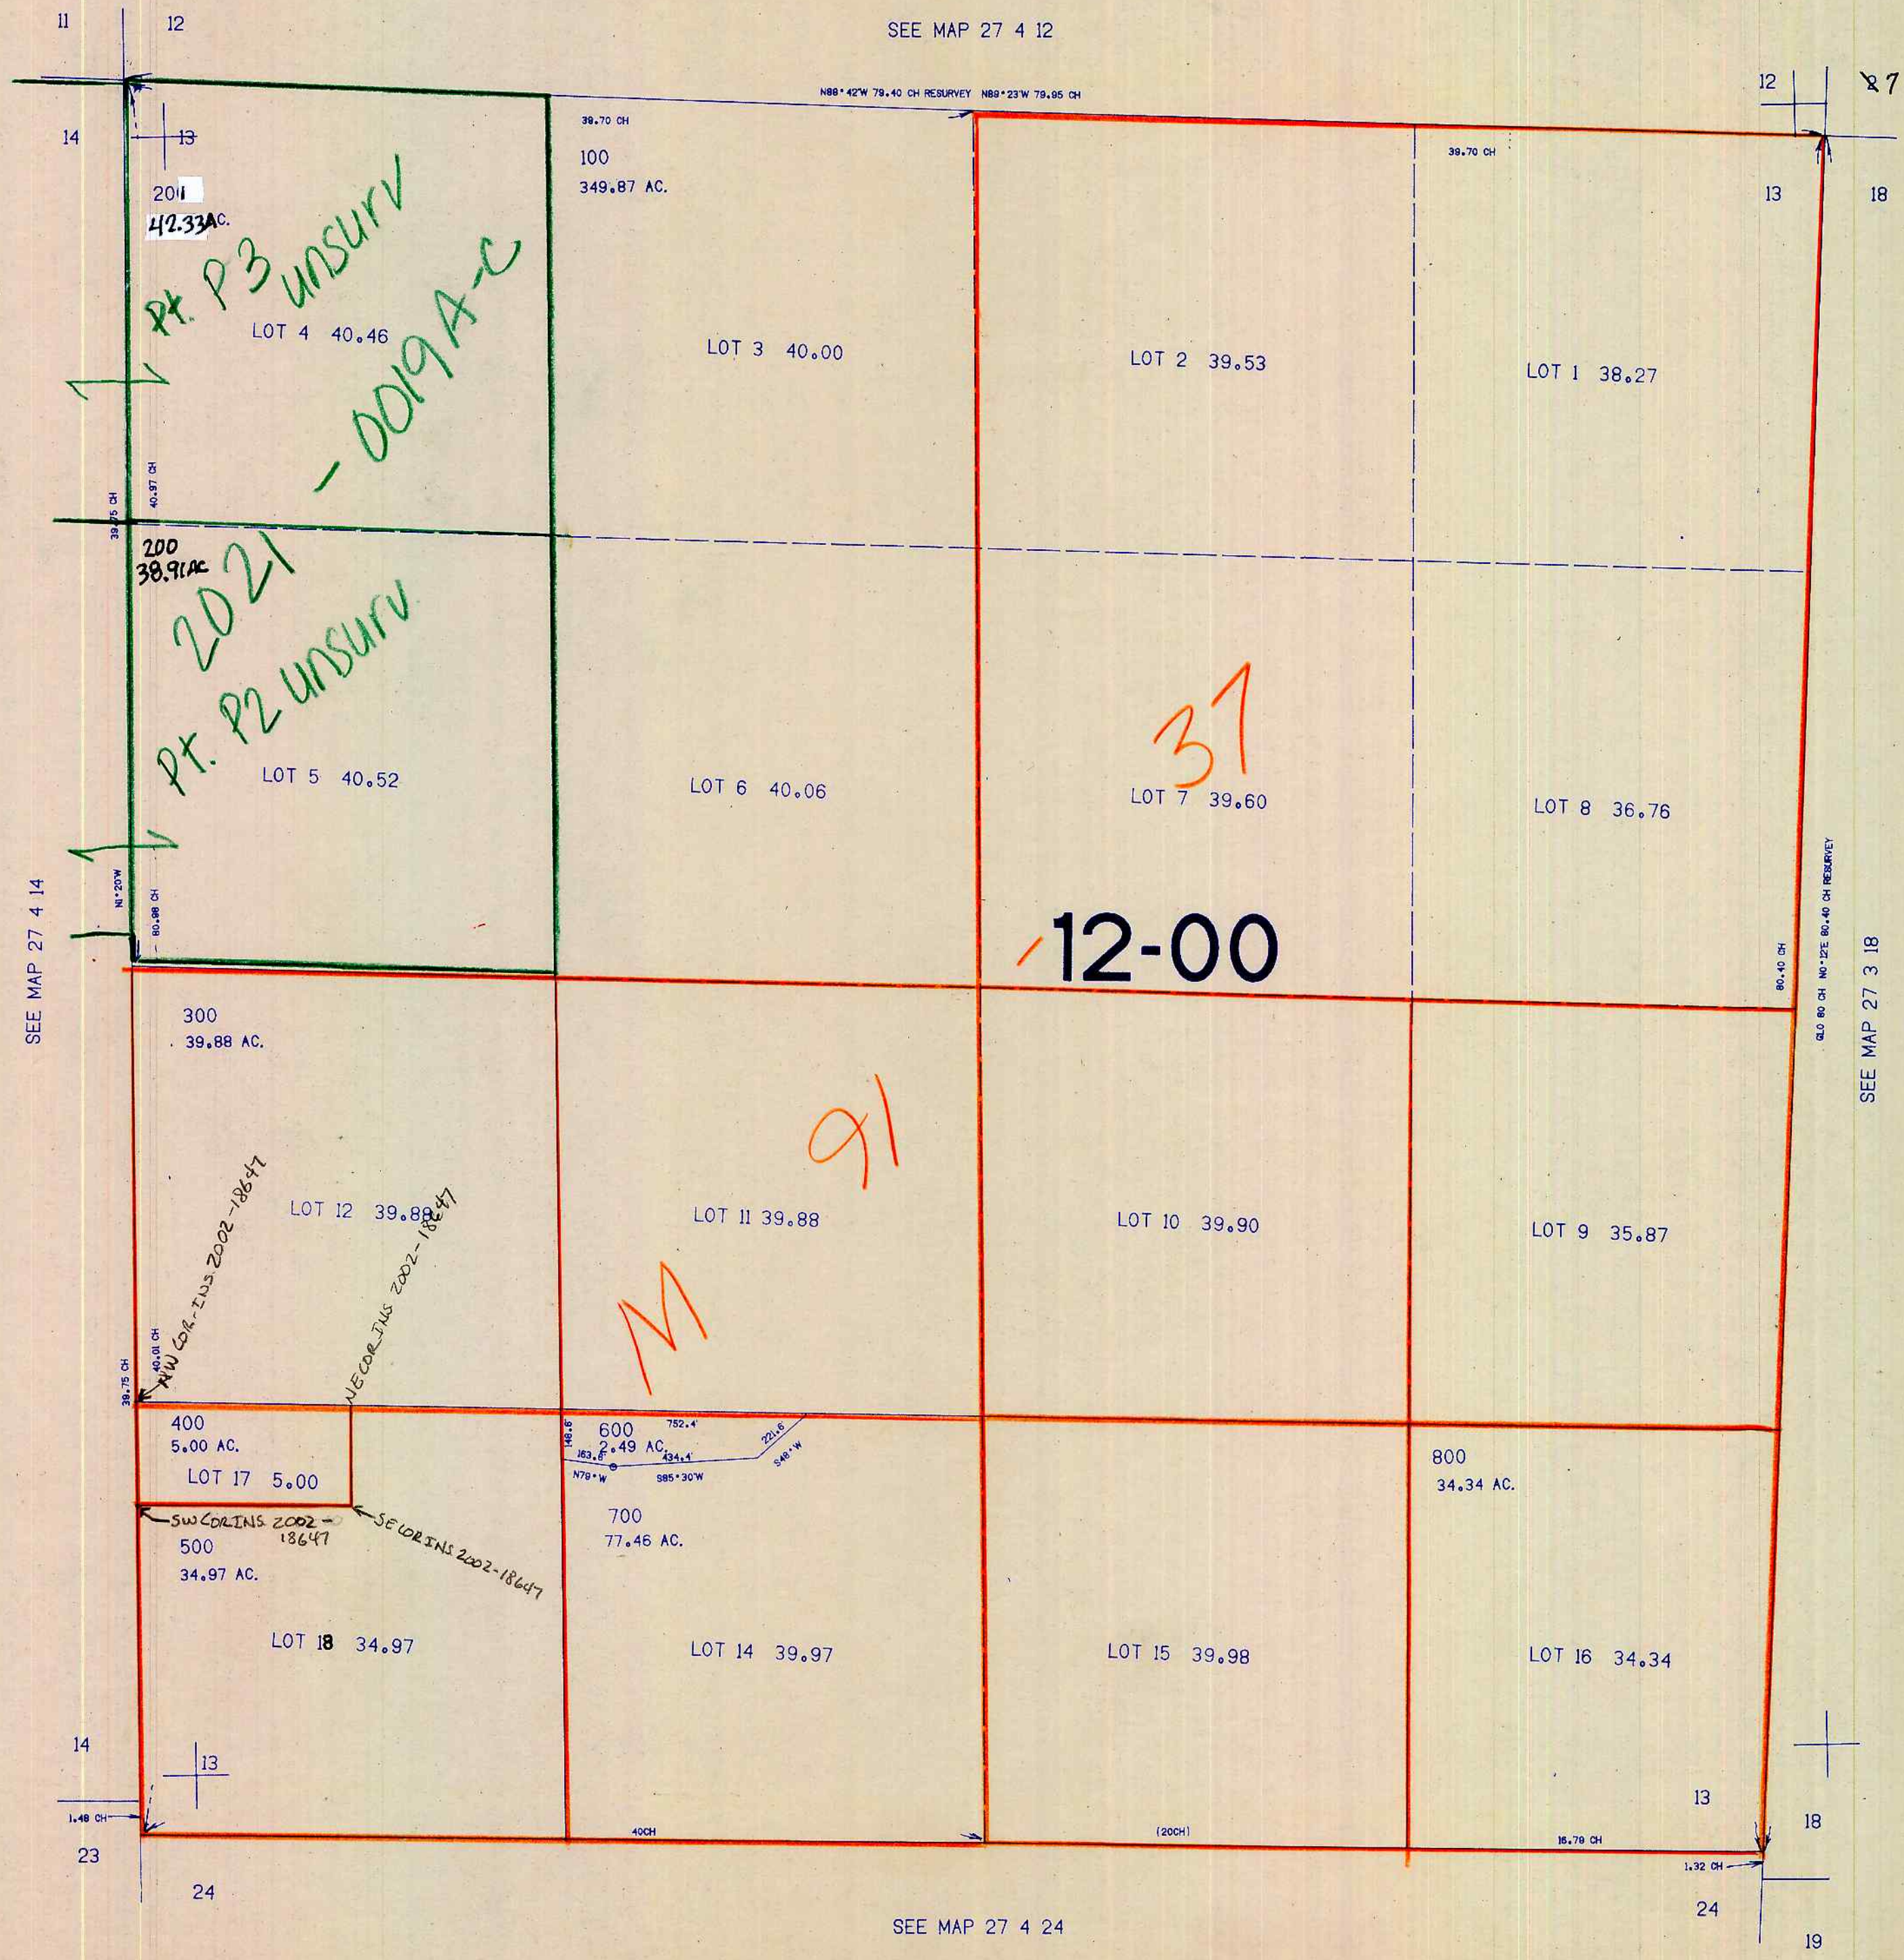

SEE MAP 27 4 14

SEE MAP 27 3 18

SEE MAP 27 4 24

27 4 13

6/95 JH

1.305.000

575.000