


SECTION 26 T.27S. R.4W. W.M.  
DOUGLAS COUNTY

27 4 26

THIS MAP WAS PREPARED FOR  
ASSESSMENT PURPOSE ONLY.

1"=400'

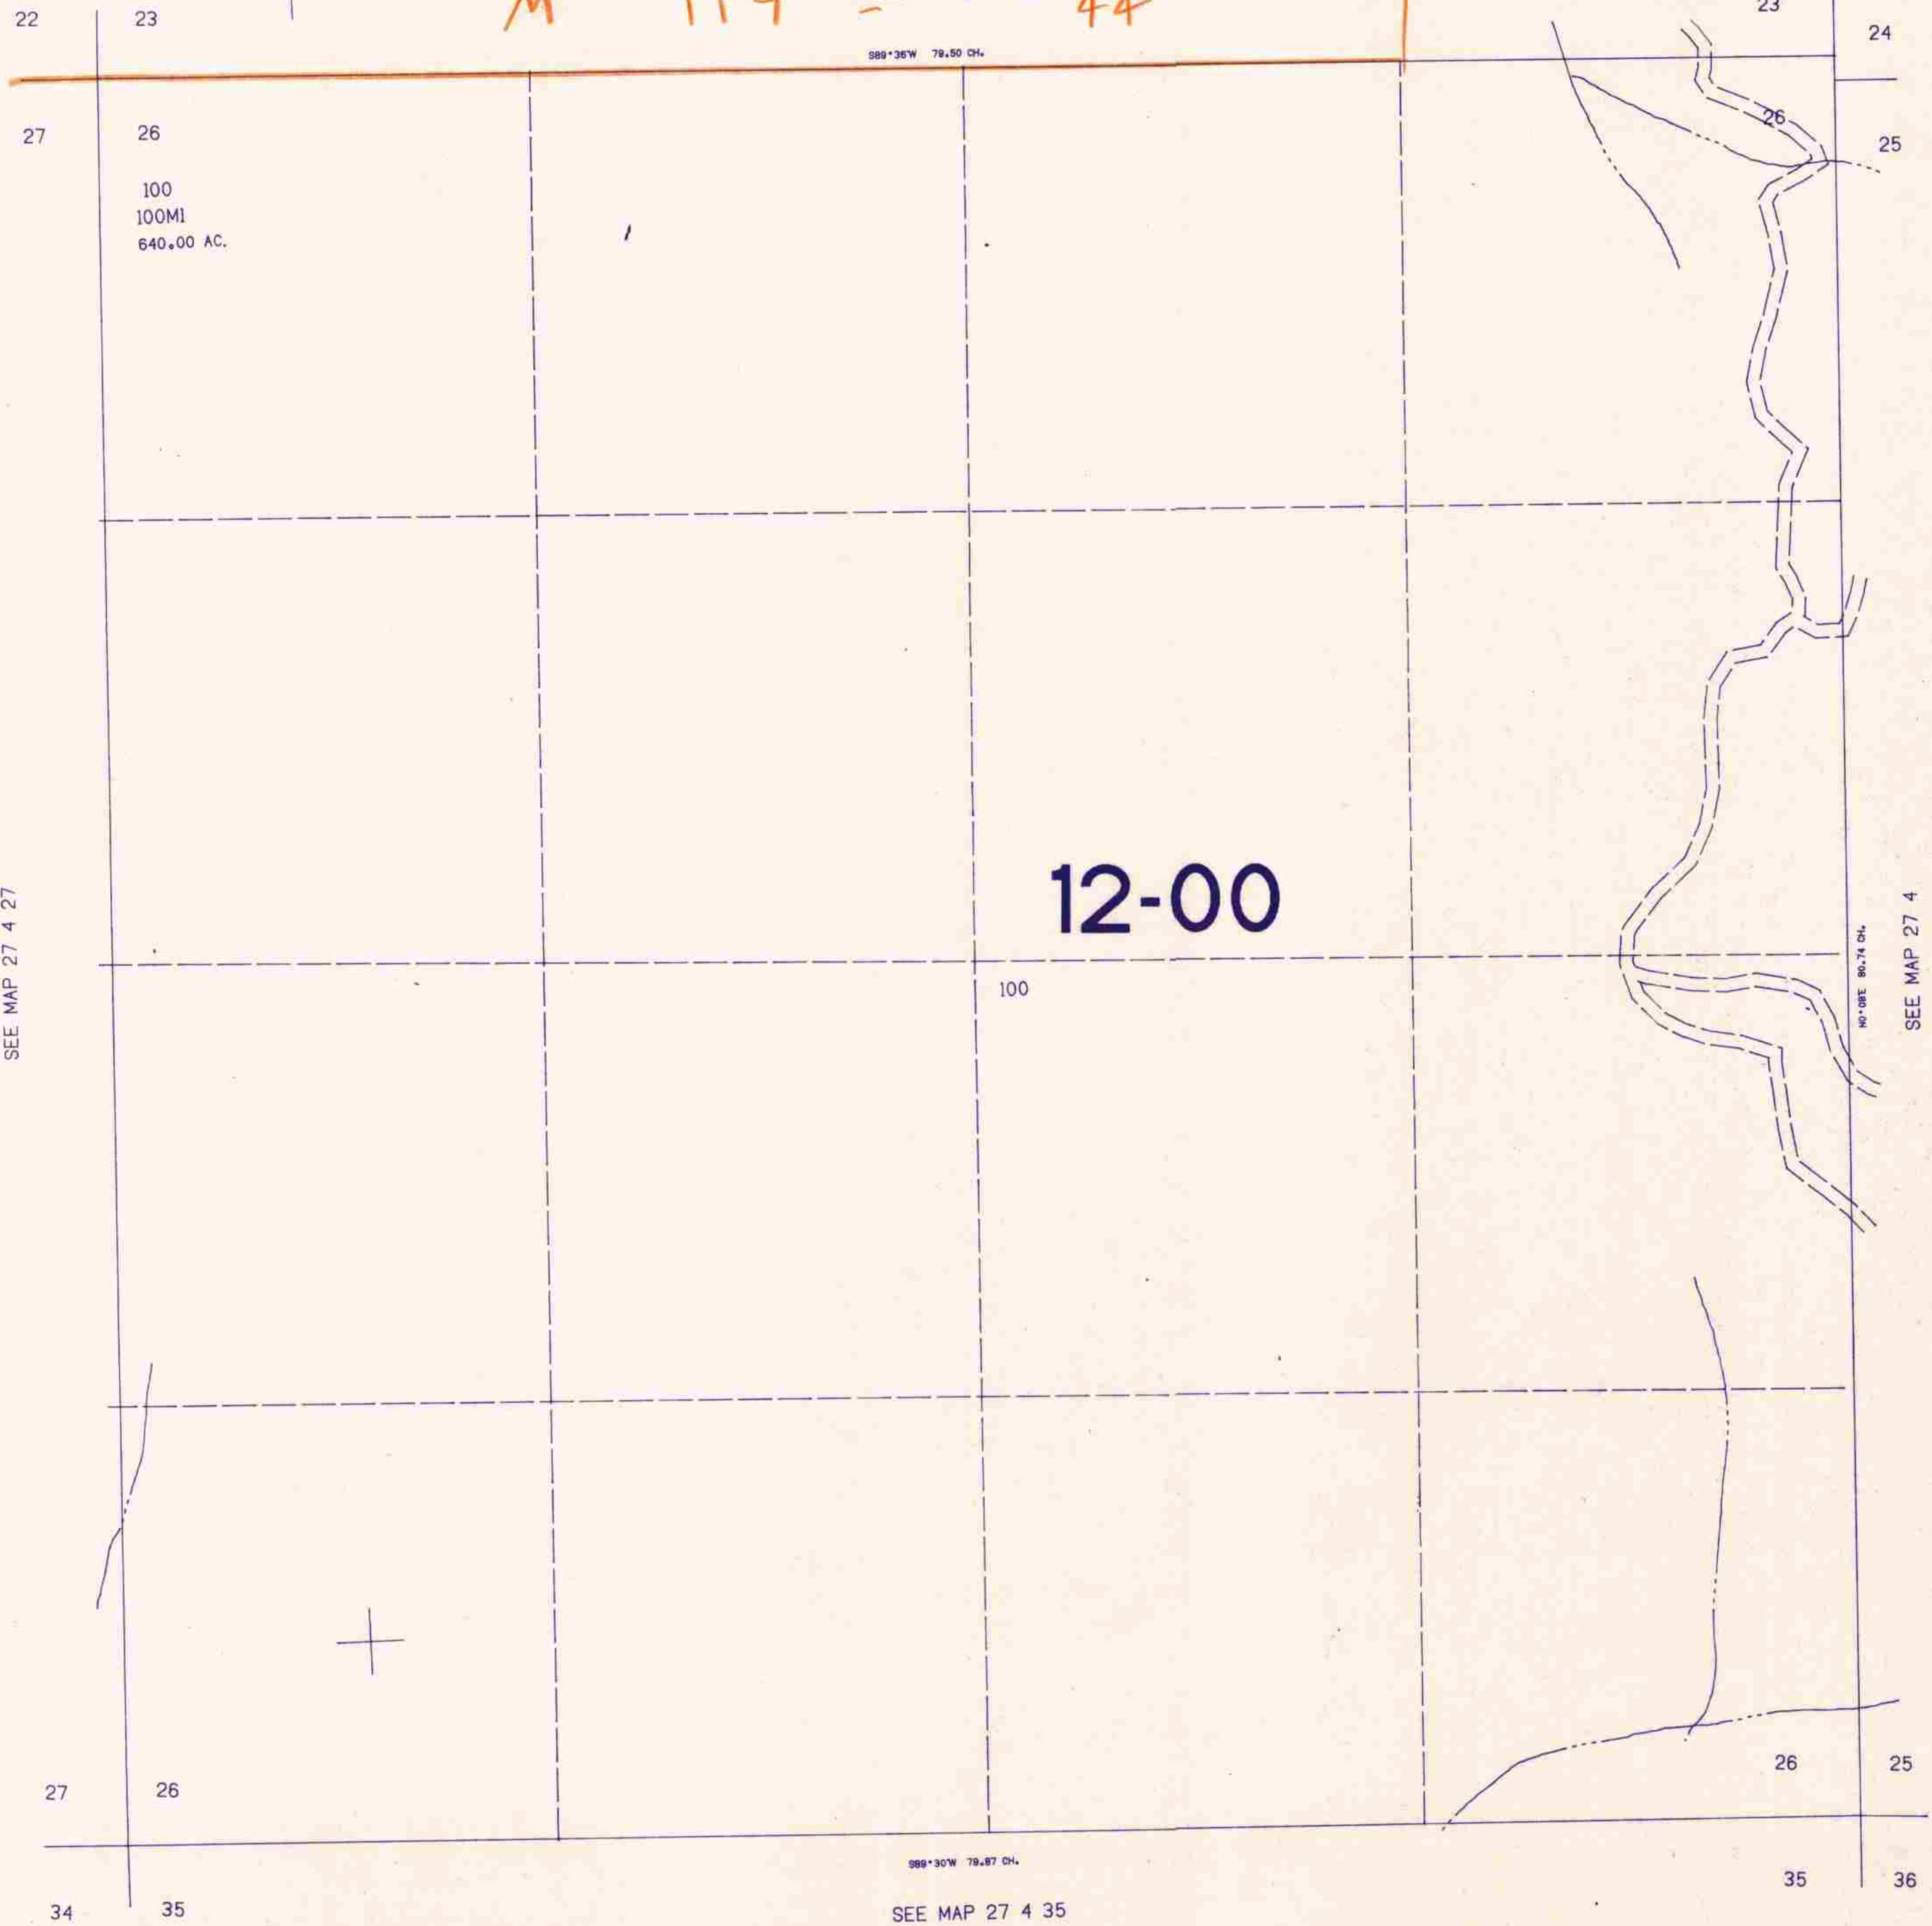

SEE MAP 27 4 27

SEE MAP 27 4 23

SEE MAP 27 4

SEE MAP 27 4 35

565.000

1.295.000

27 4 26

6/25/27