THIS MAP WAS PREPARED FOR ASSESSMENT PURPOSE ONLY.

SEC.31 T.27S. R.4W. W.M.
DOUGLAS COUNTY

1" = 400'

REVISED ON 8-11-22

27 4 31

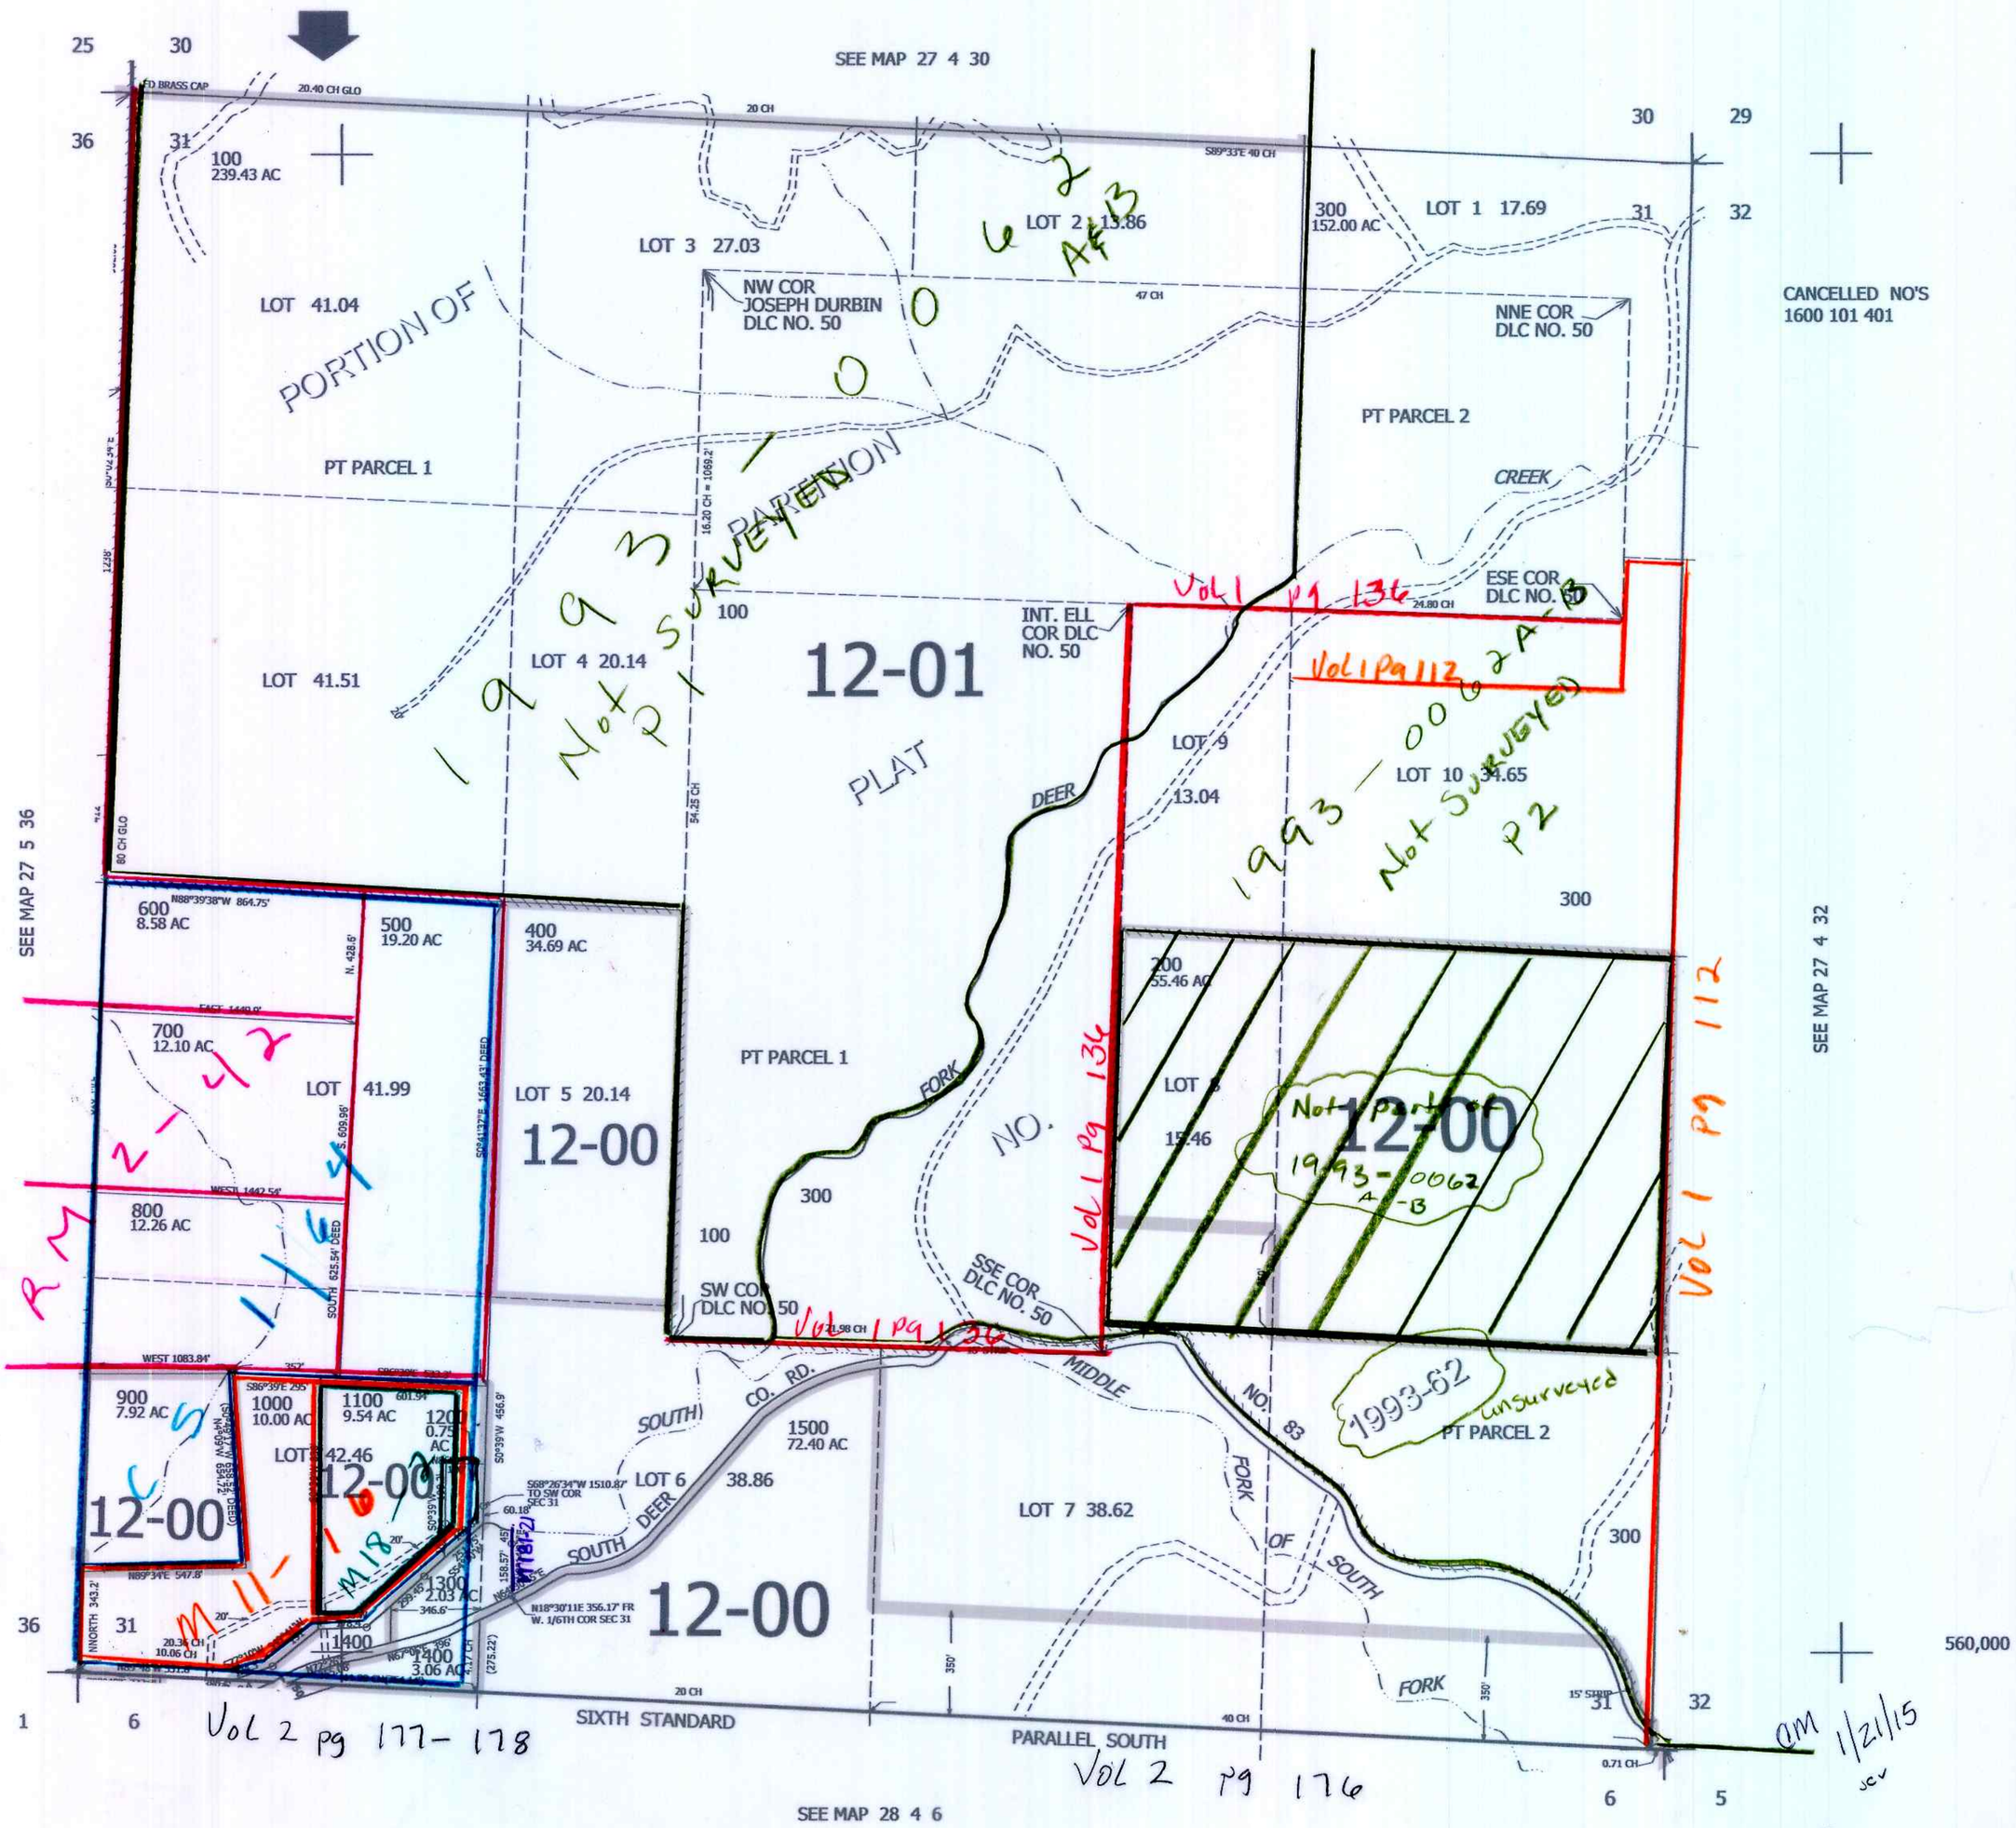

27 4 31