

M137-59A&B

SEE MAP 2705W04

M137-59A&B

VOL ONLY 2  
PT 2024-0034 A-C  
PT P2  
PT P3  
PT 2024-0012 A/B  
PT P2  
UNSURVEYED

THIS LINE SUITS

2025-8  
2025-12  
VOL 2 Pg 118

12-00

M17-29  
A&B  
CS 4/154 1 and 2

12-01

M63


4-02

M69  
GATEWAY RD

54

M137  
CS19/20

M35  
59A&B

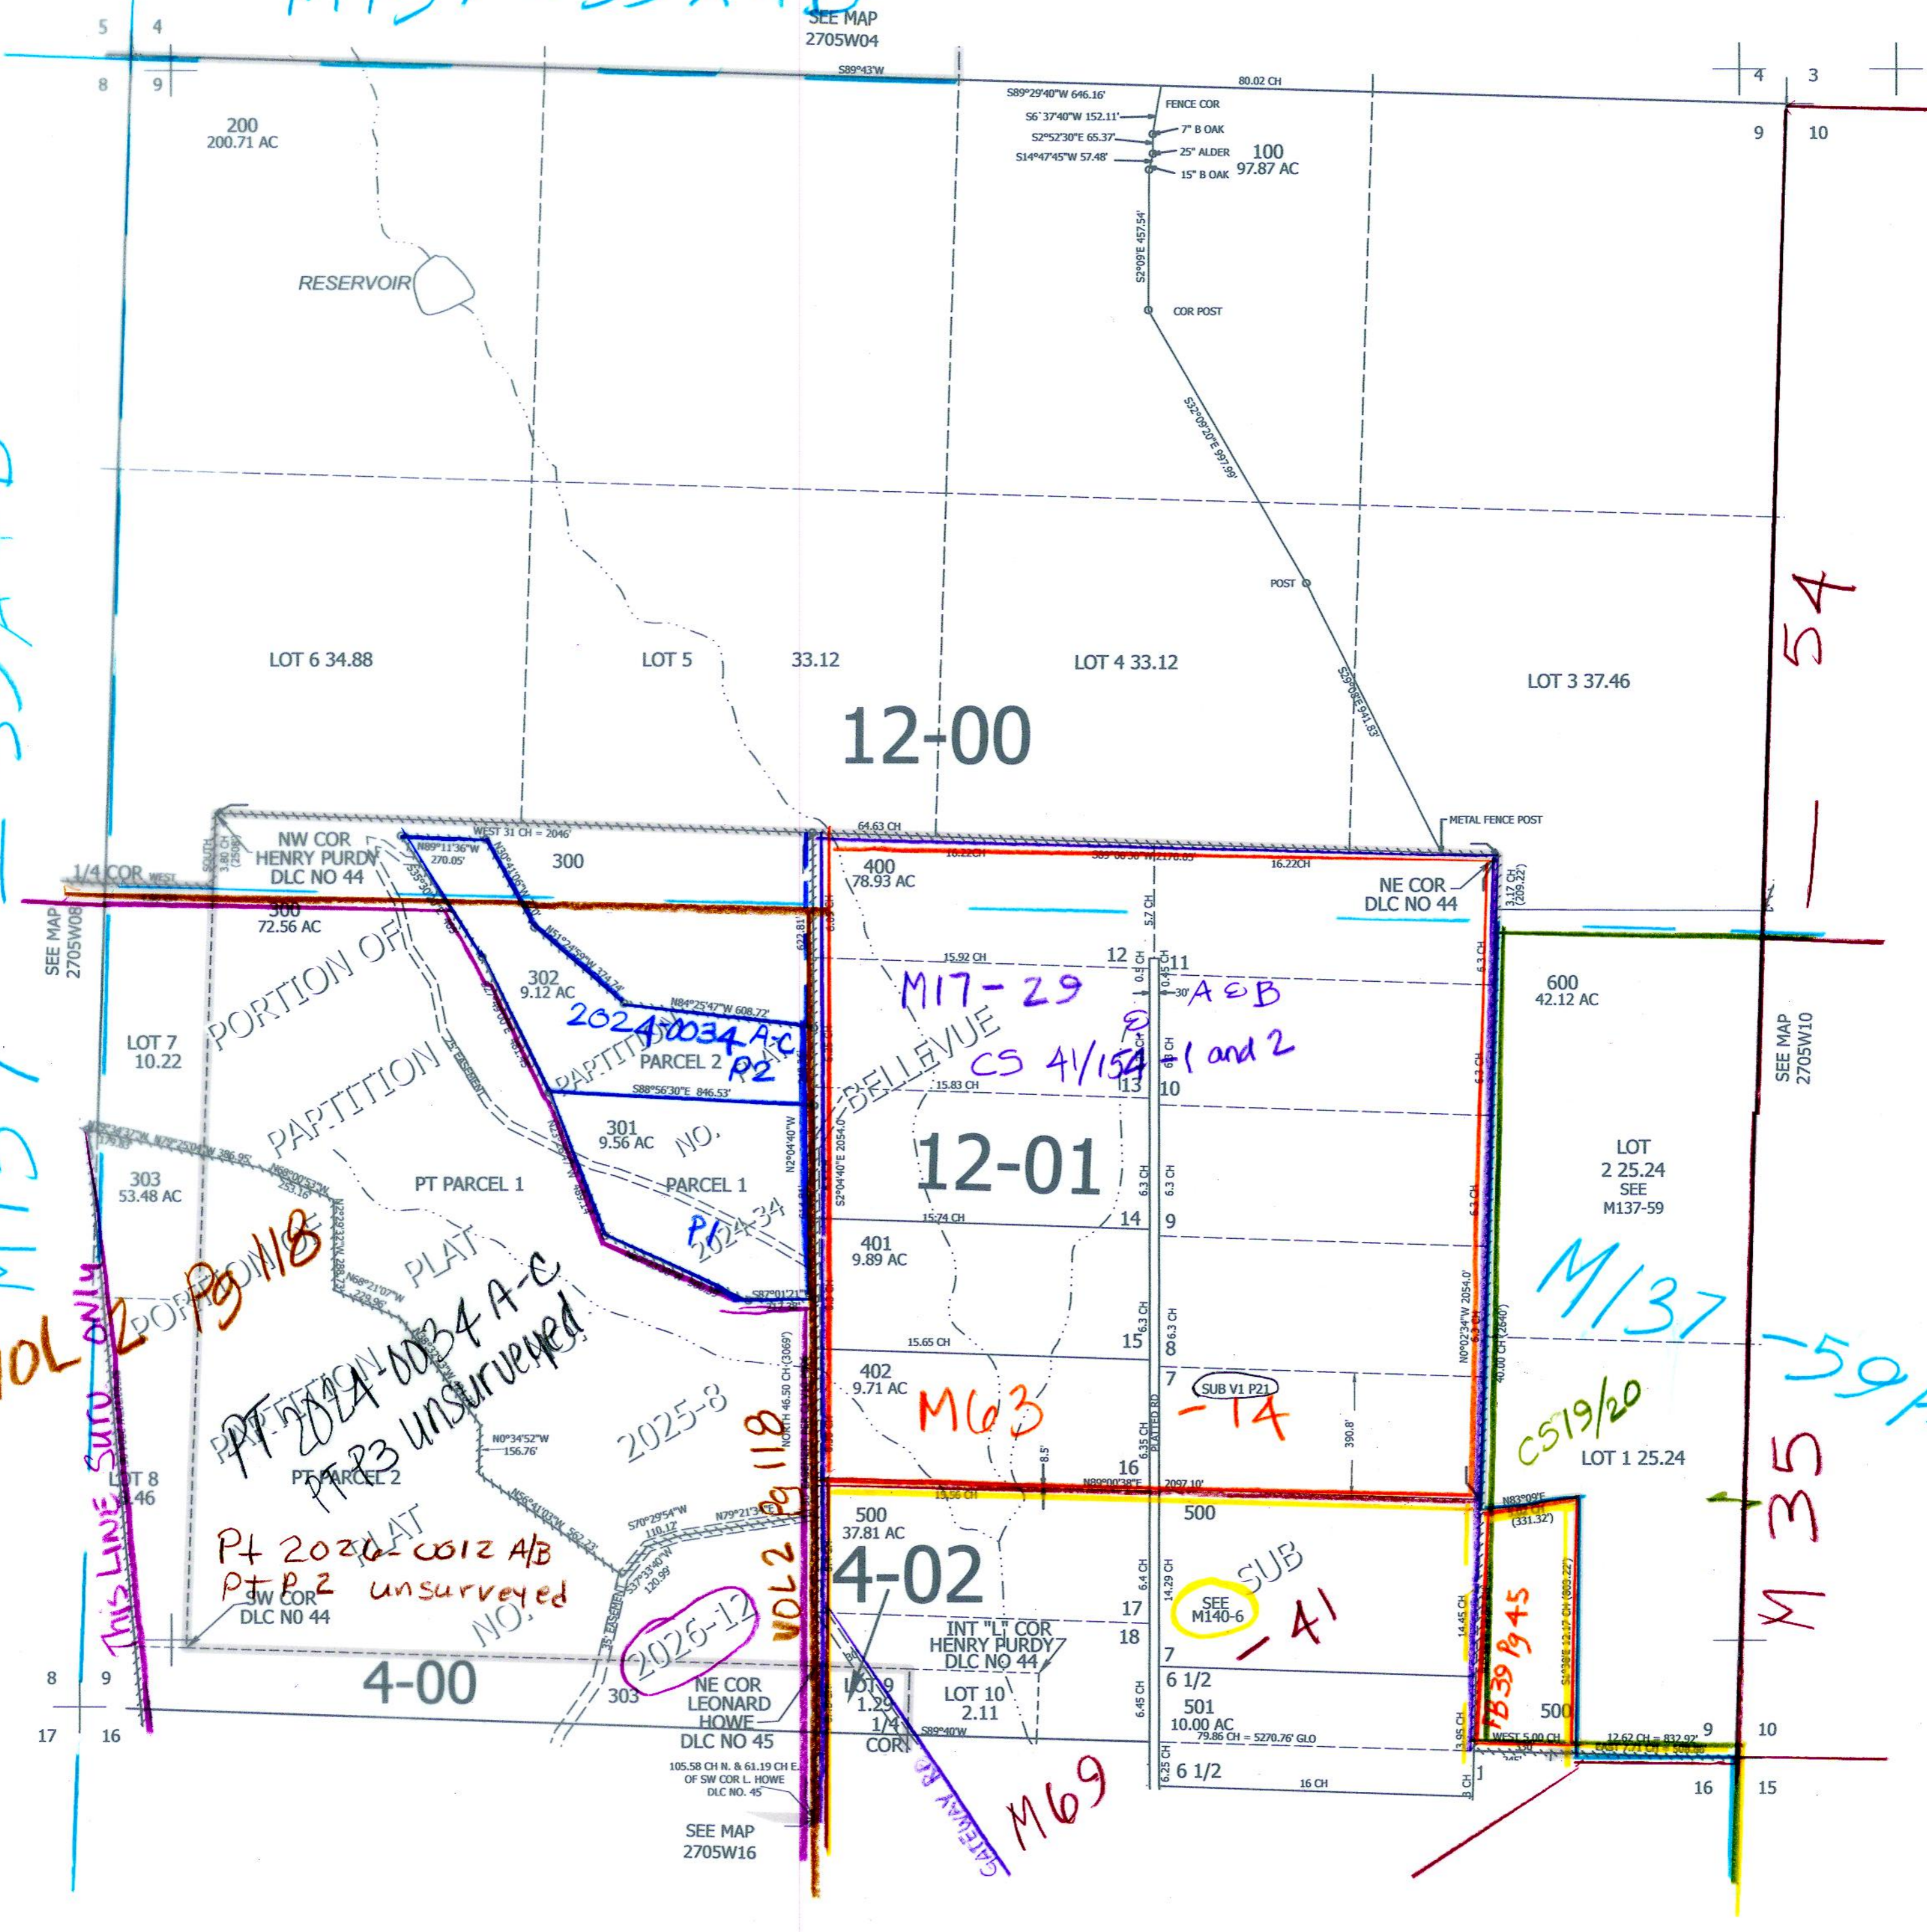

1-2025  
xev  
270509