THIS MAP WAS PREPARED FOR ASSESSMENT PURPOSE ONLY.

SEC.10 T.27S. R.5W. W.M.
DOUGLAS COUNTY

1" = 400'

REVISED ON 3-18-19

27 5 10

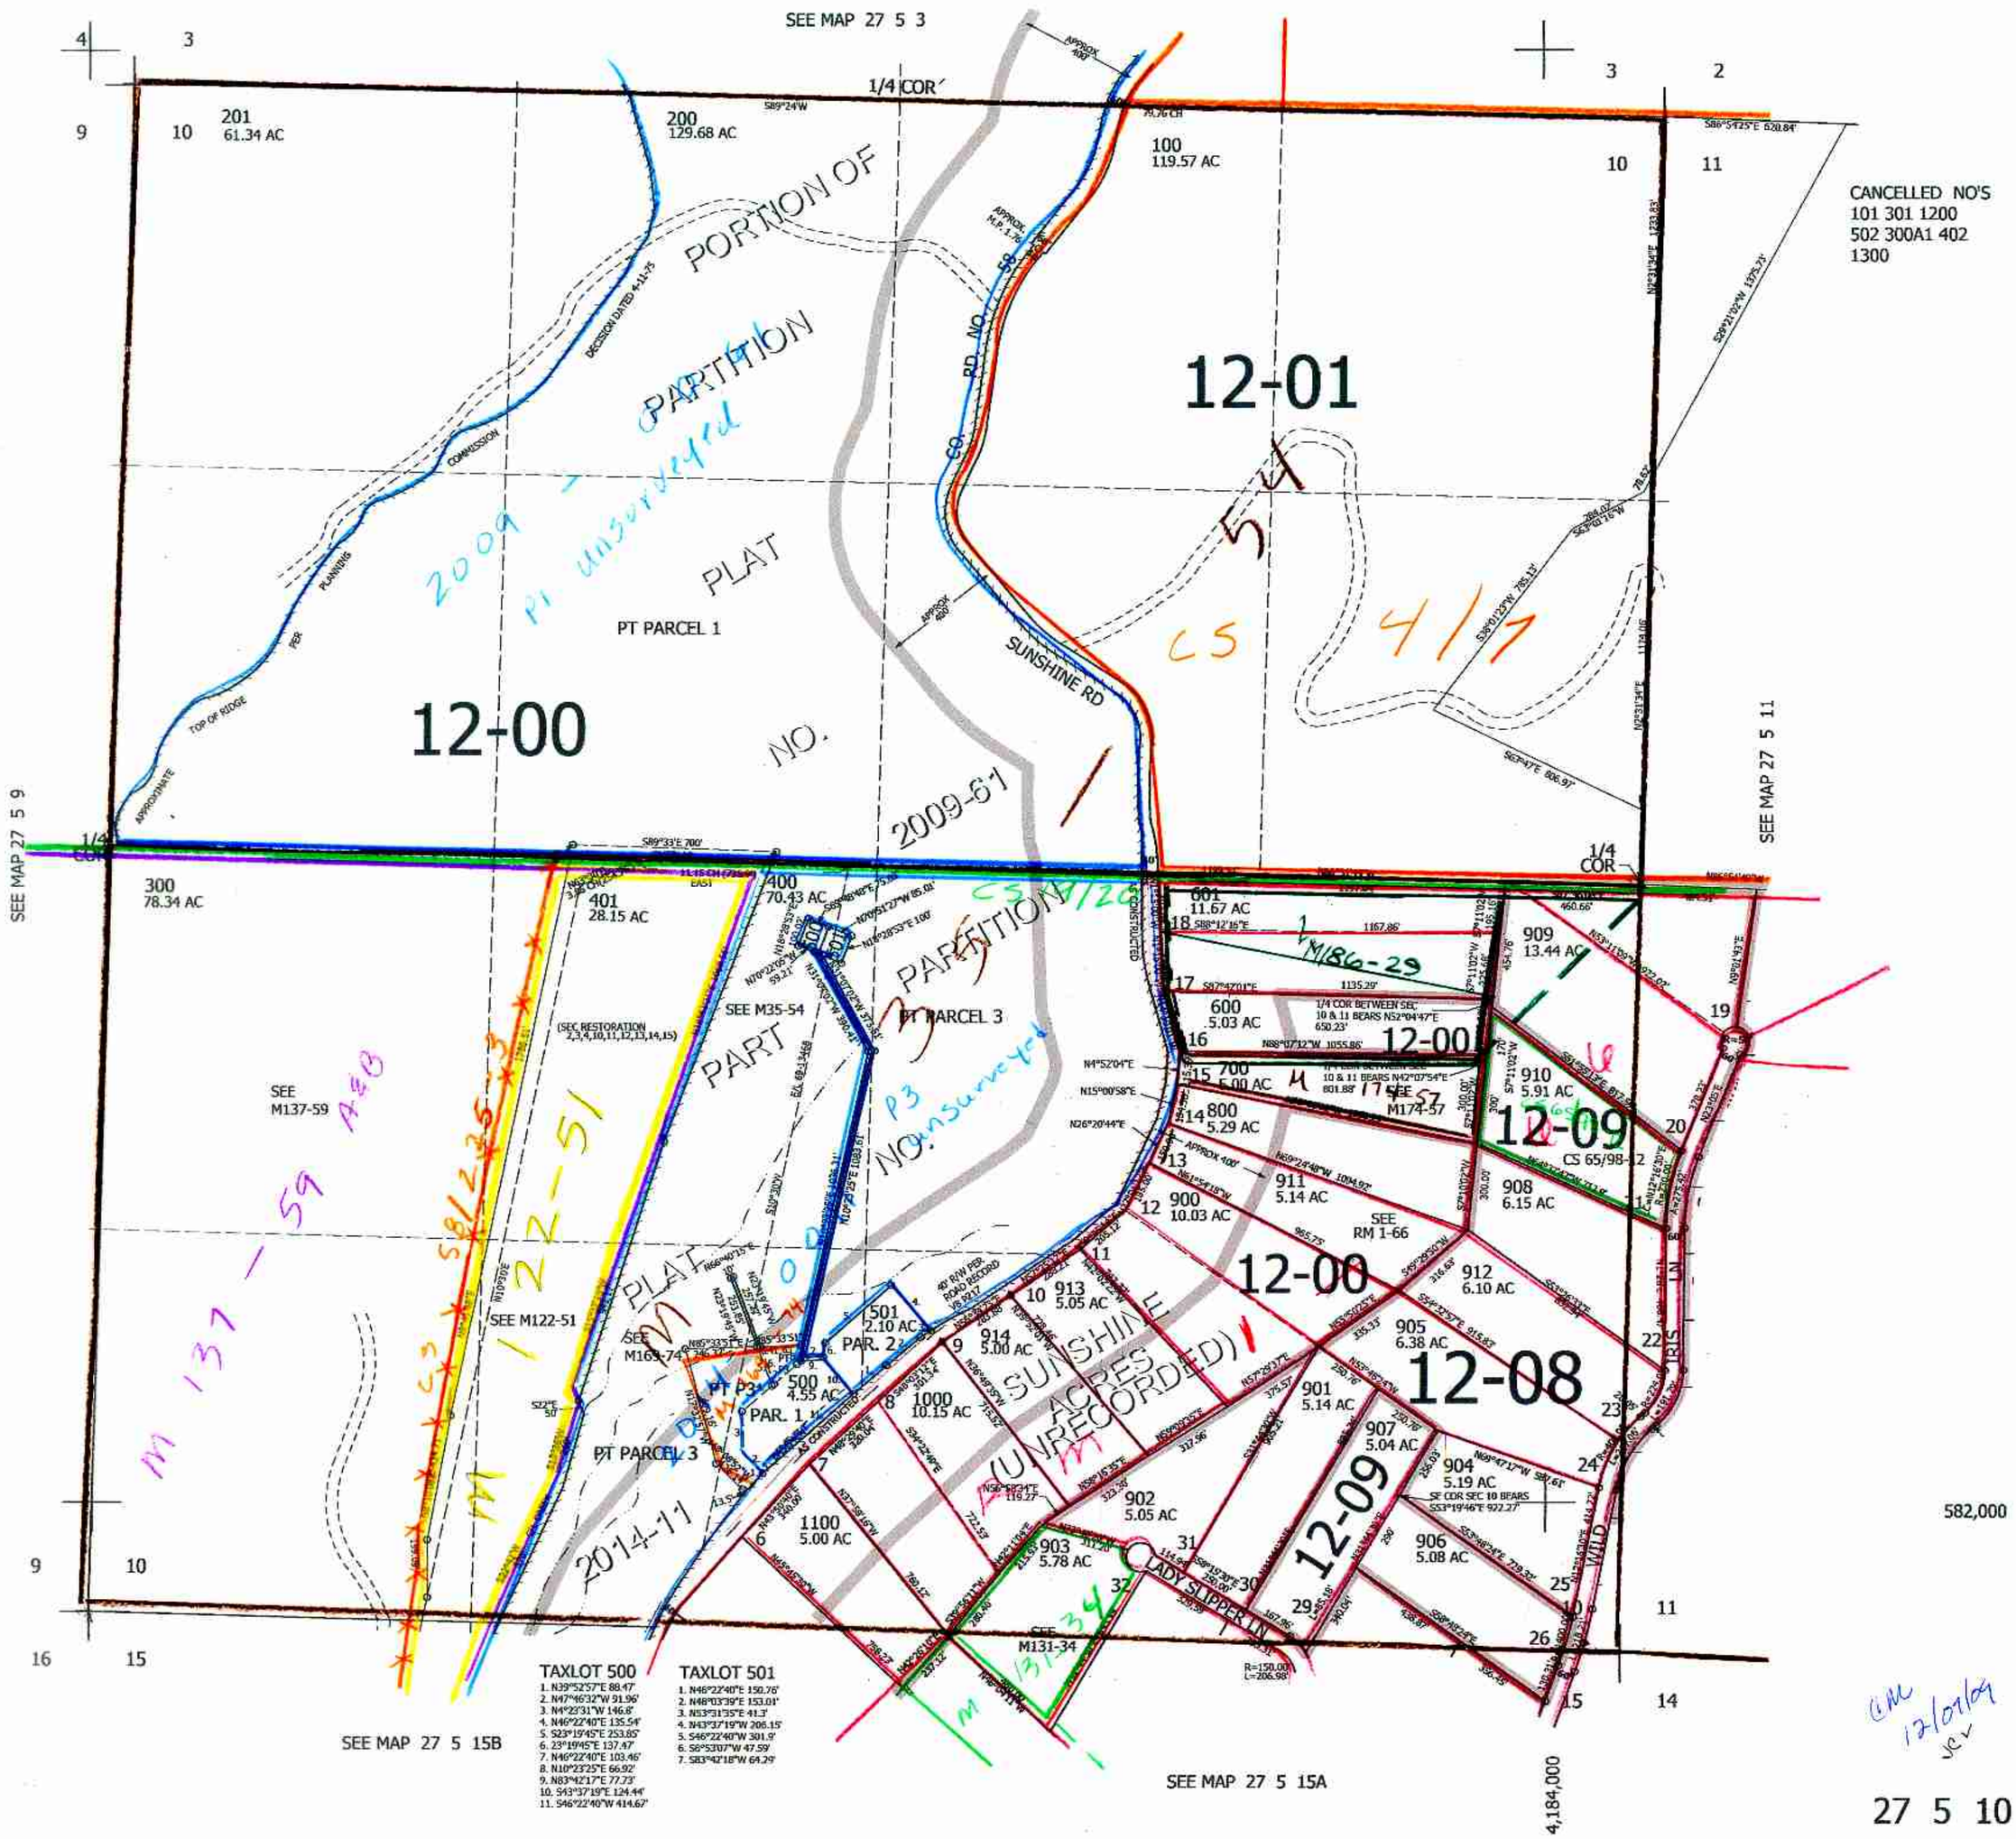

CM 12/07/09 JCV

27 5 10